

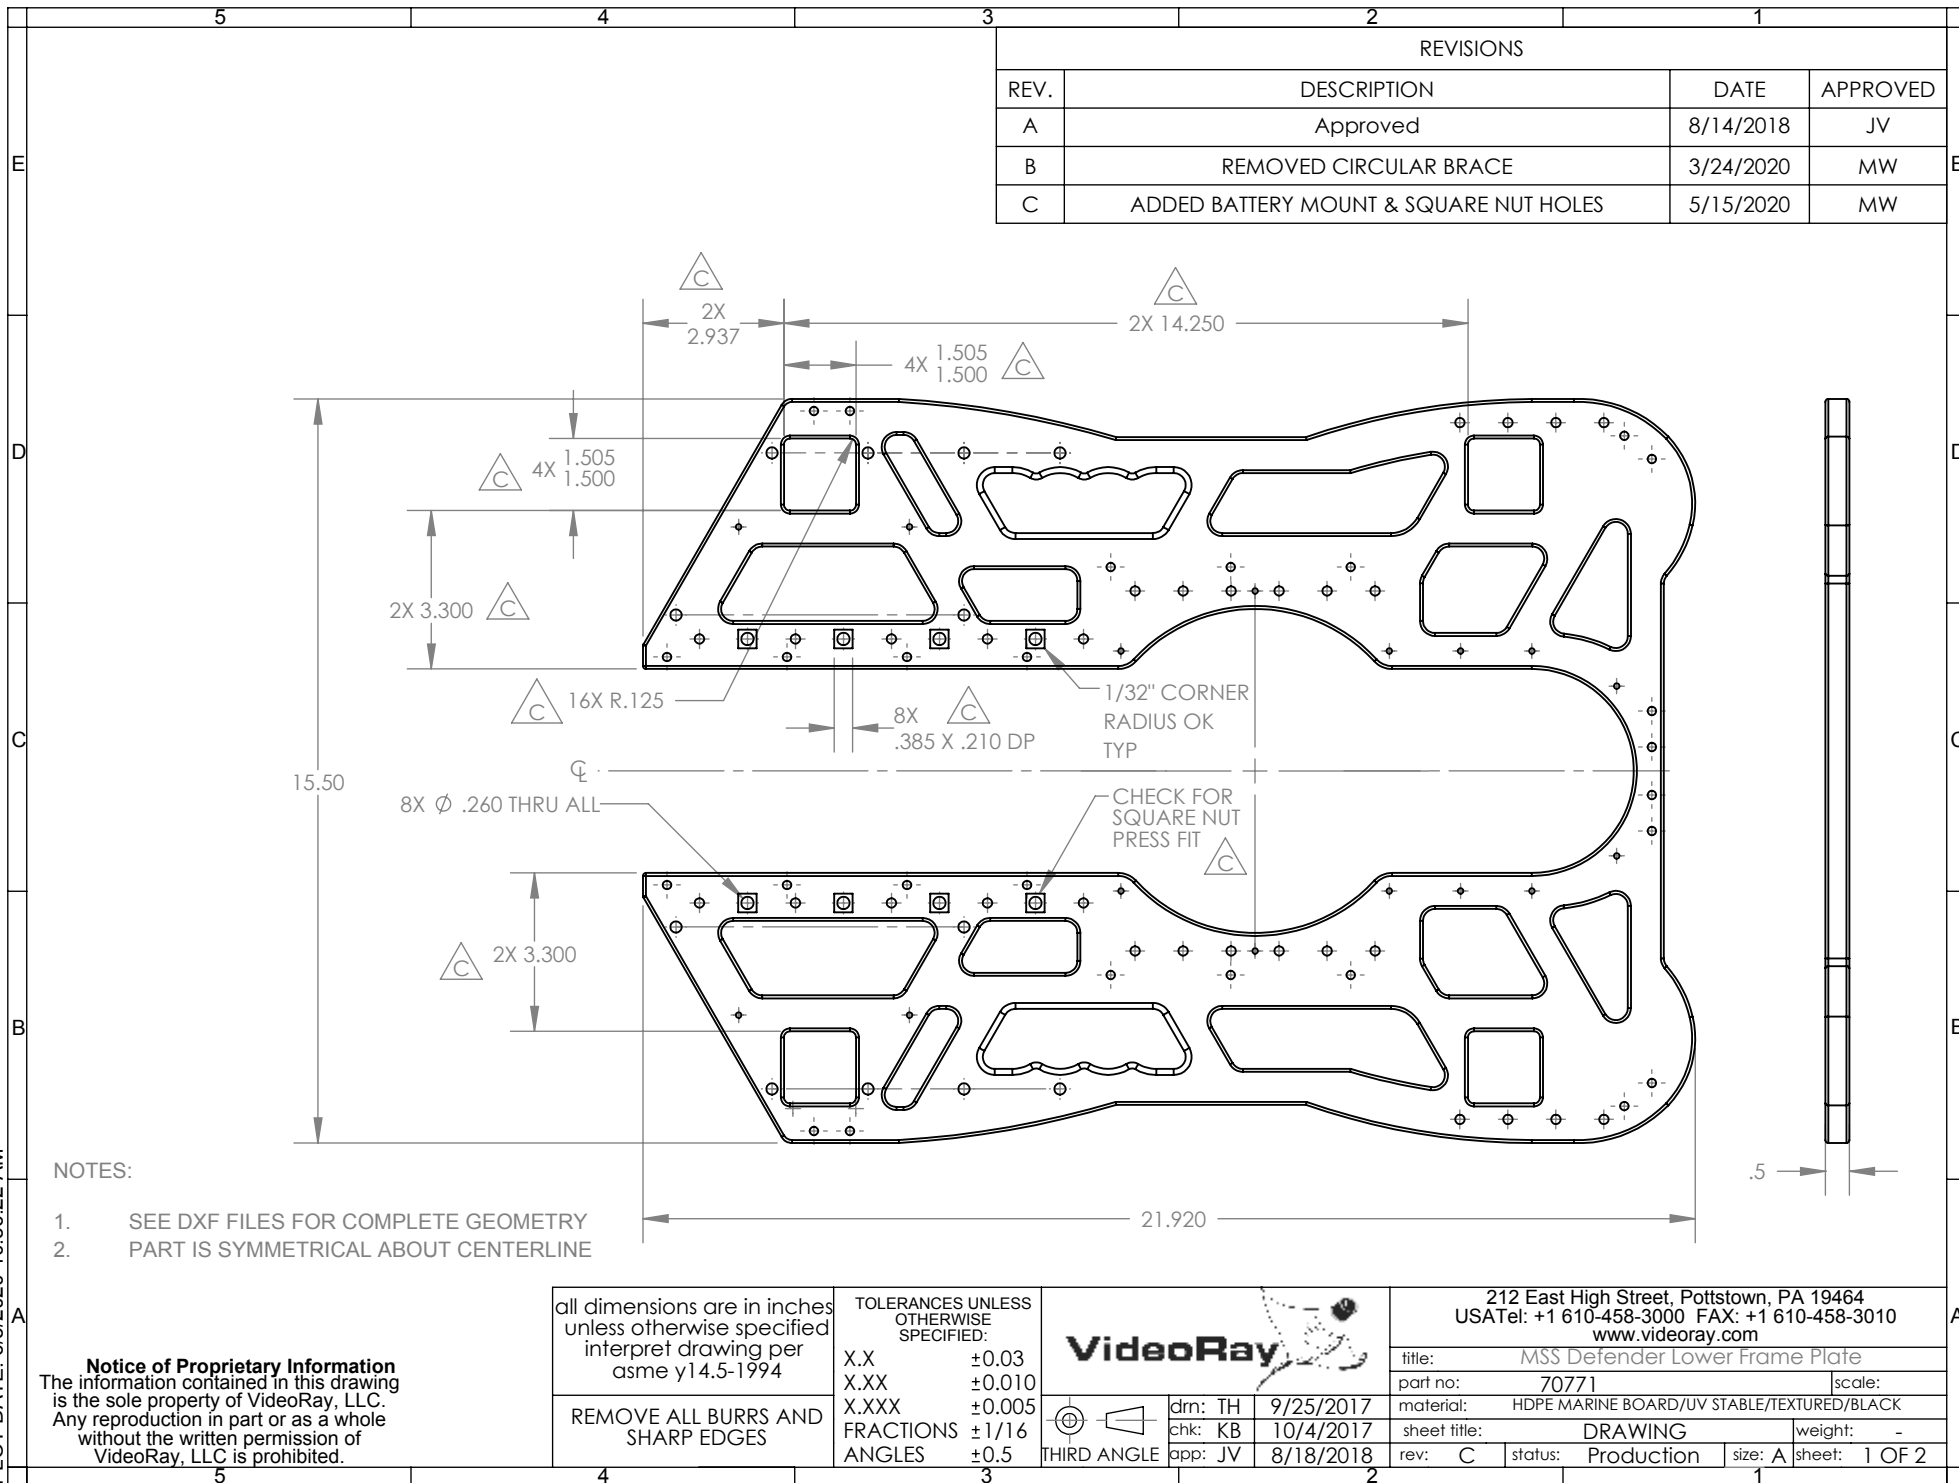


PLOT DATE: 6/3/2020 10:56:22 AM

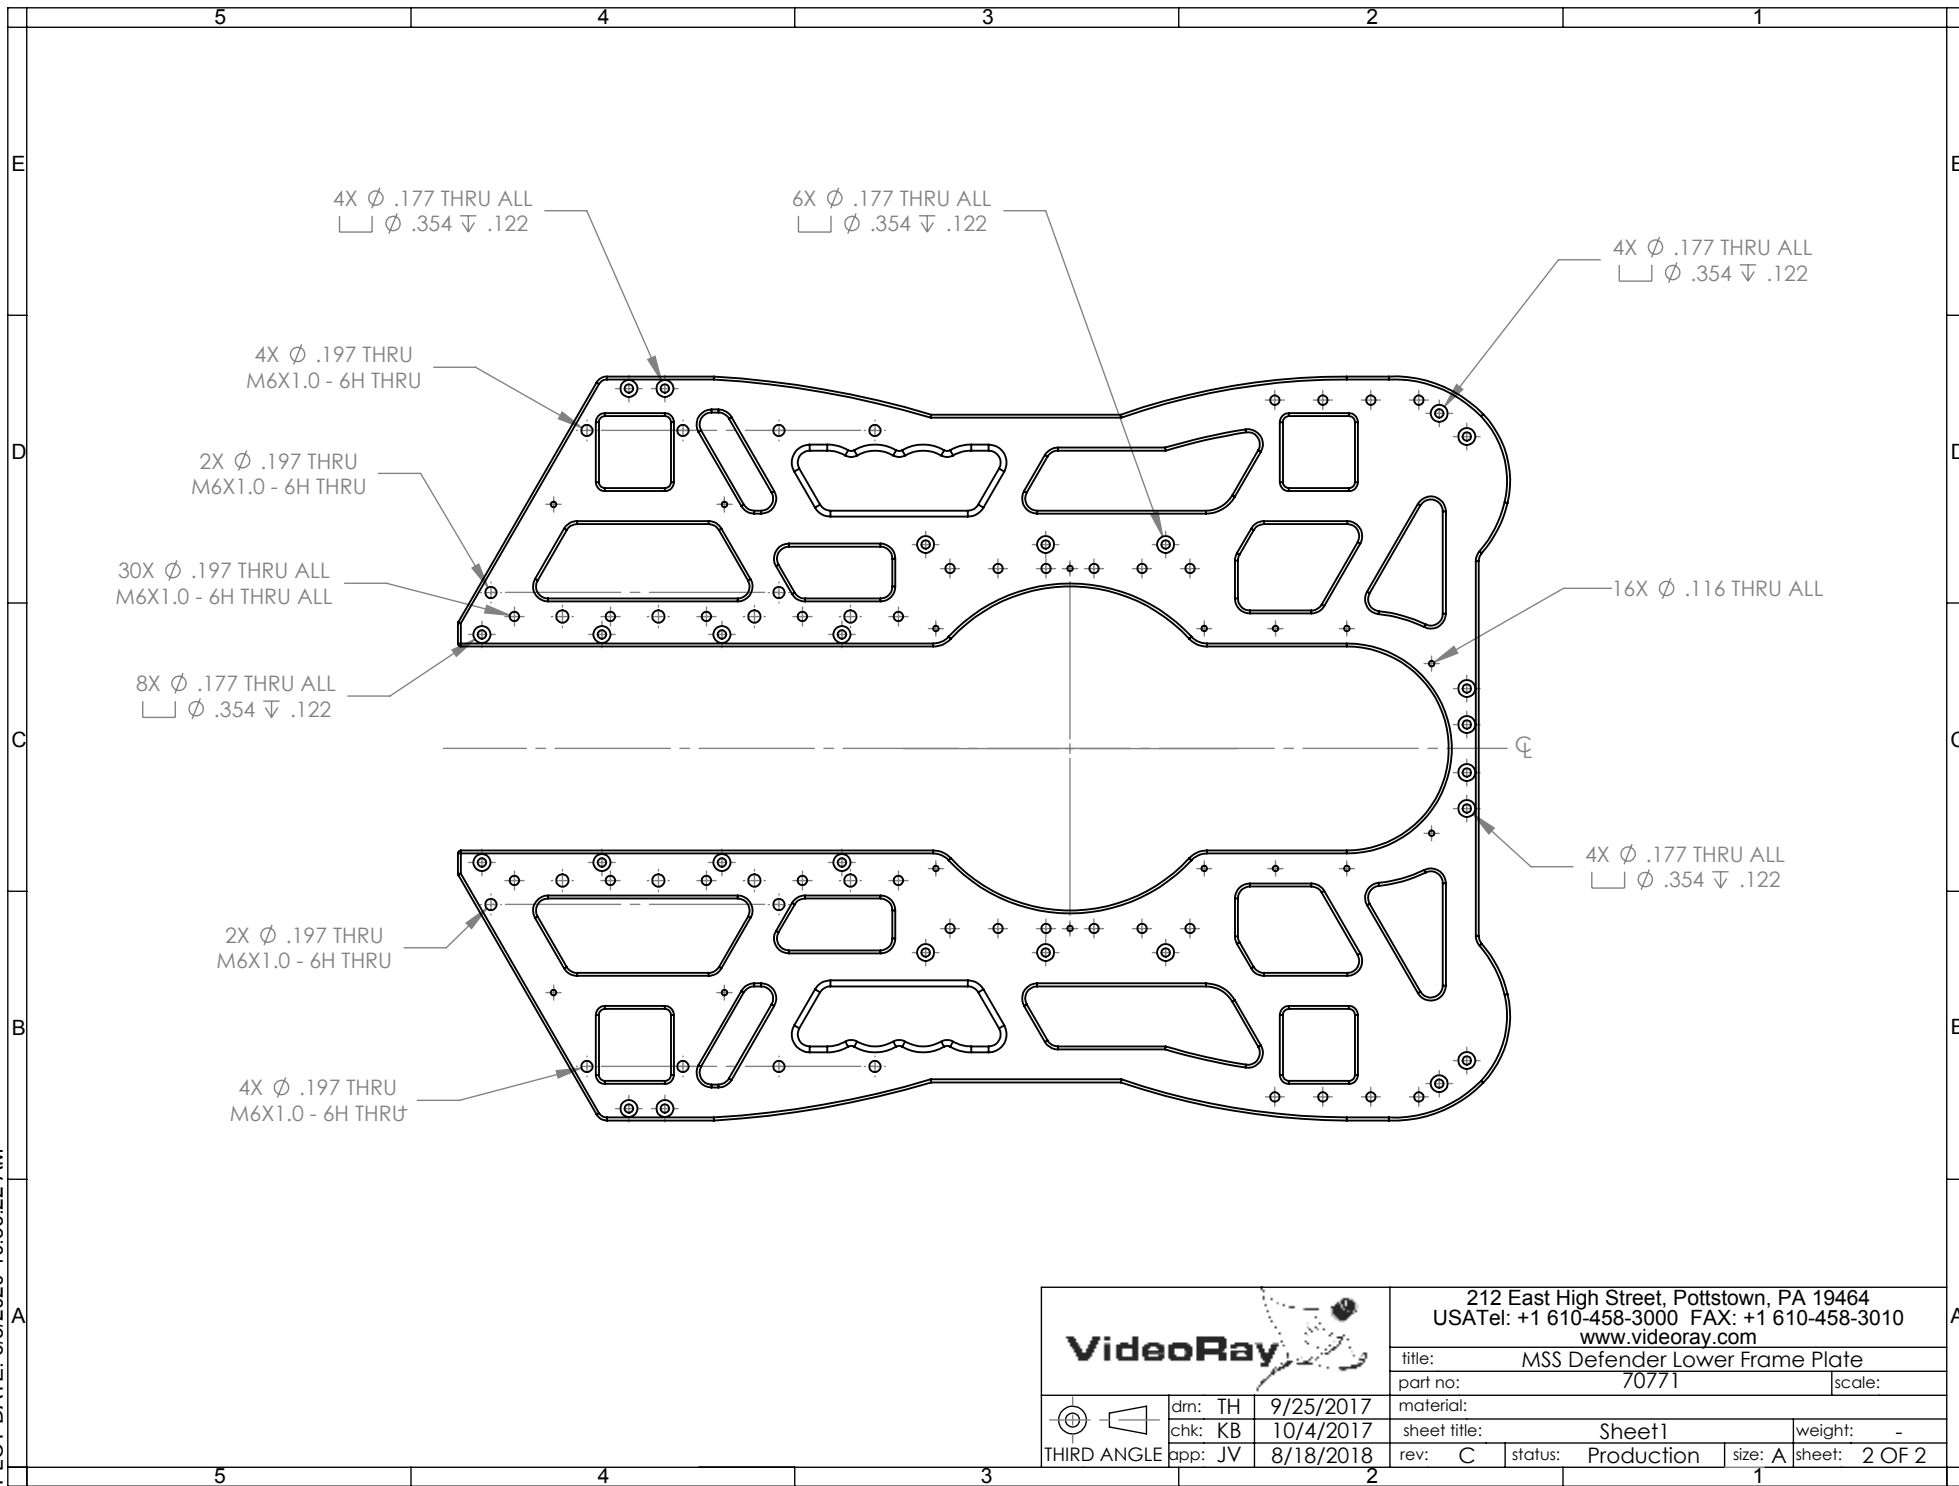

PLOT DATE: 6/3/2020 10:56:22 AM

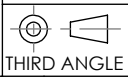

		212 East High Street, Pottstown, PA 19464 USATel: +1 610-458-3000 FAX: +1 610-458-3010 www.videoray.com			
		title: MSS Defender Lower Frame Plate			
 THIRD ANGLE	dm: TH	9/25/2017	material:		
	chk: KB	10/4/2017	sheet title:	Sheet1	weight: -
	app: JV	8/18/2018	rev: C	status: Production	size: A sheet: 2 OF 2
			part no: 70771	scale:	