DRAWING No. C 422322 | ISSUE 02

THE COPYRIGHT OWNER GENERAL INFORMATION. ALL RIGHTS RESERVED COPYRIGHT. GENERAL INFORMATION, THIS DOCUMENT AND ANY PART THEREOF MAY BE USED BY C.R.P. GROUP LTD. IN LINE OF BUSINESS OR TO BE THE SUBJECT OF NEGOTIATION PROVIDED BY C.R.P. GROUP LTD. COPYRIGHT 2003 C.R.P. GROUP LIMITED. ALL RIGHTS RESERVED

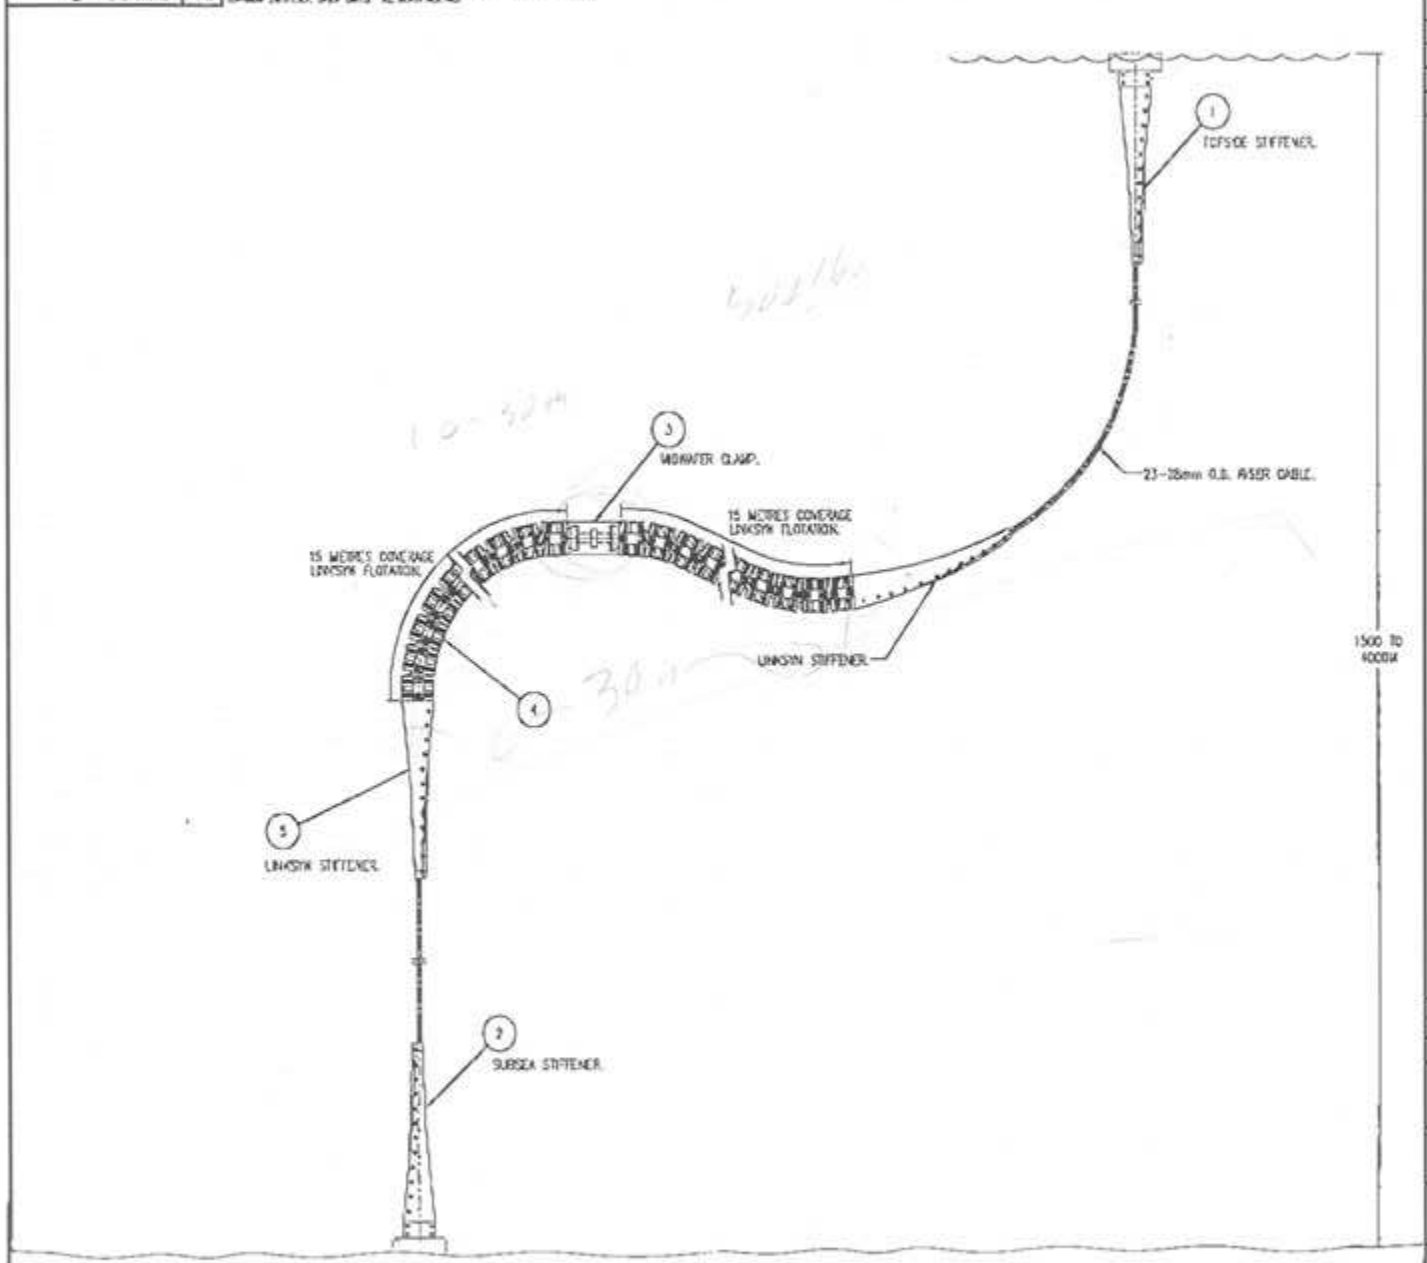

ITEM	QTY	DESCRIPTION	MATERIAL
1	1	TOPSIDE STIFFENER.	POLYURETHANE.
2	1	SUBSEA STIFFENER.	POLYURETHANE.
3	1	MIDWATER CLAMP.	STAINLESS STEEL/ NYLON.
4	120	LINKSYN ELEMENTS.	SYNTACTIC FOAM.
5	2	LINKSYN STIFFENER.	POLYURETHANE.

NOTES:

1. ALL DIMENSIONS ARE IN MILLIMETRES UNLESS NOTED OTHERWISE.
2. THE NOMINAL NETT BUOYANCY OF THE SYSTEM IS 225 kg.
3. THE NOMINAL WEIGHT IN AIR OF THE SYSTEM IS 1010 kg.
4. THE MAXIMUM OPERATING DEPTH OF THE SYSTEM IS 4000 MSW.
5. THE MINIMUM BEND RADIUS OF THE SYSTEM IS 1.0 METRES.

No.	DATE	REVISION	DRAWN	CHK'D	APPR'D
C1	22/10/03	DRAWING GENERALLY UPDATED.			
B1	11/10/03	FIRST ISSUE.	LSD	MDC	MDC

CRP GROUP LIMITED
STANLEY WAY, STANLEY, SHELMERSDALE, LANCASHIRE, WN6 8DA, ENGLAND.
U.K. TELEPHONE : 01695 712000
U.K. FACSIMILE : 01695 712111

CLIENT: MONTEREY BAY AQUARIUM RESEARCH INSTITUTE

PROJECT: MOOS MOORING SYSTEM

TITLE: RISER CABLE BUOYANCY & BEND RELIEF SYSTEM GENERAL ARRANGEMENT

SCALE 1:15	DRAWN BY LSD	SHEET SIZE A1	PROJECTION
PROJECT No. QN11550	DRAWING No. C 422322		ISSUE 02

CAD GENERATED DRAWING, DO NOT ALTER MANUALLY