THE INFORMATION CONTAINED IN THIS DRAWING IS THE SOLE PROPERTY OF MBARI ANY REPRODUCTION IN PART OR WHOLE WITHOUT THE WRITTEN PERMISSION OF MBARI IS PROHIBITED.

REVISIONS			
REV.	DESCRIPTION	DATE	APPROVED
	INITIAL RELEASE	XX/XX/98	

Deployed At: 36.8203 N 122.2859 W

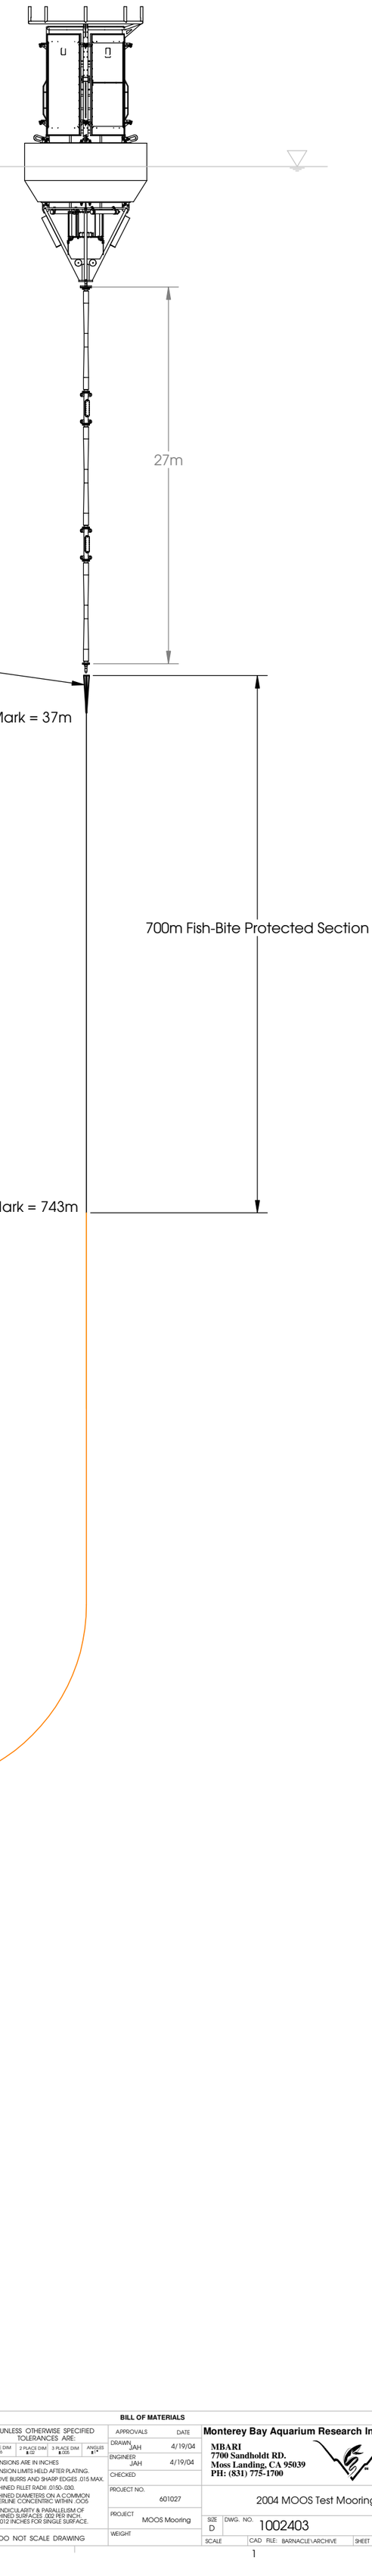

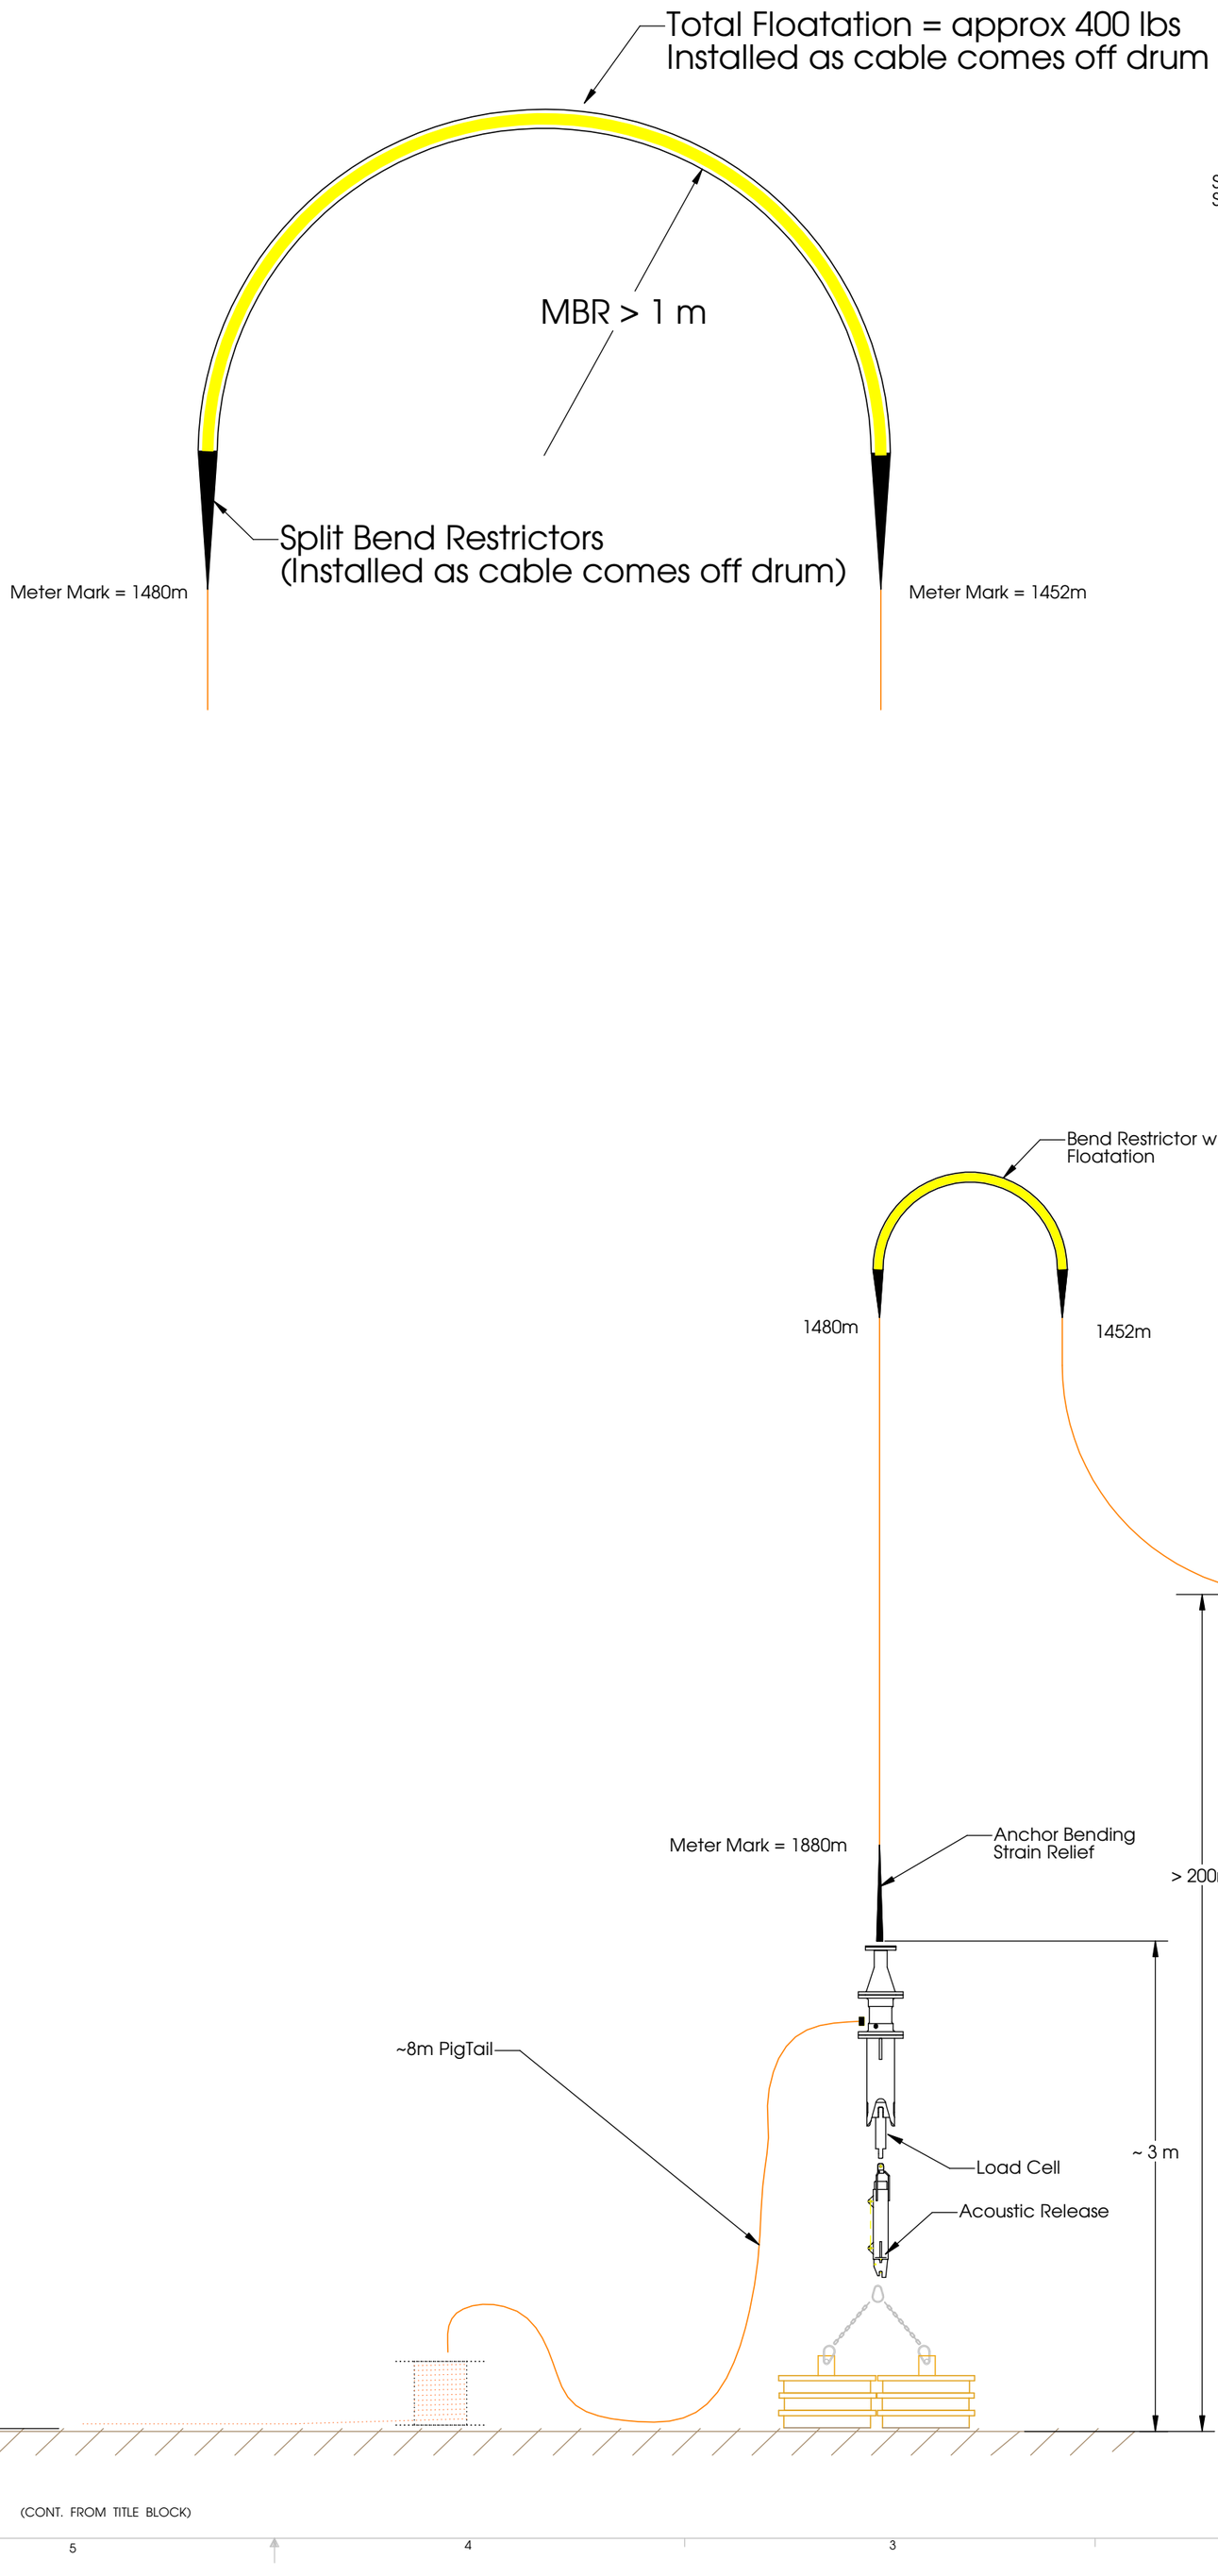

NOTES: (CONT. FROM TITLE BLOCK)

BILL OF MATERIALS

Shop / Q.C.		UNLESS OTHERWISE SPECIFIED TOLERANCES ARE:		APPROVALS	DATE
Inspector		1 PLACE DIM ±1/16	2 PLACE DIM ±.02	3 PLACE DIM ±.005	ANGLES ±1°	DRAWN JAH	4/19/04
Shop Foreman		1. DIMENSIONS ARE IN INCHES				ENGINEER JAH	4/19/04
Engineer		2. DIMENSION LIMITS HELD AFTER PLATING.				CHECKED	
		3. REMOVE BURRS AND SHARP EDGES .015 MAX.				PROJECT NO.	601027
NEXT ASSY Description	NEXT ASSY Number	4. MACHINED FILLET RADII .0150-.030.				PROJECT	MOOS Mooring
		5. MACHINED DIAMETERS ON A COMMON CENTERLINE CONCENTRIC WITHIN .005				WEIGHT	
APPLICATION		6. PERPENDICULARITY & PARALLELISM OF MACHINED SURFACES .002 PER INCH, MAX .012 INCHES FOR SINGLE SURFACE.		DO NOT SCALE DRAWING			

Monterey Bay Aquarium Research Institute
MBARI
7700 Sandholdt RD.
Moss Landing, CA 95039
PH: (831) 775-1700

2004 MOOS Test Mooring

SIZE	DWG. NO.	REV.
D	1002403	

SCALE | CAD FILE: BARNACLE\ARCHIVE | SHEET 1 OF 1