


REVISION	DESCRIPTION	DATE	APPROVED
A	CD 7627 INITIAL ISSUE		

- NOTES:
- DO NOT SCALE FROM DRAWING.
 - MATERIAL: 8061 T6 ALUMINUM
 - MBARI TO MODIFY PART FOR GLAND SEAL HOUSING AND SCREW CBORES.
 - MBARI TO MARK OR TAG WITH PARTS NUMBER.

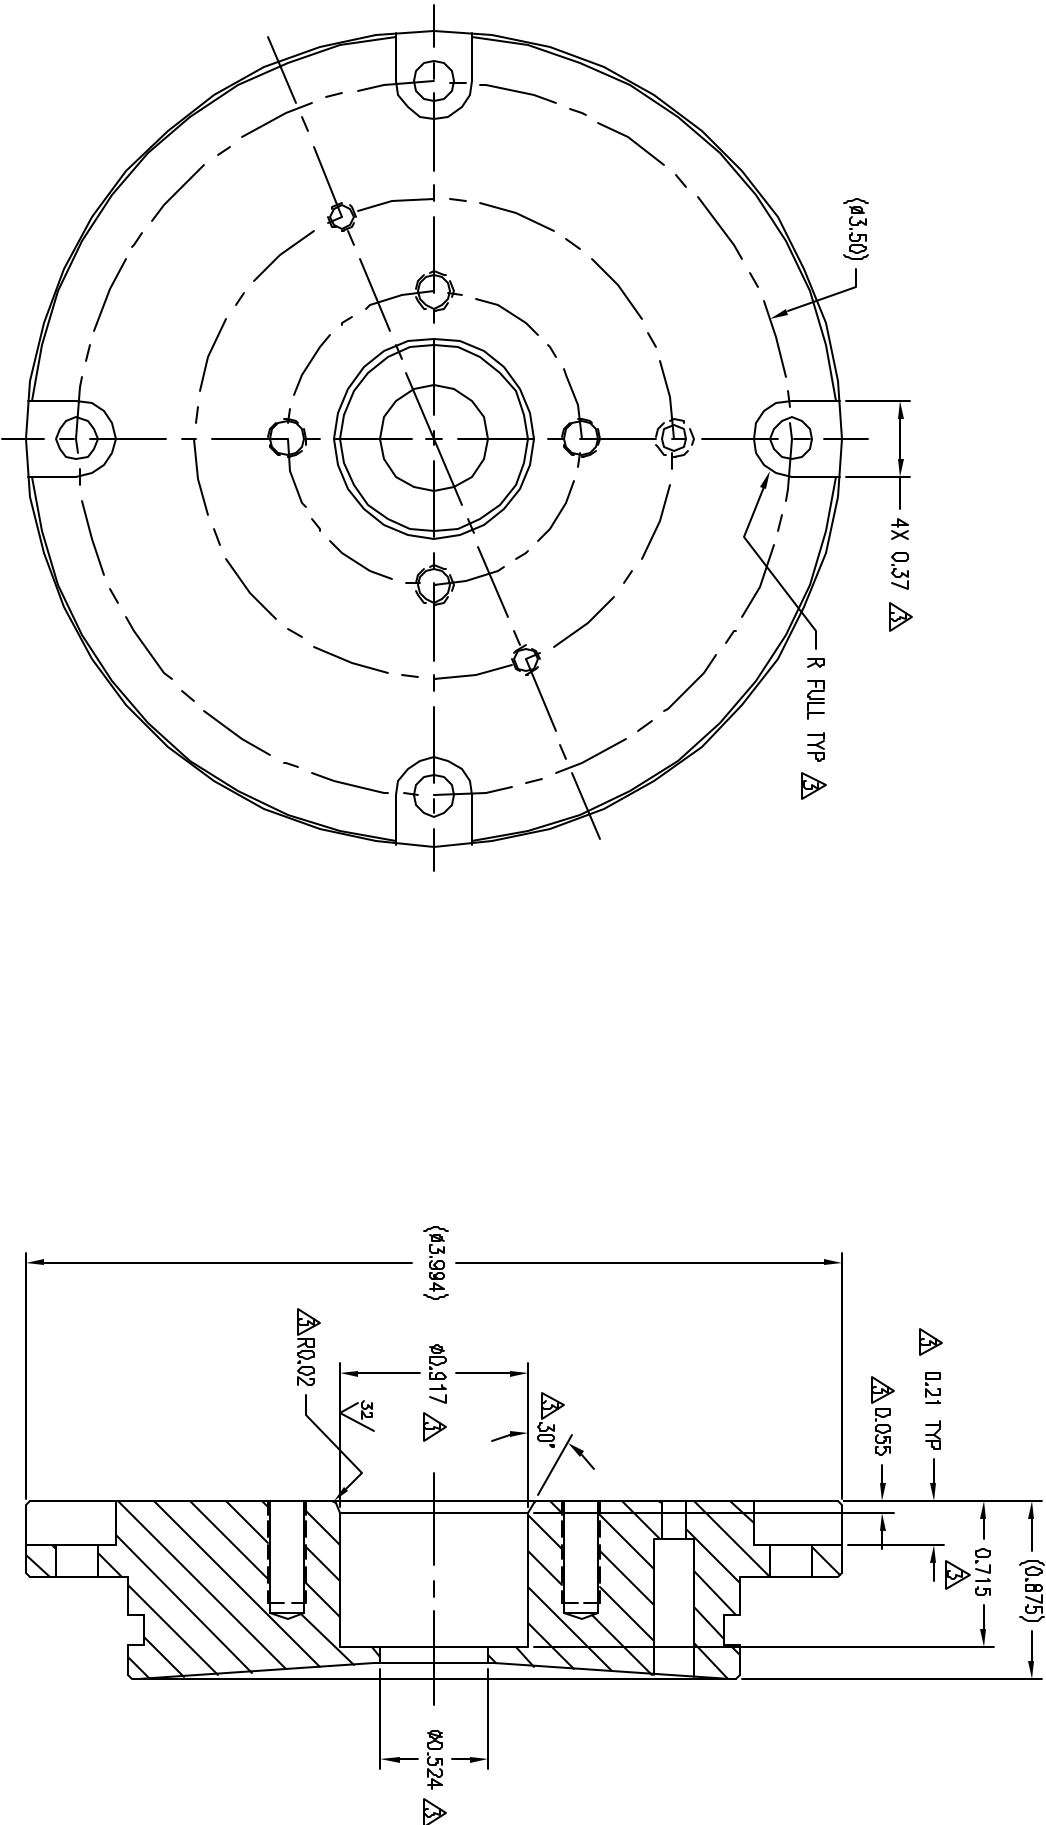

ALL DATA AND INFORMATION CONTAINED OR DISCLOSED BY THIS DOCUMENT IS CONFIDENTIAL AND PROPRIETARY INFORMATION OF OCEAN DESIGN, INC. AND ALL RIGHTS THEREIN ARE EXPRESSLY RESERVED BY ACCEPTING THIS MATERIAL THE REQUIRER AGREES THAT THE INFORMATION IS NOT TO BE REPRODUCED OR USED IN ANY MANNER WITHOUT THE WRITTEN CONSENT OF OCEAN DESIGN, INC. AND WILL NOT BE USED, COPIED, REPRODUCED OR MADE OR IN PART, NOR ITS CONTENTS REVEALED IN ANY MANNER TO OTHERS, EXCEPT TO MEET THE SPECIFIC PURPOSE FOR WHICH IT WAS DELIVERED.			
UNLESS OTHERWISE SPECIFIED DIMENSIONS ARE IN INCHES. TOLERANCES ARE: FRACTIONS ± 1/2" DECIMALS ± .005 ANGLES ± 1/2° SURFACE FINISH 32/ DIMENSIONALITY 0.004 TIR		CONTRACT NO	
DRAWN: JMB		DATE: 3/14/06	
CHECKED:		ENGR:	
DESIGN: JMB		DESIGN:	
THIRD ANGLE PROJECTION		SIZE: D	
SCALE: 2X		PART NO: 1033621	
REF. NO: 0PM-225-06		SHEET: 1 OF 1	

A

B

C

D

A

B

C

D