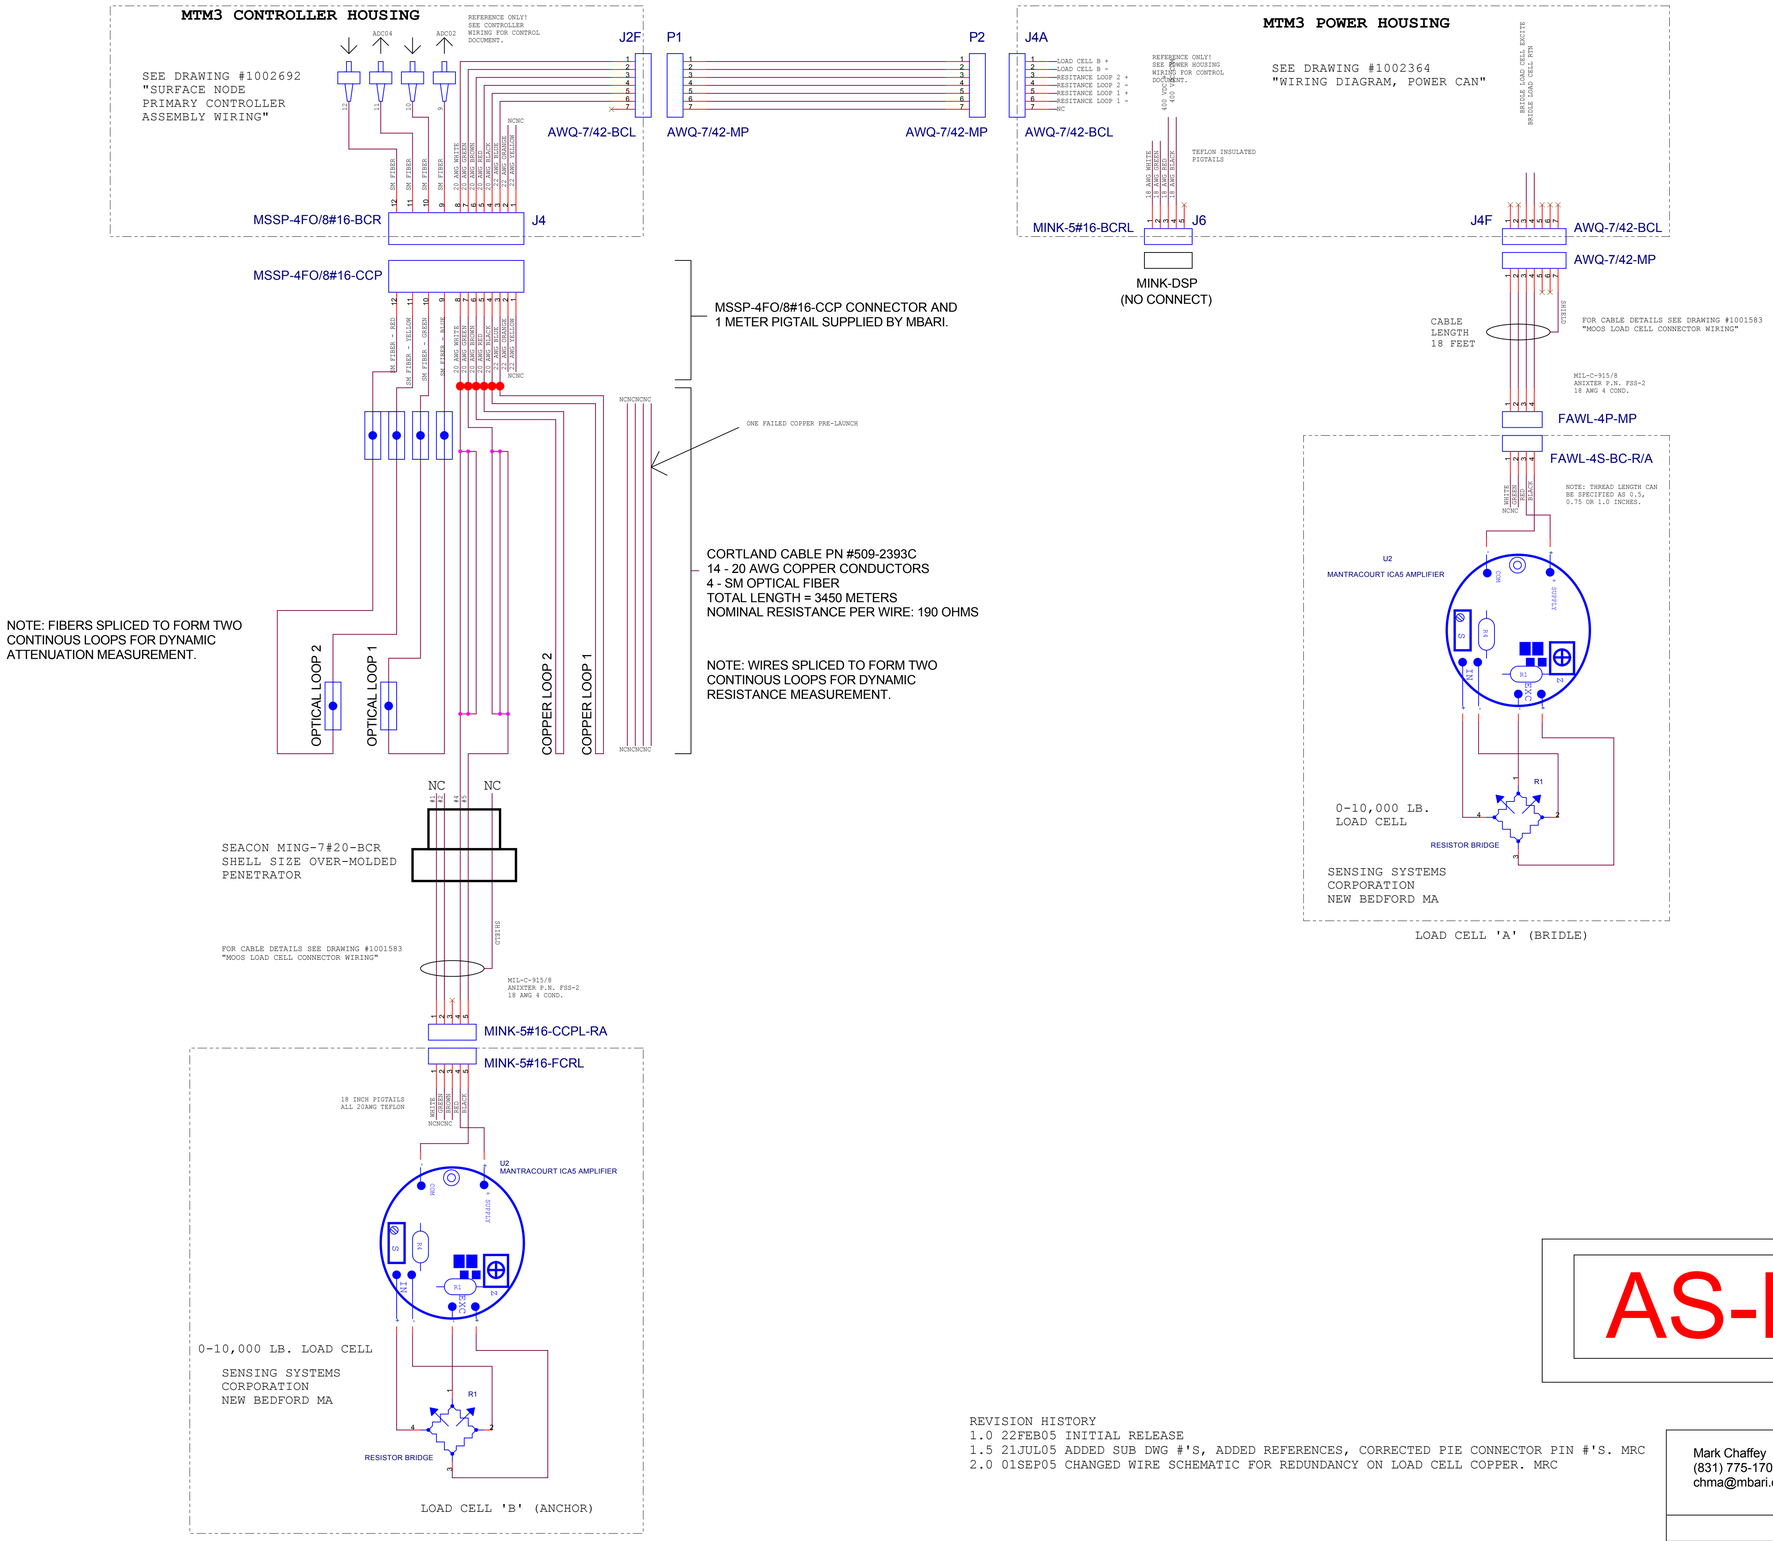

AS-BUILT

REVISION HISTORY
1.0 22FEB05 INITIAL RELEASE
1.5 21JUL05 ADDED SUB DWG #'S, ADDED REFERENCES, CORRECTED PIE CONNECTOR PIN #'S. MRC
2.0 01SEP05 CHANGED WIRE SCHEMATIC FOR REDUNDANCY ON LOAD CELL COPPER. MRC

Mark Chaffey
(831) 775-1708
chma@mbari.org

MBARI
7700 SANDHOLDT ROAD
MOSS LANDING, CALIFORNIA 95039

MTM3 Riser Cable Assembly

Size	CAGE Code	DWG NO	Rev
D	<Cage Code>	1002689SCH-2.0	2.0

Scale

Sheet 1 of 1

Thursday, September 01, 2005