


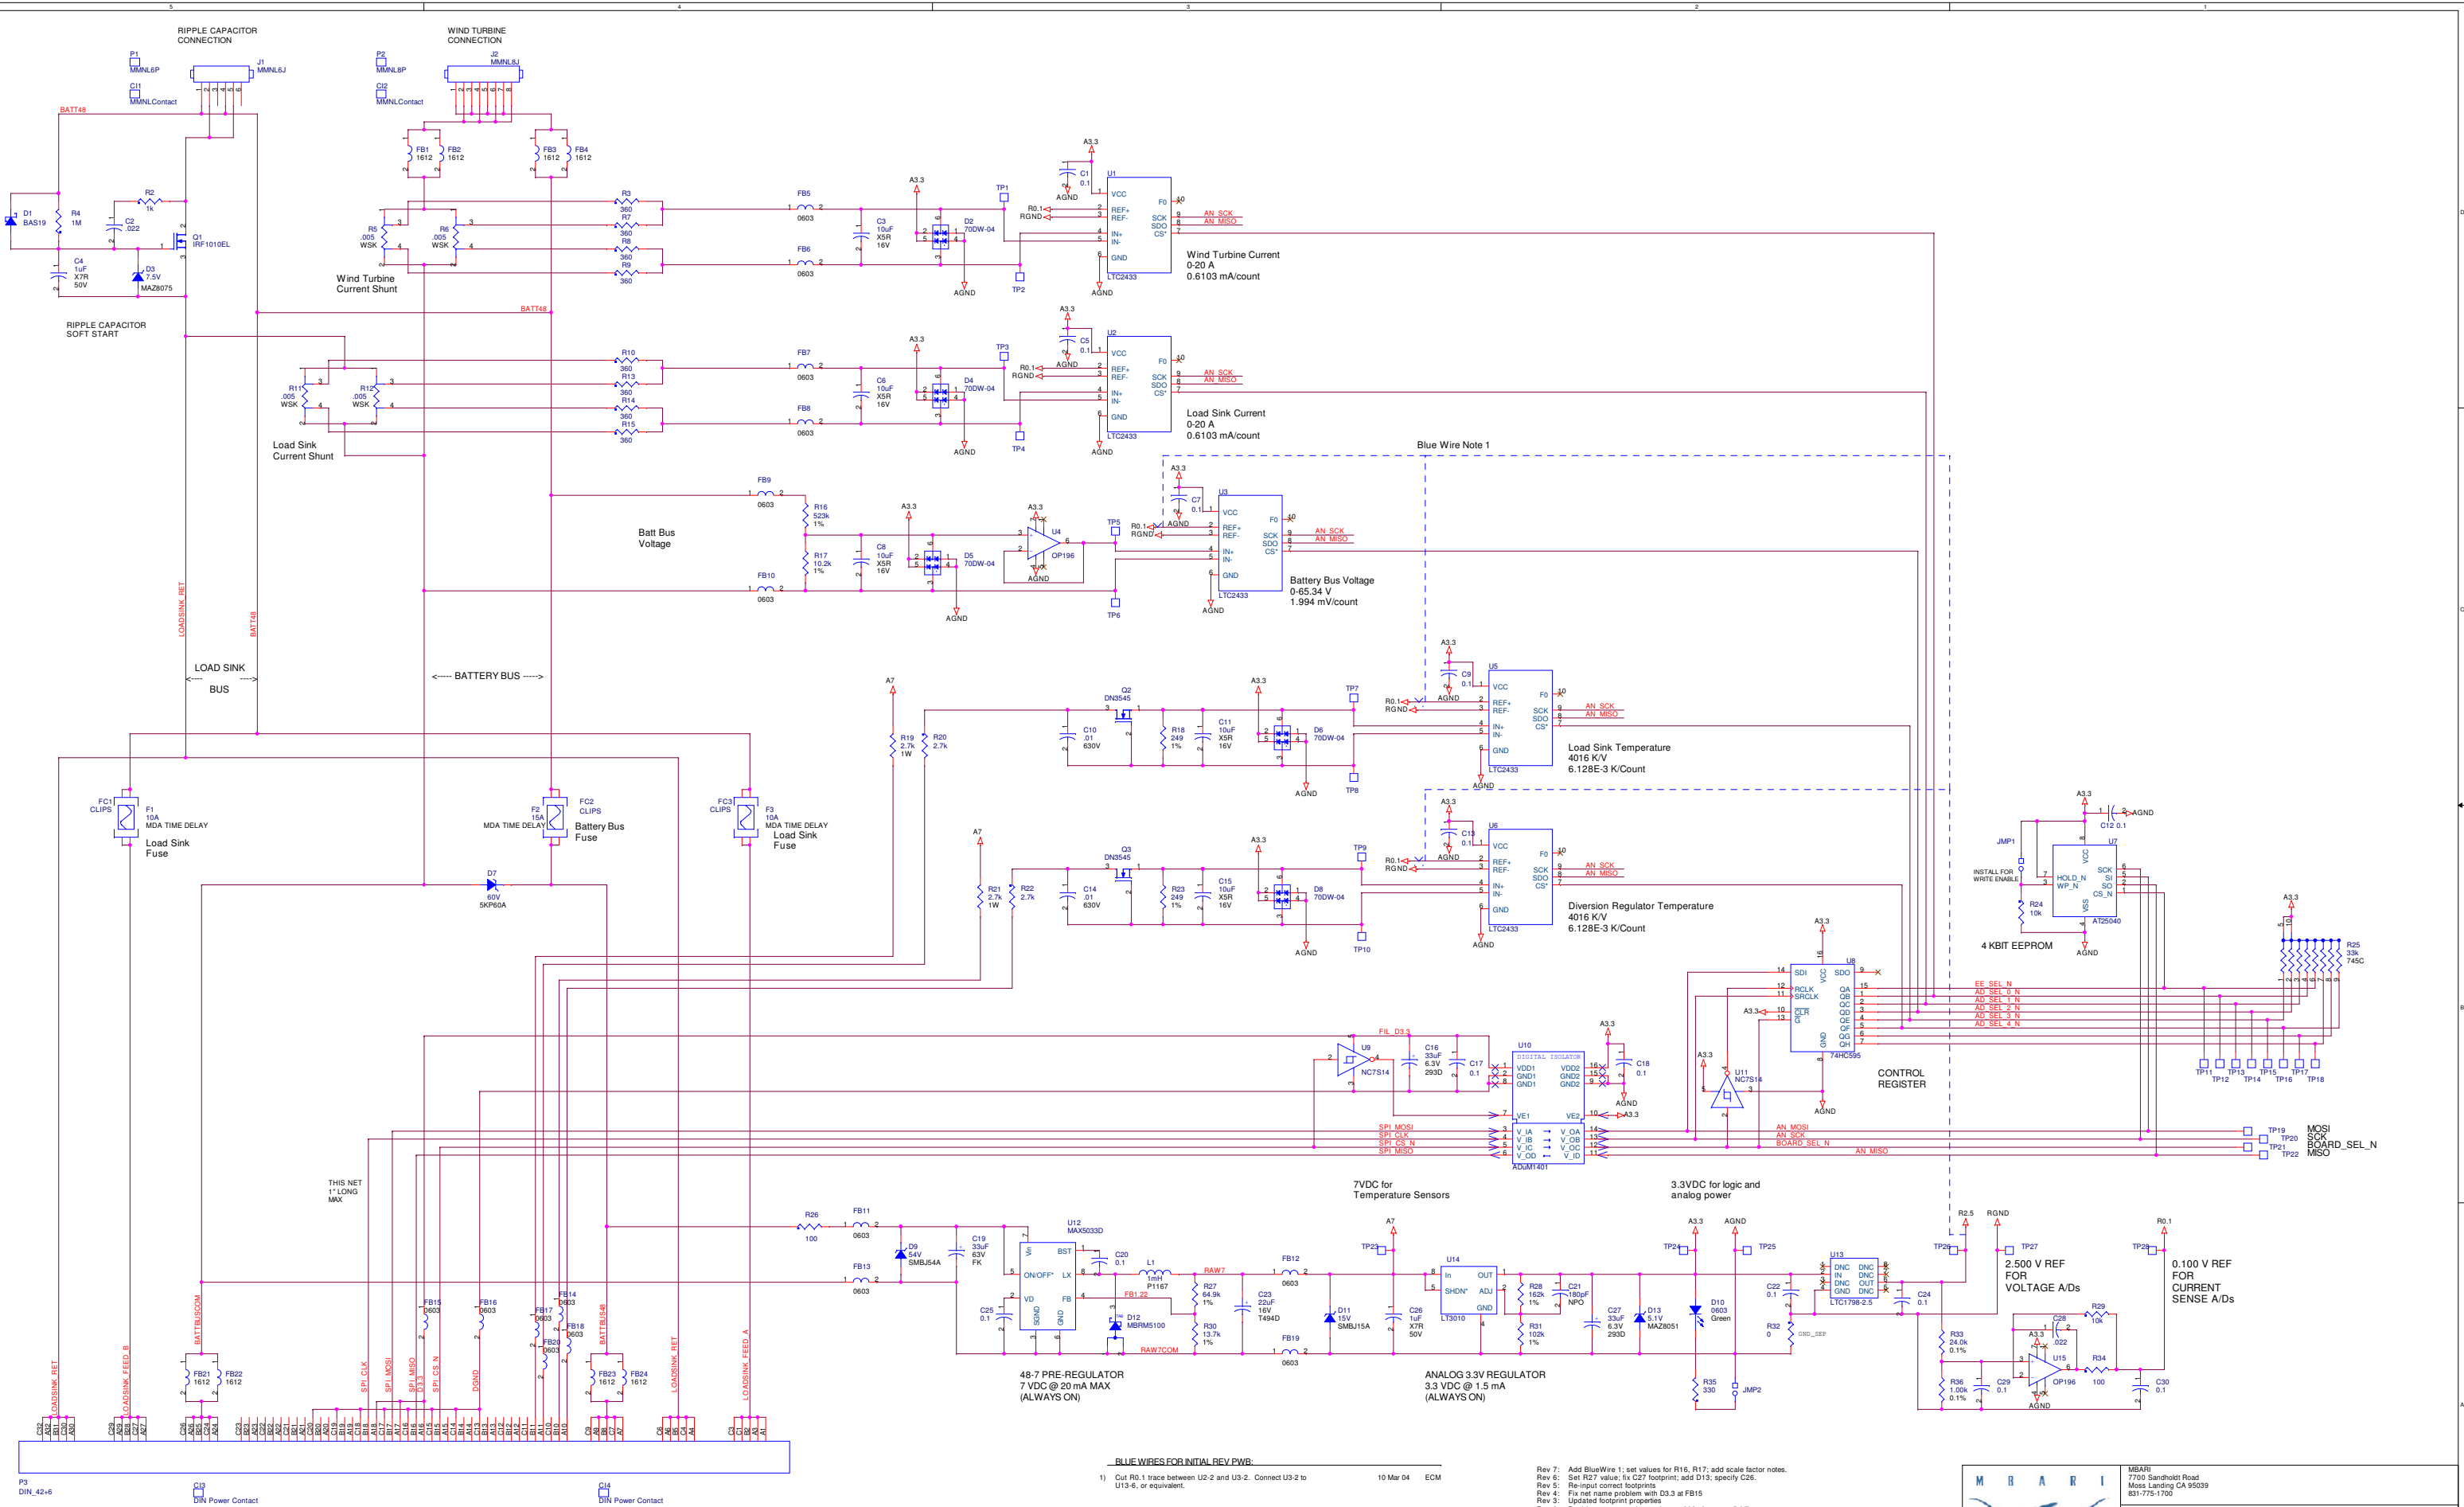

BLUE WIRES FOR INITIAL REV PWB:

- 1) Cut R0.1 trace between U2-2 and U3-2. Connect U3-2 to U13-6, or equivalent.

10 Mar 04 EGM

- Rev 7: Add BlueWire 1; set values for R16, R17; add scale factor notes.
Rev 6: Set R27 value; fix C27 footprint; add D13; specify C26.
Rev 5: Re-input correct footprints
Rev 4: Fix net name problem with D3.3 at FB15
Rev 3: Updated footprint properties
Rev 2: Double-up current shunts due to .002 ohm unavailability.
Rev 1: Initial Release for review

 Ed Mellinger 831-775-1730 med@mbari.org	MBARI 7700 Sandholdt Road Moss Landing CA 95039 831-775-1700		Schematic, Wind Turbine and Load Sink Interface Board, MOOS Power System	
	Size D	CAGE Code <Cage Code>	DWG NO 1002298	Rev I 7
Wednesday, March 10, 2004	Scale		Sheet 1	of 2

\\Tomado\orcad\Projects\MOOS_Test_Mooring_2\surface_model\MOOSPowerSystem\Design-AcquisitionSystem\WindLoadBoard