


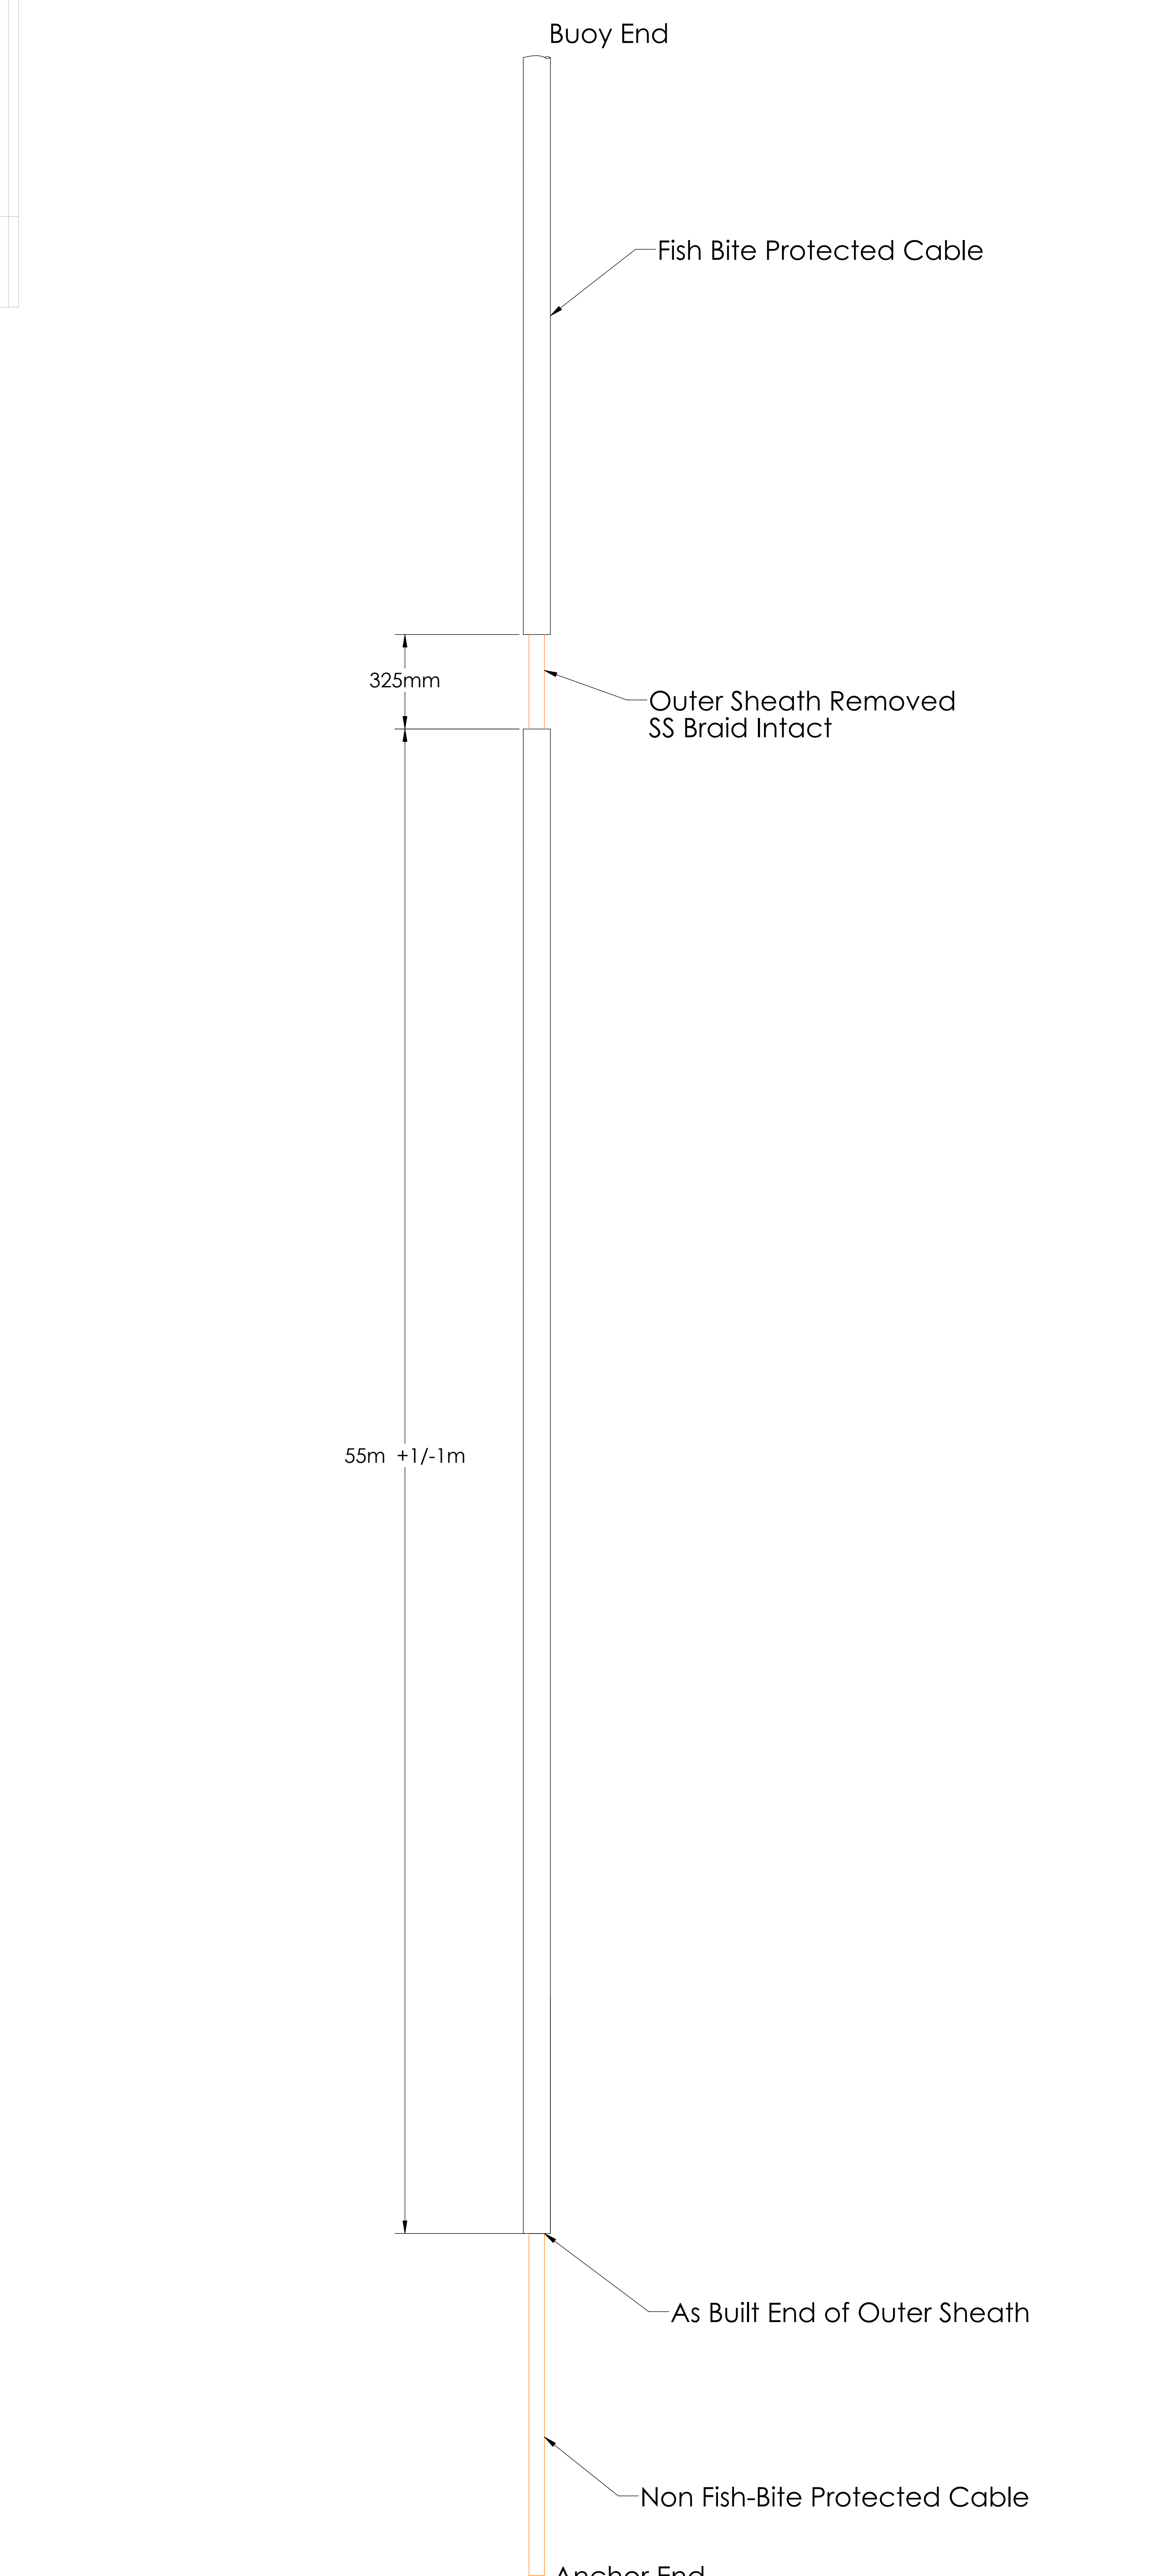

1			
REV.	DESCRIPTION	DATE	APPROVED
INITIAL RELEASE		XX/XX/XX	

Shop / Q.C.		UNLESS OTHERWISE SPECIFIED TOLERANCES ARE:		APPROVALS		DATE		BILL OF MATERIALS	
Inspector		1. PLACE DIM. ±.010	2. PLACE DIM. ±.015	3. PLACE DIM. ±.020	ANGLES 1/2°	DRAWN JAH	1/27/06	PROJECT NO.	600027
Shop Foreman		1. DIMENSIONS ARE IN INCHES		2. DIMENSION LIMITS HELD AFTER PLATING.		ENGINEER JAH	1/27/06	PROJECT	MOOS Mooring
Engineer		3. REMOVE BURRS AND SHARP EDGES TO 1/16" MAX.		4. MACHINED FILET RADIUS 0.150-0.300.		CHECKED		MOOS Mooring	
NEXT ASSY Description	NEXT ASSY Number	5. MACHINED DIMENSIONS ON A CROWN OR CENTERLINE CONCENTRIC WITHIN .005"		6. PERPENDICULARITY & PARALLELISM OF MACHINED SURFACES .002 PER INCH MAX .010 INCHES FOR SINGLE SURFACE.		SCALE		1003009	
APPLICATION		DO NOT SCALE DRAWING		WEIGHT		CAD FILE: BARNACLE/ARCHIVE		SHEET 1 OF 1	

NOTES: (CONT. FROM TITLE BLOCK)



Monterey Bay Aquarium Research Institute
MBARI
7700 Sandholdt RD.
 Moss Landing, CA 95039
PH: (831) 775-1700

MOOS Cable - Outer Sheath Mods