THE INFORMATION CONTAINED IN THIS DRAWING IS THE SOLE PROPERTY OF MBARI ANY REPRODUCTION IN PART OR WHOLE WITHOUT THE WRITTEN PERMISSION OF MBARI IS PROHIBITED.

REVISIONS			
REV.	DESCRIPTION	DATE	APPROVED
	INITIAL RELEASE	XX/XX/98	

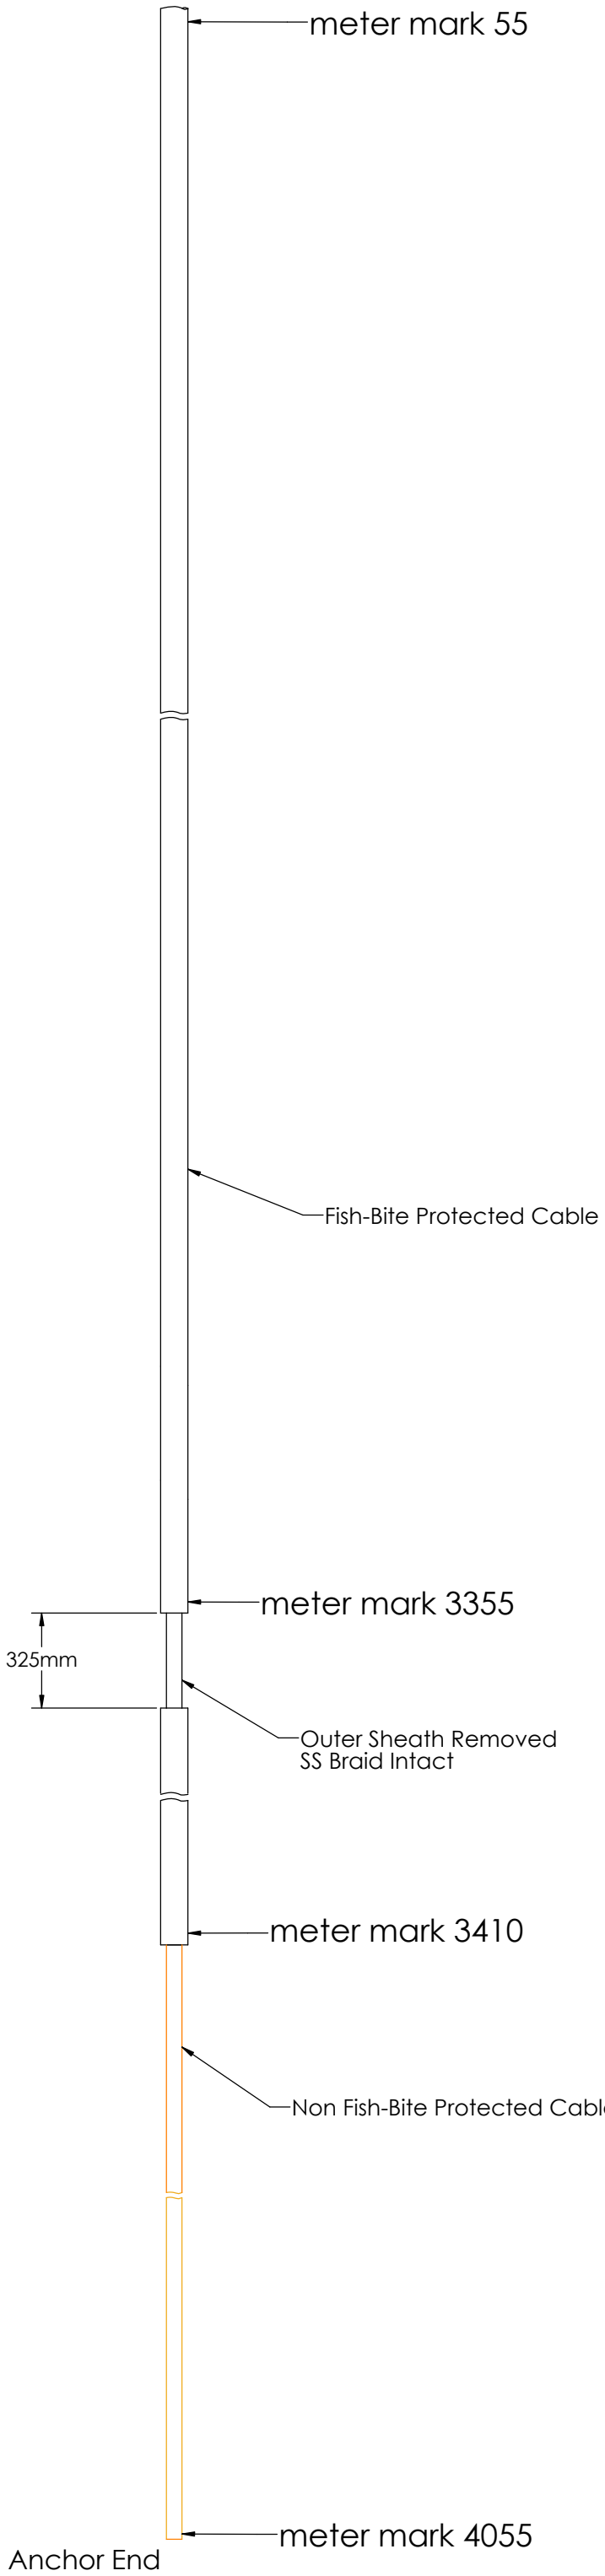

Not To Scale

BILL OF MATERIALS			
Shop / Q.C.	UNLESS OTHERWISE SPECIFIED TOLERANCES ARE:	APPROVALS	DATE
Inspector	1 PLACE DIM ±1/16 · 2 PLACE DIM ±.02 · 3 PLACE DIM ±.005 · ANGLES ±1°	DRAWN JAH	6/07/06
Shop Foreman	1. DIMENSIONS ARE IN INCHES	ENGINEER JAH	6/07/06
Engineer	2. DIMENSION LIMITS HELD AFTER PLATING.	CHECKED	
NEXT ASSY Description / NEXT ASSY Number	3. REMOVE BURRS AND SHARP EDGES .015 MAX. 4. MACHINED FILLET RADII .015/.030. 5. MACHINED DIAMETERS ON A COMMON CENTERLINE CONCENTRIC WITHIN .005	PROJECT NO. 600027	
	6. PERPENDICULARITY & PARALLELISM OF MACHINED SURFACES .002 PER INCH, MAX .012 INCHES FOR SINGLE SURFACE.	PROJECT MOOS Mooring	
APPLICATION	DO NOT SCALE DRAWING	WEIGHT	

Monterey Bay Aquarium Research Institute
MBARI
7700 Sandholdt RD.
Moss Landing, CA 95039
PH: (831) 775-1700

MTM-4 EOM Cable - Final Lengths

SIZE D | DWG. NO. 1003178 | REV.

SCALE | CAD FILE: BARNACLE\ARCHIVE | SHEET 1 OF 1