



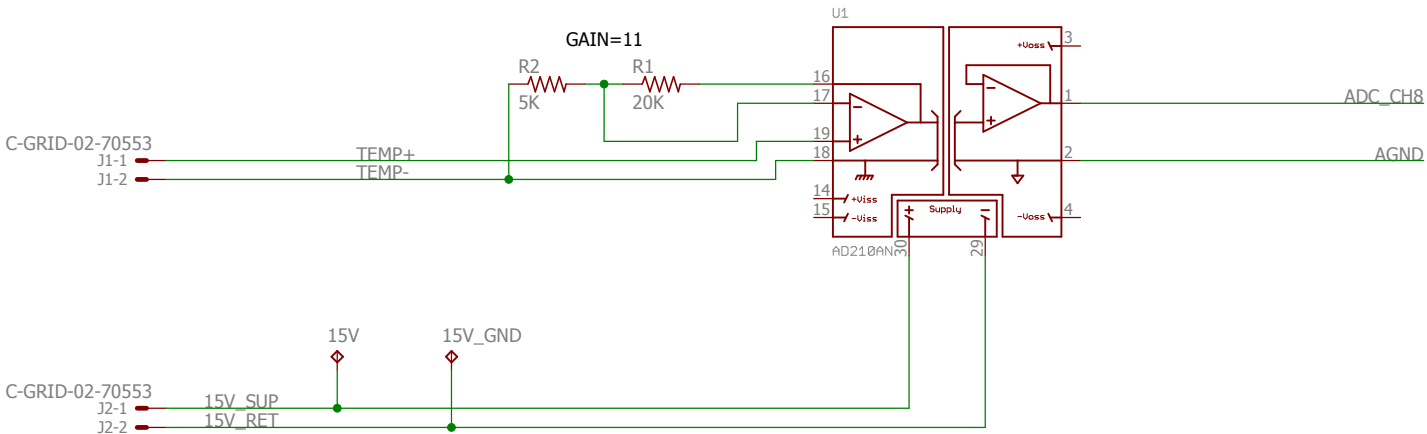


VERSALOGIC A/D BREAKOUT

ADC_CH1	1
ADC_CH2	2
AGND	3
AGND	4
ADC_CH3	5
ADC_CH4	6
AGND	7
AGND	8
ADC_CH5	9
ADC_CH6	10
AGND	11
AGND	12
ADC_CH7	13
ADC_CH8	14
AGND	15
AGND	16
DGND	17
GPIO1	18
GPIO2	19
GPIO3	20


5015712007

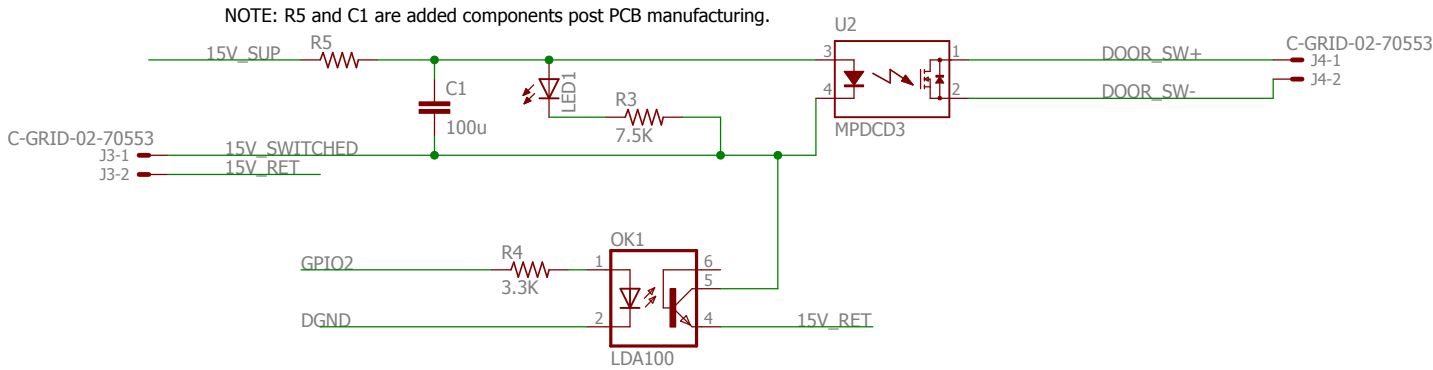


FALCON 5V INPUT

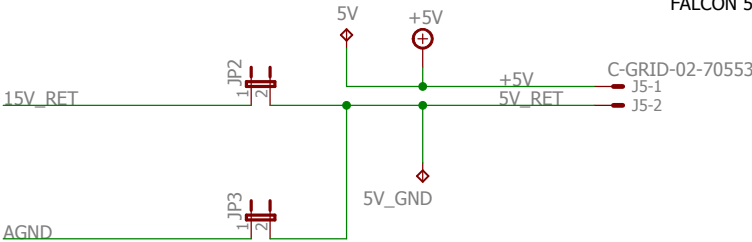



HTM2500LF HUMID/TEMP SENSOR

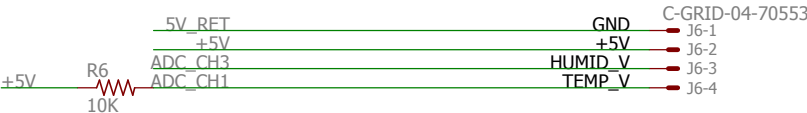

AUXILLARY SENSOR A

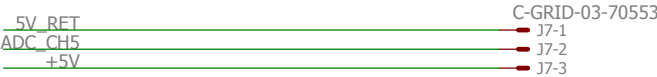

AUXILLARY SENSOR B

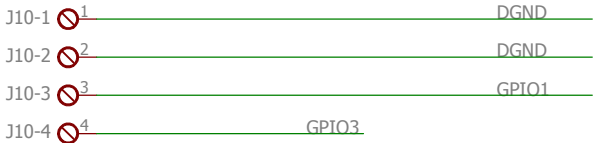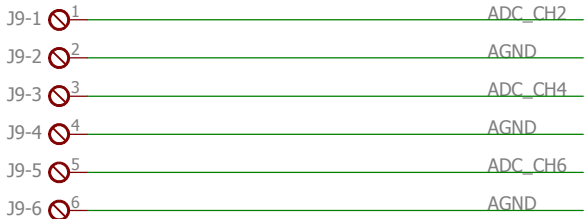

TITLE: dorissIIAuxCircuits_MATING PLATE		
Document Number:	11021169	REV: A
Date: 8/31/2015 2:20 PM	Sheet:	1/1