
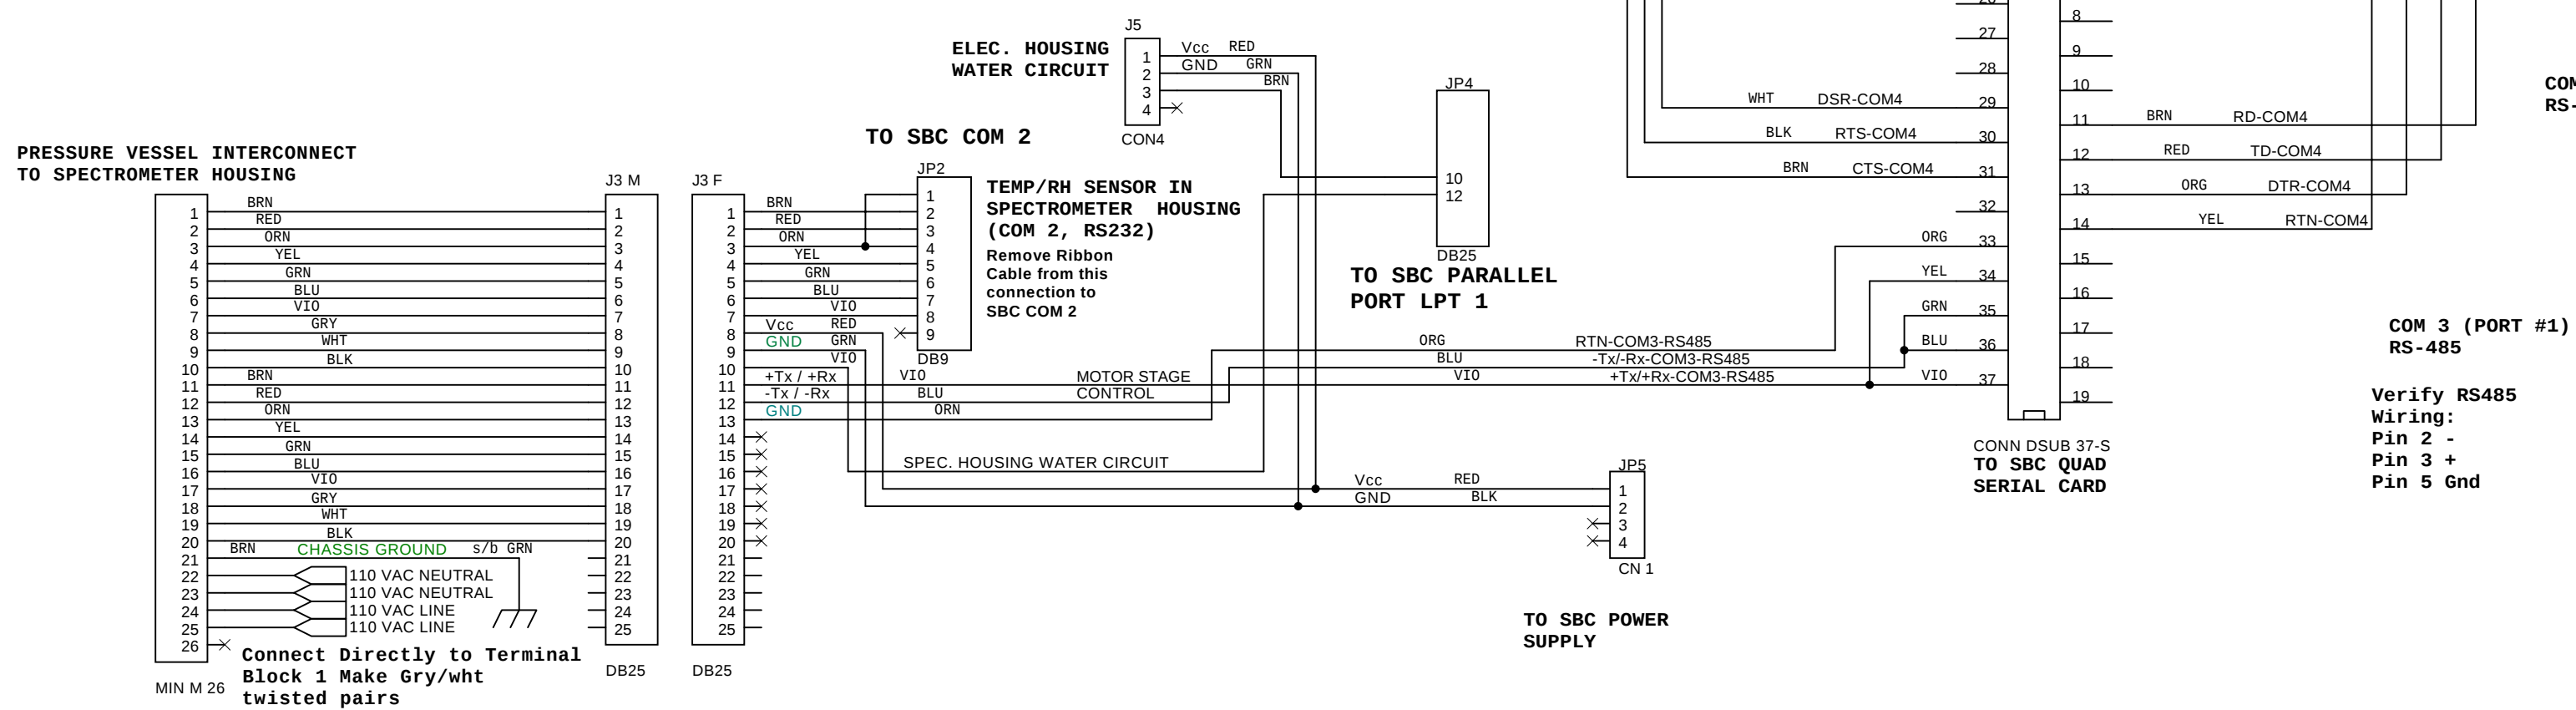
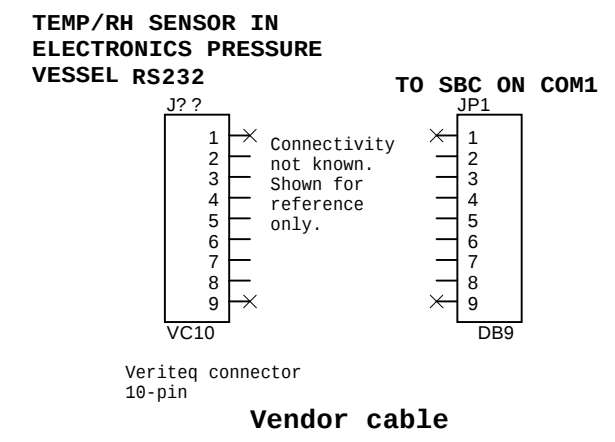
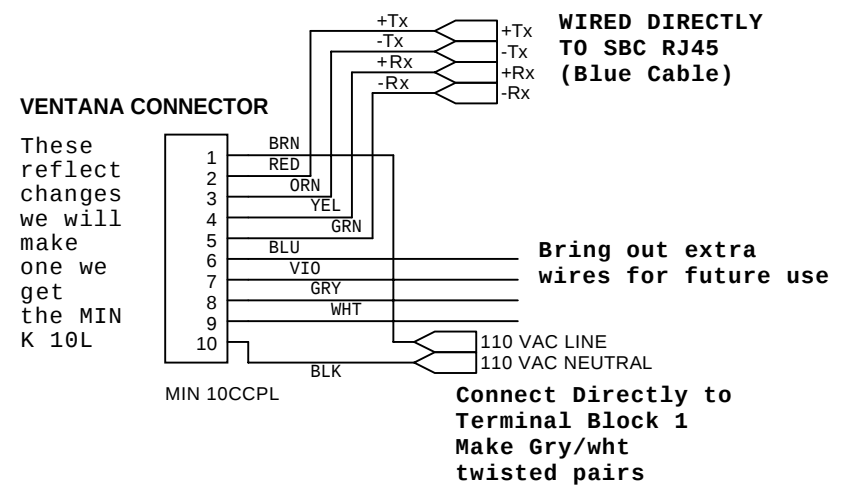
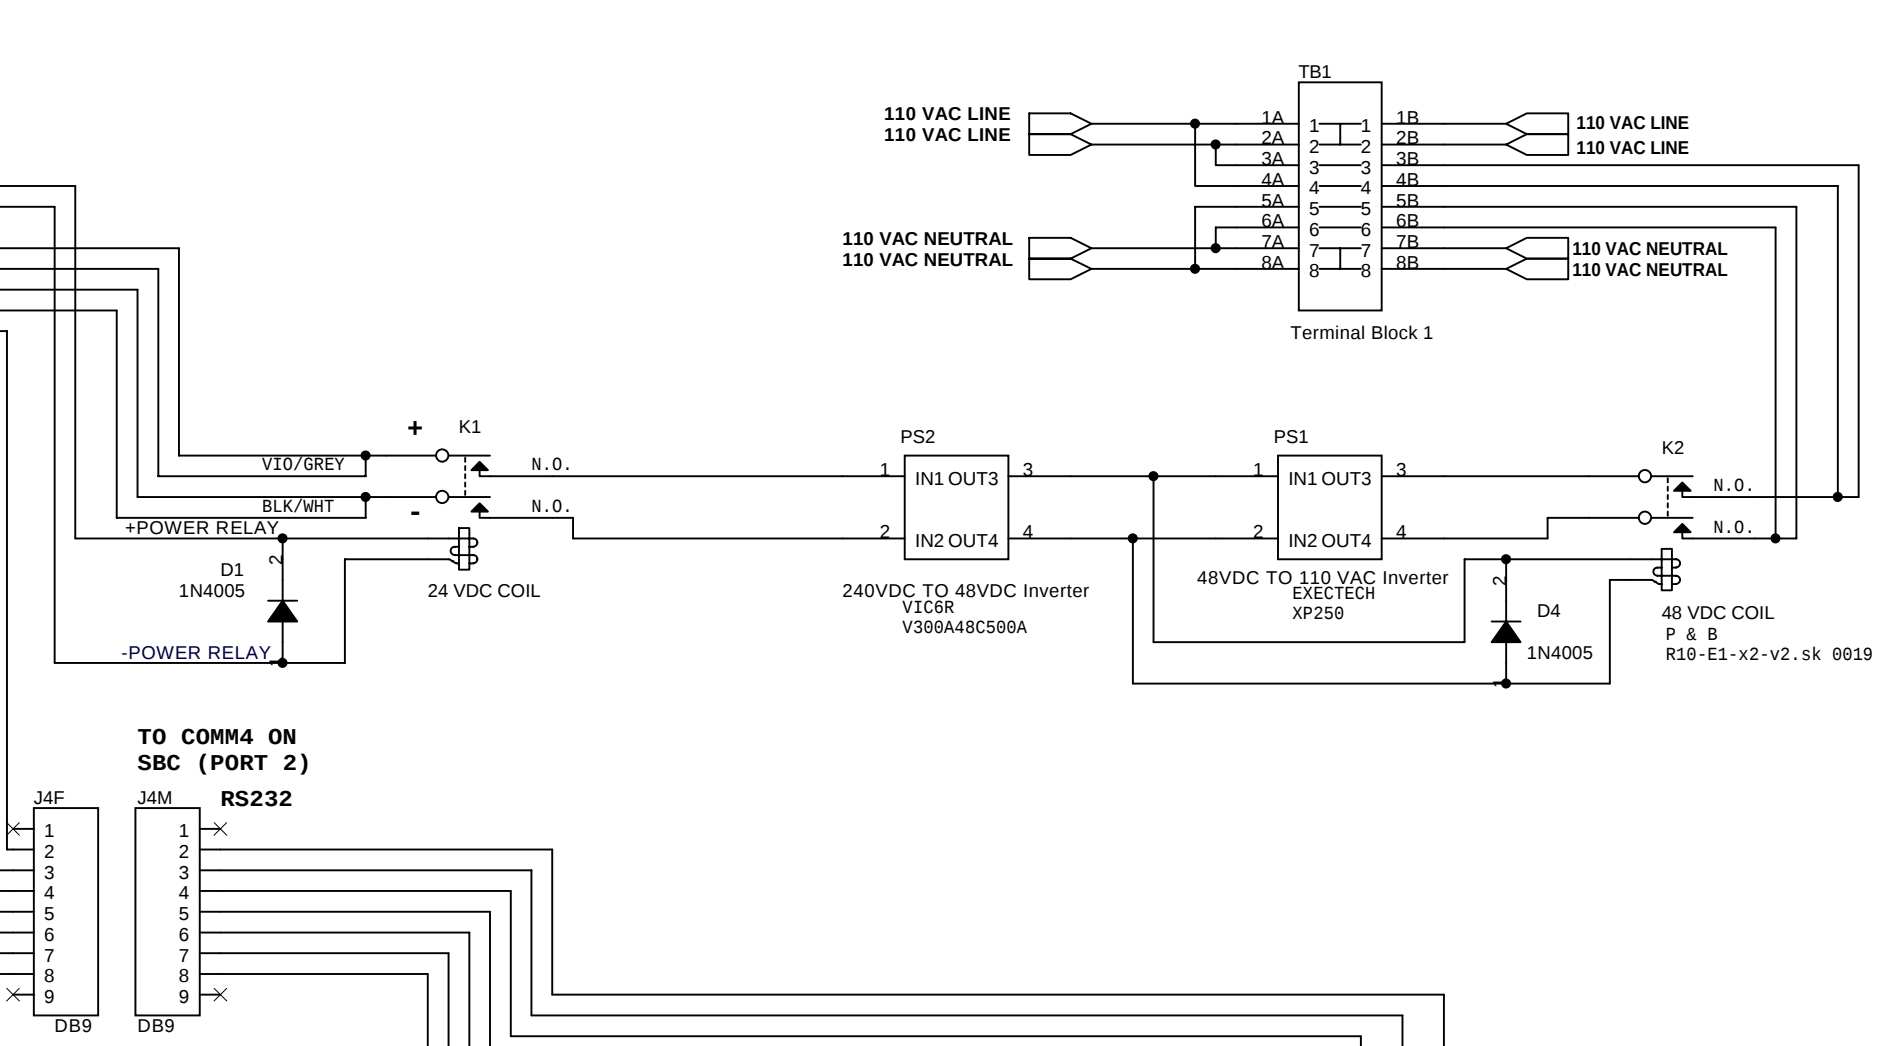


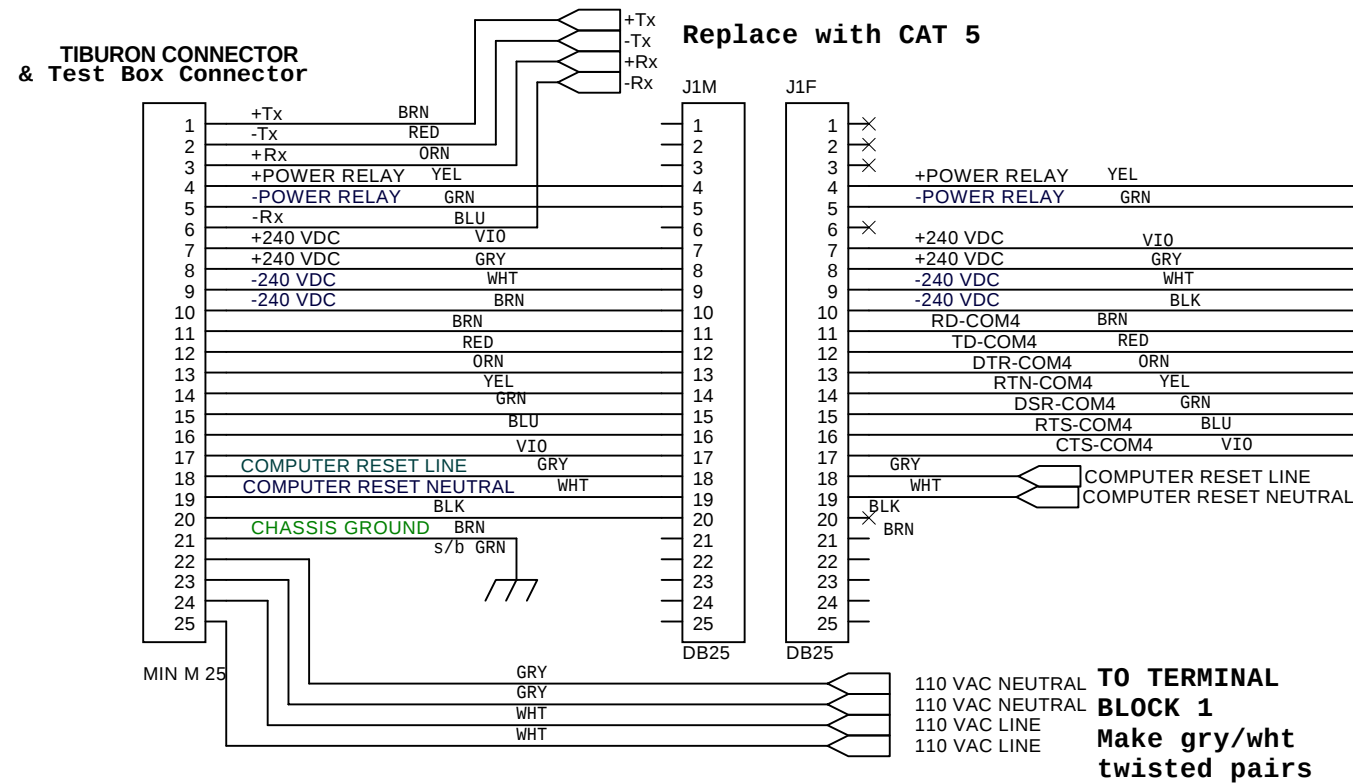

Revised by: A. Sherman / D.Thompson; updated wiring, removed DB15 pair, connect chassis gnds directly, TB1 now only AC, replace JP3 w/new graphic, replace incorrect net-alias' with text, increased sheet to C size

Revised by: D. Littlefield 02-19-03, Added various wiring changes & title change.

Engineer by: George Malby

Checked by: Sheri White

Drawn By: D. Littlefield 08-03-01

MBARI 7700 Sandholdt Rd Moss Landing, CA 95039-9644		
Title ELECTRONICS PRESSURE VESSEL WIRING		
Size C	Document Number 101264	Rev B
Date: Tuesday, September 23, 2003 Sheet 1 of 1		