

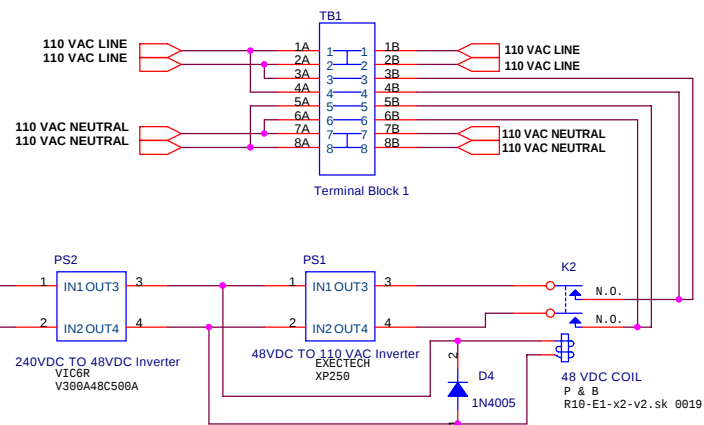



TIBURON CONNECTOR & Test Box Connector

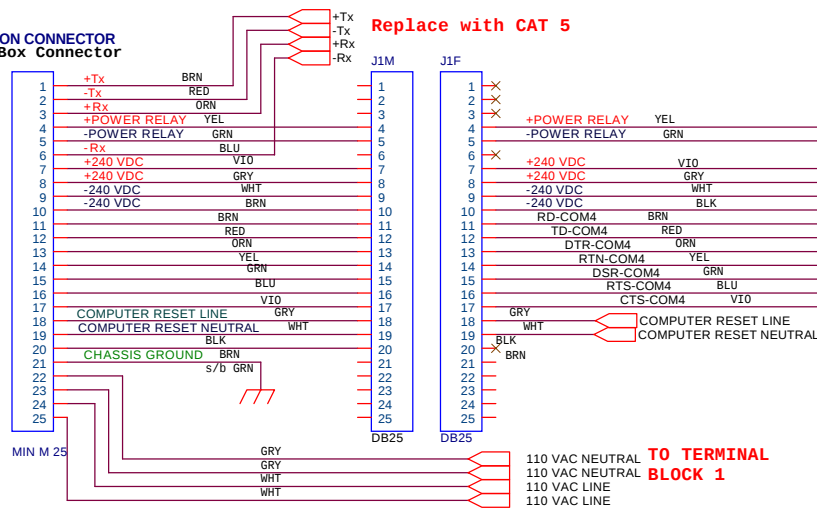


TO COM4 ON SBC (PORT 2) RS232

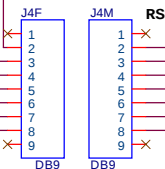

ROV CONNECTOR

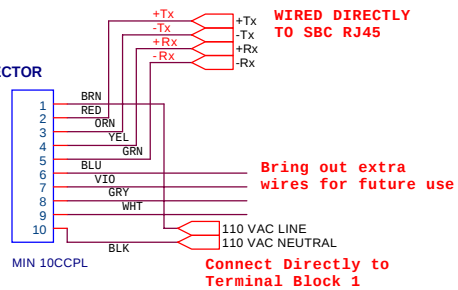


TEMP/RH SENSOR IN ELECTRONICS PRESSURE VESSEL RS232

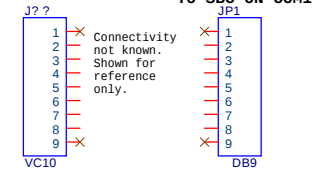

Vendor cable


PRESSURE VESSEL INTERCONNECT TO SPECTROMETER HOUSING

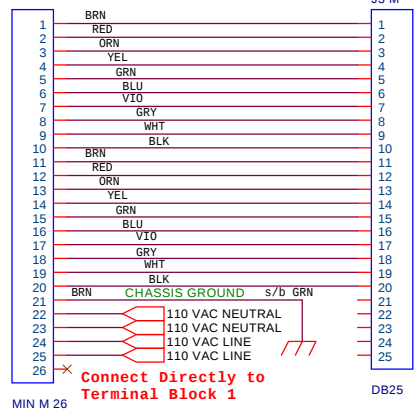

TO SBC COM 2




TO SBC PARALLEL PORT LPT 1

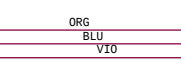

TO SBC POWER SUPPLY



JP3

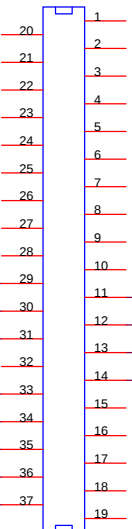

COM 4 (PORT #2) RS-232



COM 3 (PORT #1) RS-485



Revised by: A. Sherman / D.Thompson; updated wiring, removed DB15 pair, connect chassis gnds directly, TB1 now only AC, replace JP3 w/new graphic, replace incorrect net-alias' with text, increased sheet to C size

Revised by: D. Littlefield 02-19-03, Added various wiring changes & title change.

Engineer by: George Malby

Checked by: Sheri White

Drawn By: D. Littlefield 08-03-01

MBARI 7700 Sandholdt Rd Moss Landing, CA 95039-9644			
Title			
ELECTRONICS PRESSURE VESSEL WIRING			
Size	Document Number	Rev	
C	101264	B	
Date:	Wednesday, October 29, 2003	Sheet	1 of 1