


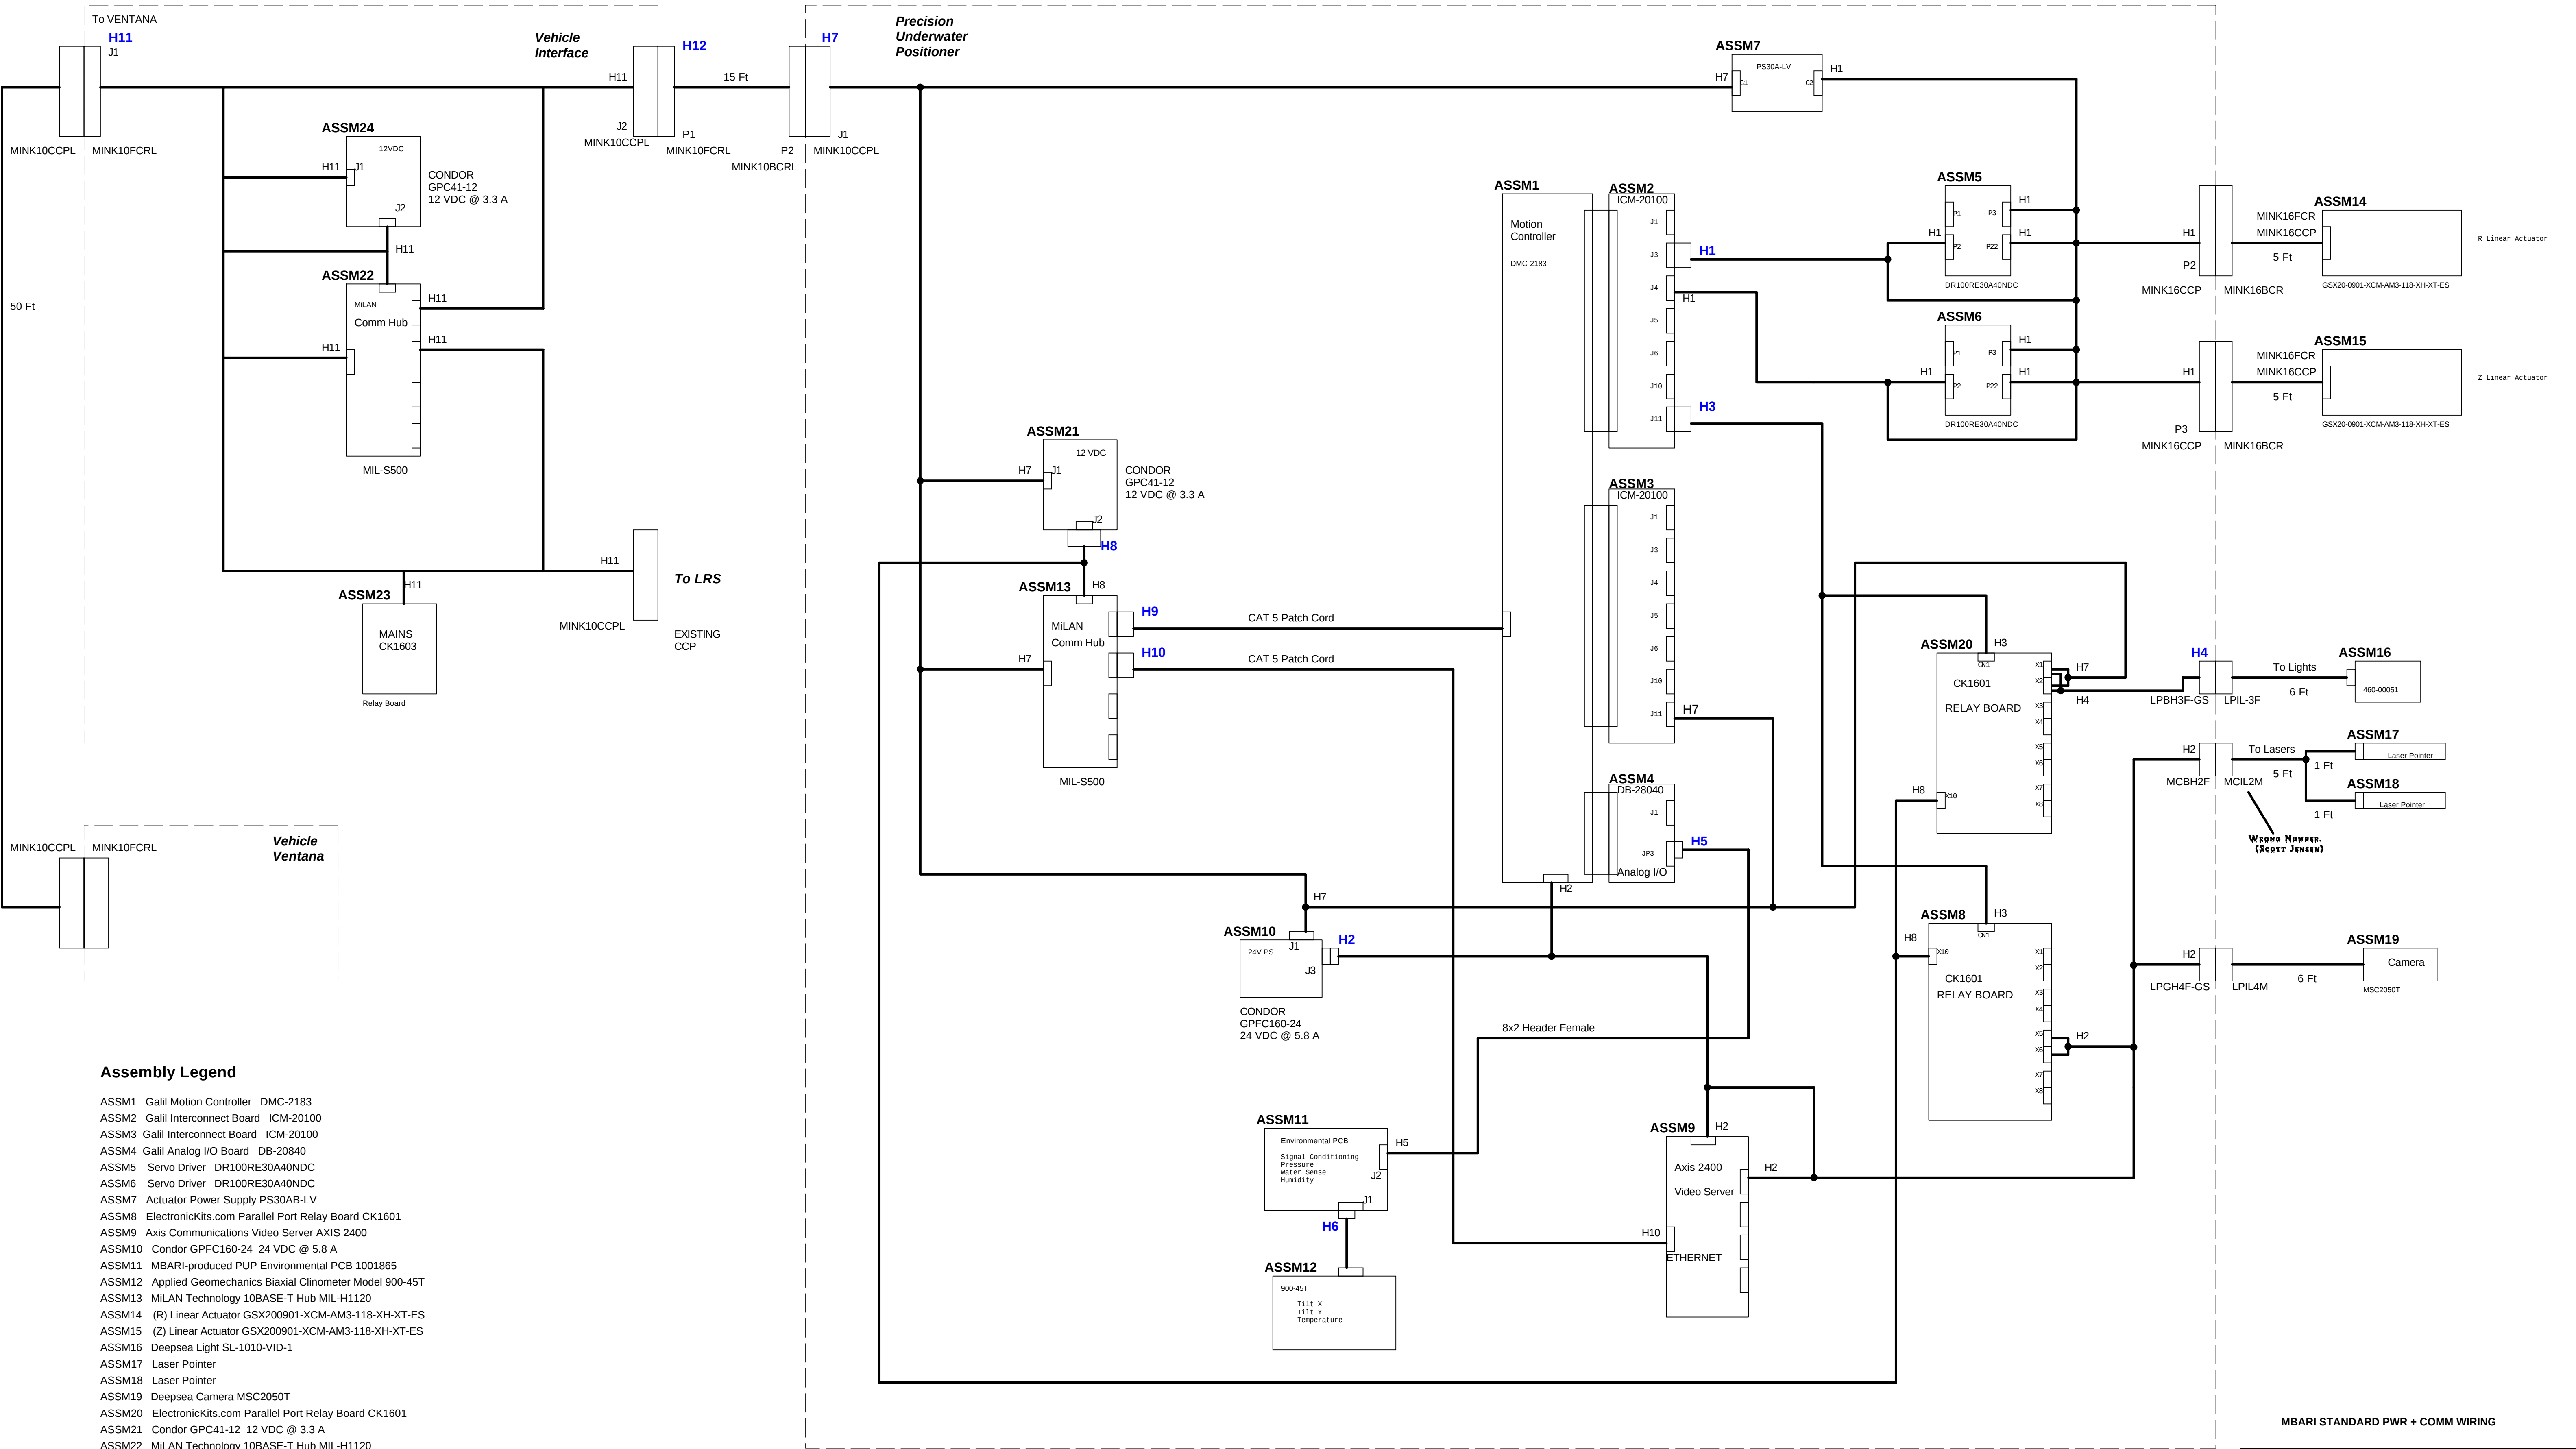

MBARI STANDARD PWR + COMM WIRING