
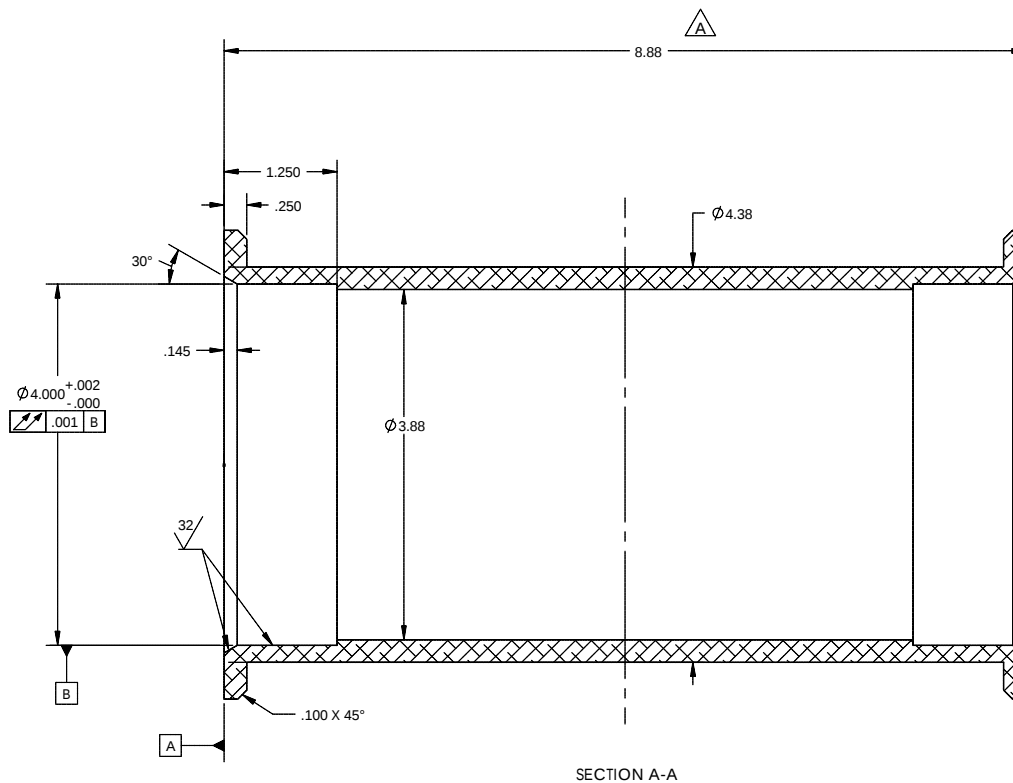



THE INFORMATION CONTAINED IN THIS DRAWING IS THE SOLE PROPERTY OF MBARI. ANY REPRODUCTION IN PART OR WHOLE WITHOUT THE WRITTEN PERMISSION OF MBARI IS PROHIBITED.

REVISIONS			
REV.	DESCRIPTION	DATE	APPROVED
A	Tube length 8.88 was 7.13	7/9/03	

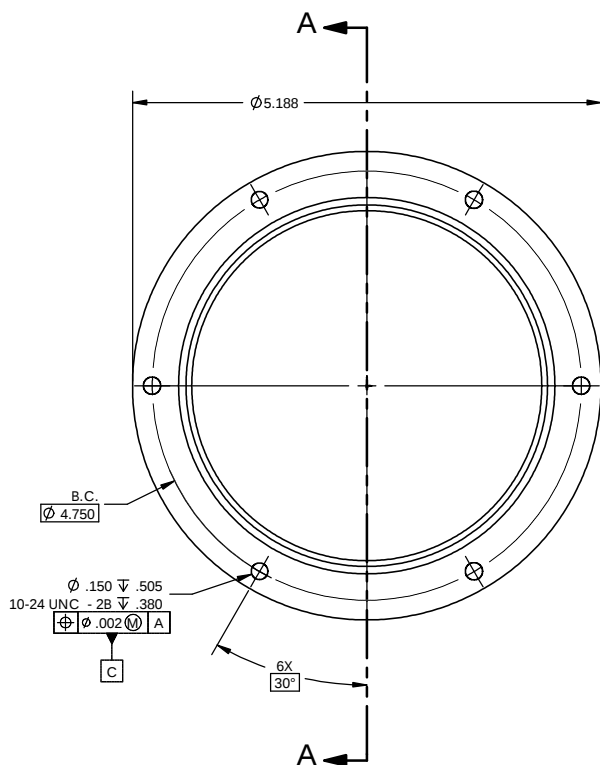

SECTION A-A

7. All dimensions are symmetric about common center lines unless specified otherwise.

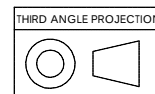

ITEM NO.	QTY.	DESCRIPTION	PART NUMBER	VENDOR	MATERIAL
1	1	Con Tube	1002016	MBARI	Titanium 6AL-4V
BILL OF MATERIALS					
Shop / Q.C.		UNLESS OTHERWISE SPECIFIED TOLERANCES ARE:		APPROVALS	DATE
Inspector		1. DIMENSIONS ARE TO BE:	2. DIMENSIONS ARE TO BE:	3. DIMENSIONS ARE TO BE:	7/14/2003
NEXT ASSY		NEXT ASSY		PROJECTING	
Description		Number		PROJECTING	
APPLICATION		DO NOT SCALE DRAWING		WEIGHT	
				4.715	
				SCALE	
				CAD FILE	
				SHEET 1 OF 1	

Monterey Bay Aquarium Research Institute
MBARI
7700 Sandholdt Rd.

Con Tube
1002016

REV
A