



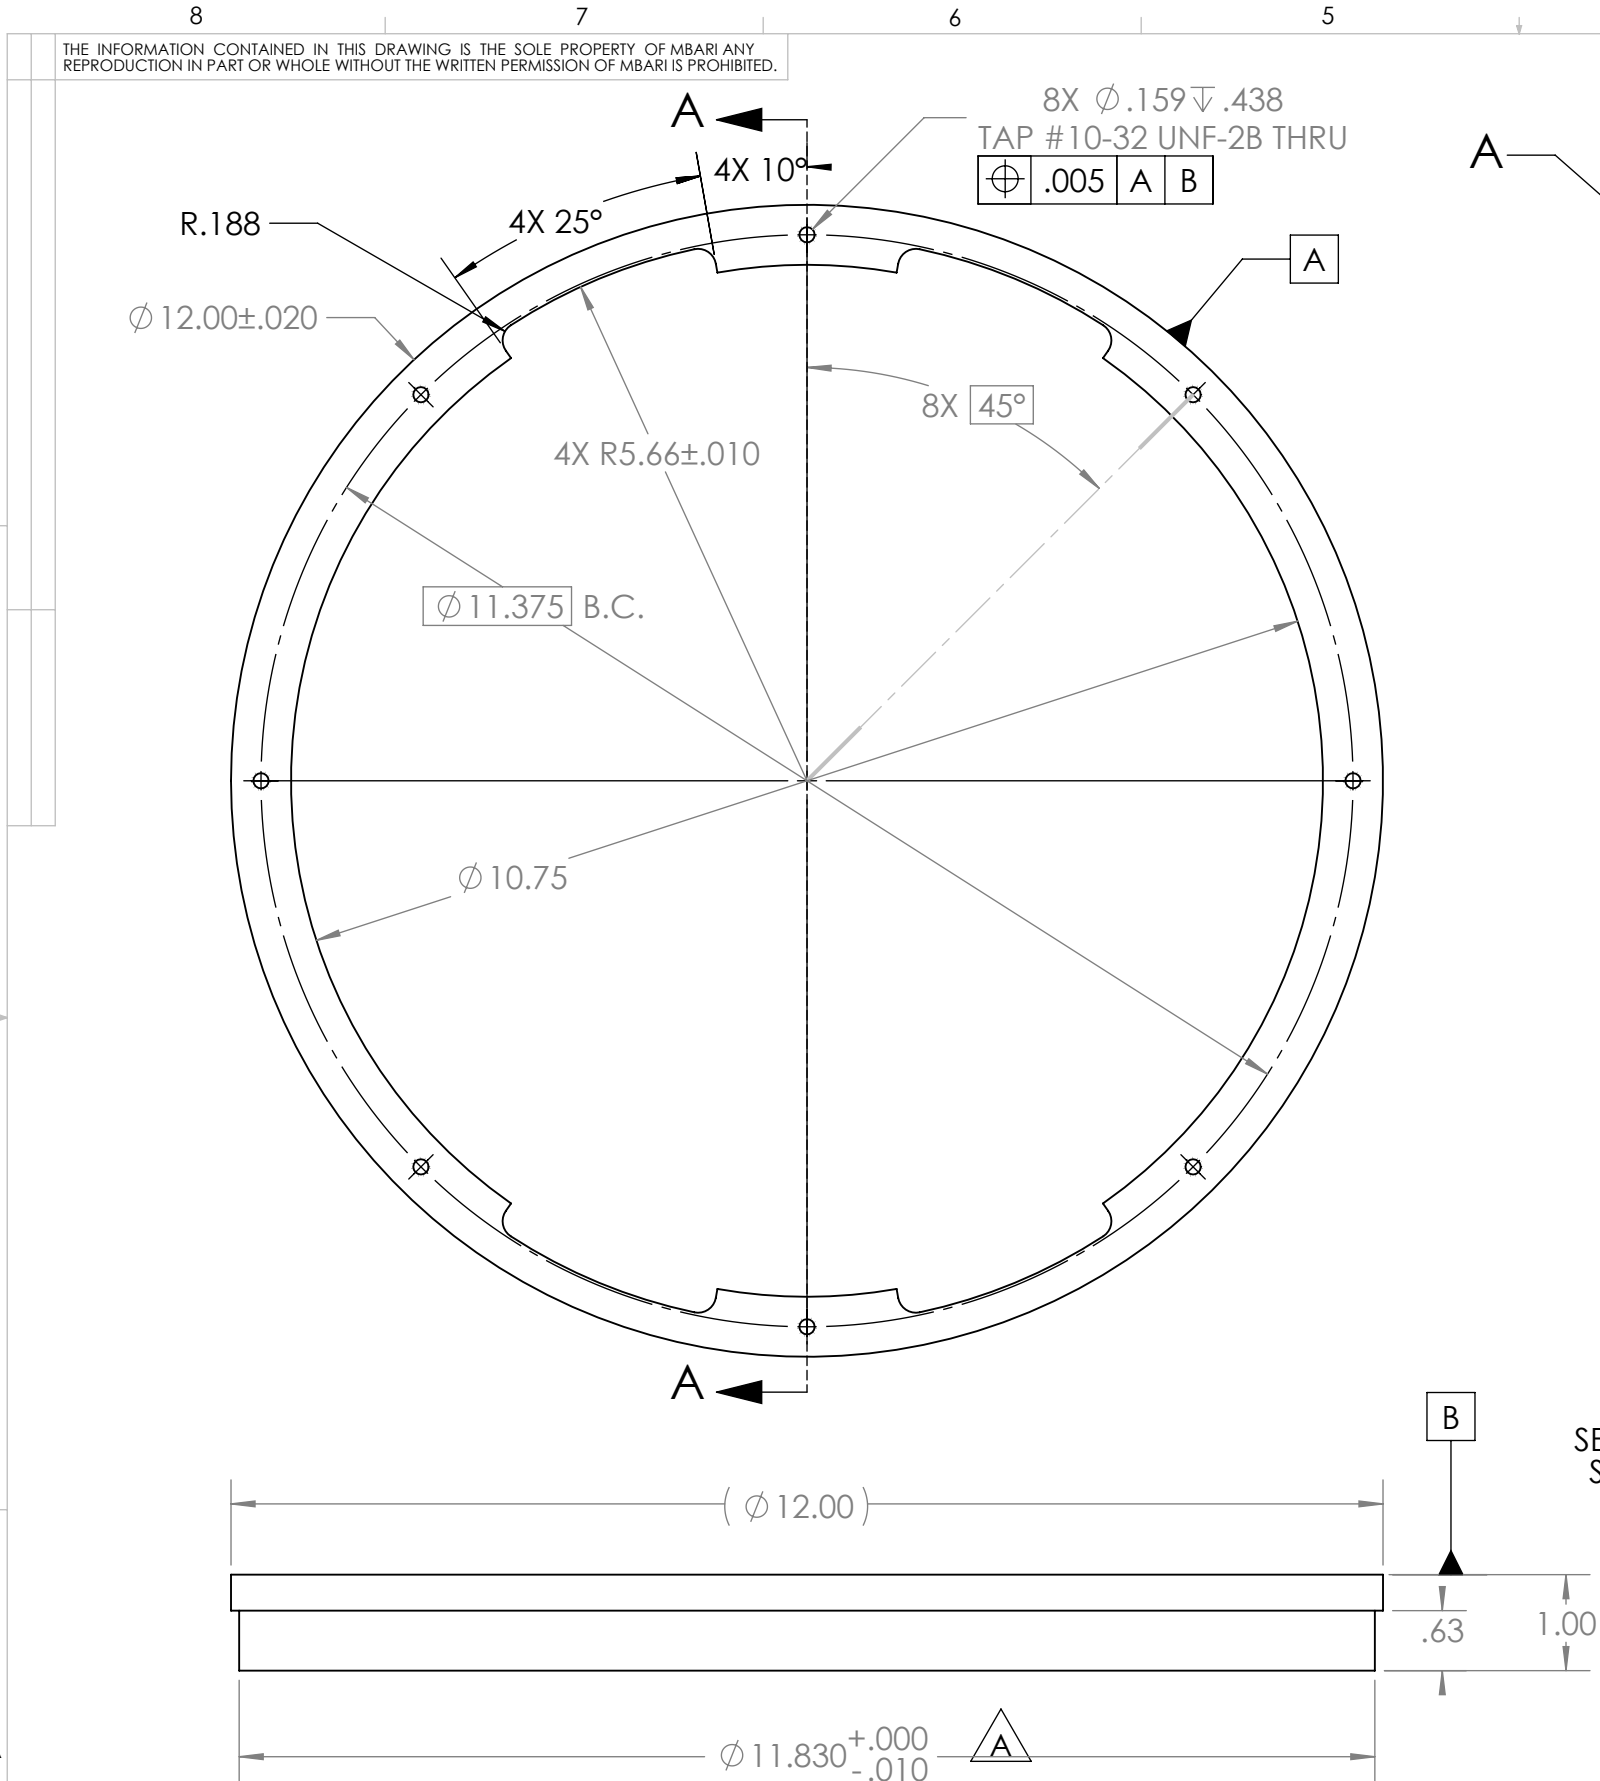


8. All dimensions are symetric about common center lines unless specified otherwise.

7. PROJECT LIBRARY:\701145 Penguin hotspots

NOTES: (CONT. FROM TITLE BLOCK)

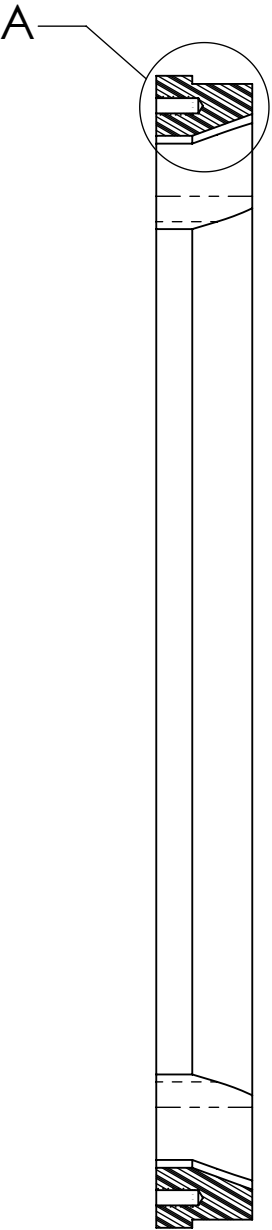

SECTION A-A
SCALE 1 : 2

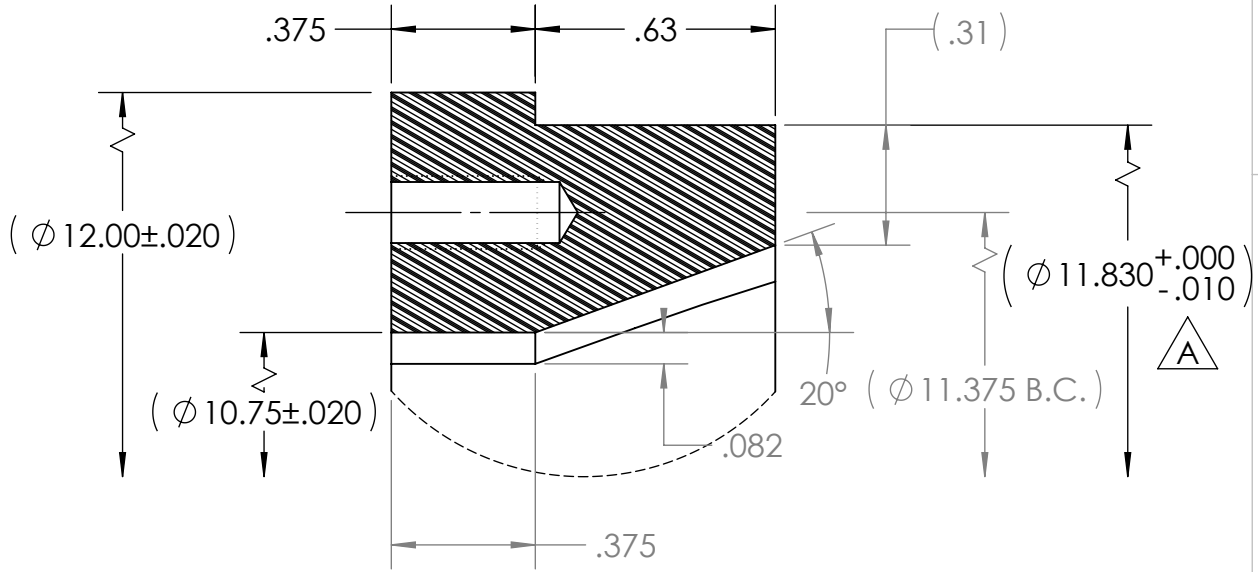

DETAIL A
SCALE 2 : 1

REVISIONS				
INITIAL RELEASE			X/XX/01	J.E.
REVISIONS				
ZONE	REV.	DESCRIPTION	DATE	APPROVED
A3, B1	A	CHG SHOULDER DOM frm 11.500 to 11.830	5/26/2022	J.E.

1	1	P-100221401-20	12" Shell Mount Ring	VanderVeer Ind.	G-10 Fiberglass Epoxy Laminare Sheet
ITEM NO.	QTY.	Part_Number	DESCRIPTION	Vendor	MATERIAL
BILL OF MATERIALS					
Shop / Q.C.		UNLESS OTHERWISE SPECIFIED TOLERANCES ARE:		APPROVALS DATE	
Inspector		1 PLACE DIM $\pm 1/16$	2 PLACE DIM $\pm .02$	3 PLACE DIM $\pm .005$	ANGLES $\pm 1^\circ$
Shop Foreman		1. DIMENSIONS ARE IN INCHES		DRAWN J. ERICKSON 1/28/20	
Engineer		2. DIMENSION LIMITS HELD AFTER PLATING.		ENGINEER J. ERICKSON 1/28/20	
		3. REMOVE BURRS AND SHARP EDGES .015 MAX.		CHECKED	
		4. MACHINED FILLET RADII .0150-.030.		PROJECT NO. 701145	
NEXT ASSY Description	NEXT ASSY Number	5. MACHINED DIAMETERS ON A COMMON CENTERLINE CONCENTRIC WITHIN .005		PROJECT Penguin Hotspots	
		6. PERPENDICULARITY & PARALLELISM OF MACHINED SURFACES .002 PER INCH. MAX .012 INCHES FOR SINGLE SURFACE.		WEIGHT 1.030	
Application		DO NOT SCALE DRAWING		SIZE B	
				SCALE 1:4	
				CAD FILE: MECH ENG ON TORNADO	
				SHEET 1 OF 1	