

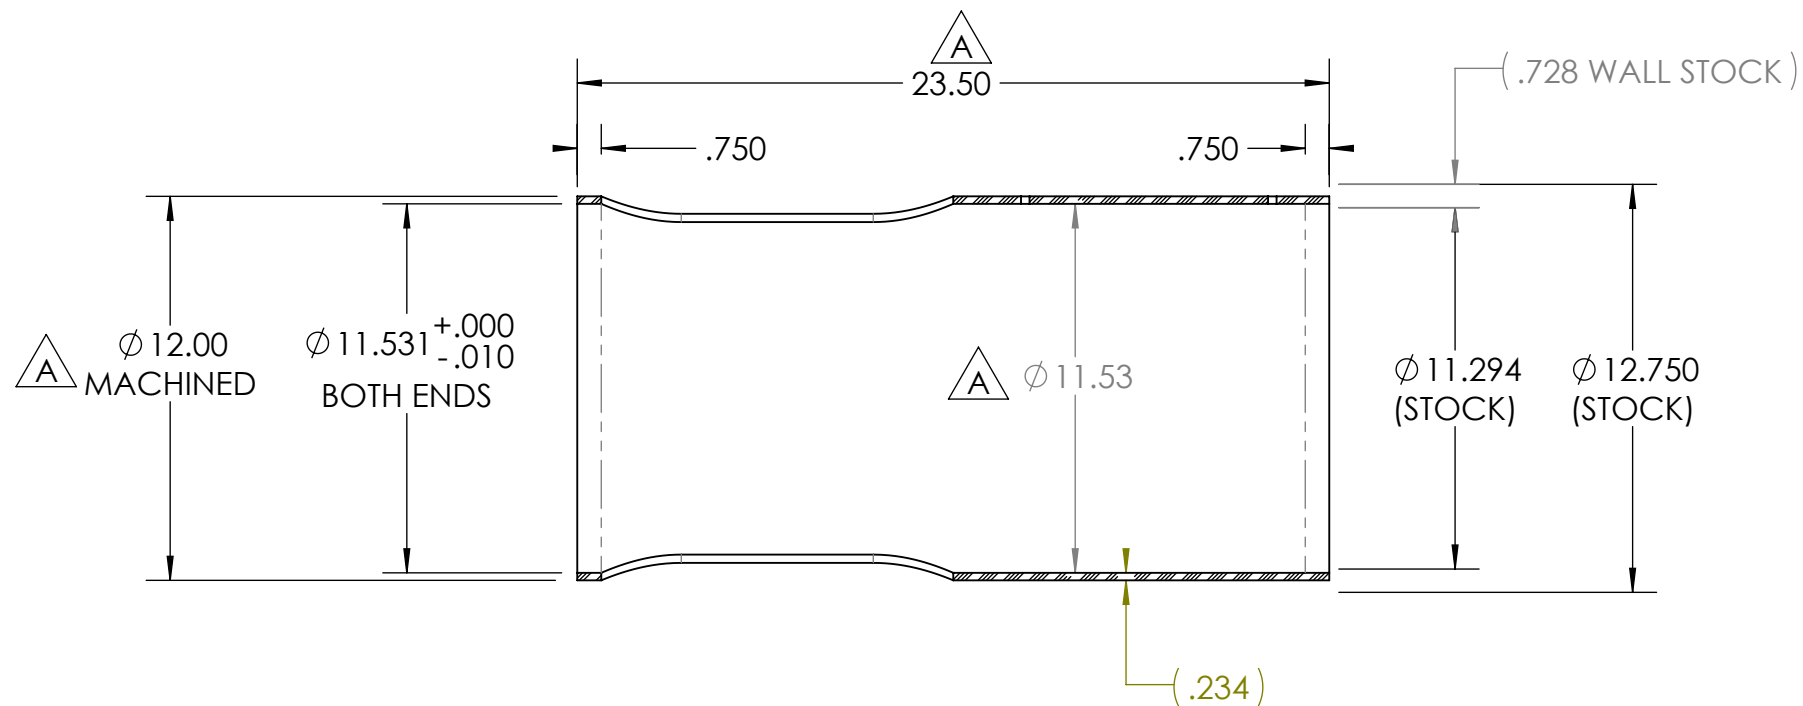
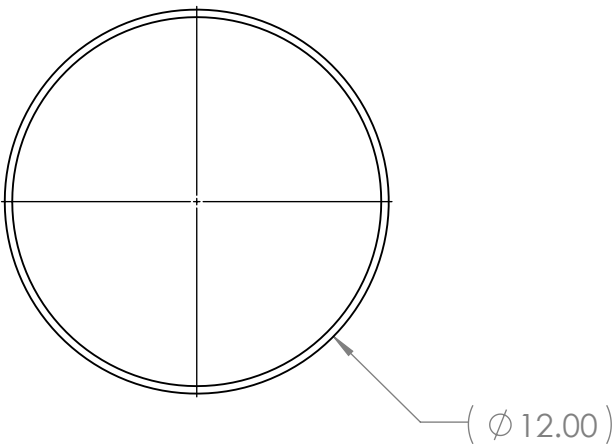


THE INFORMATION CONTAINED IN THIS DRAWING IS THE SOLE PROPERTY OF MBARI ANY REPRODUCTION IN PART OR WHOLE WITHOUT THE WRITTEN PERMISSION OF MBARI IS PROHIBITED.

REVISIONS				
INITIAL RELEASE			X/XX/01	J.E.
REVISIONS				
ZONE	REV.	DESCRIPTION	DATE	APPROVED
A3, A4, B3, B4	A	CHG DIM's .xxx to .xx	5/16/2022	J.E.

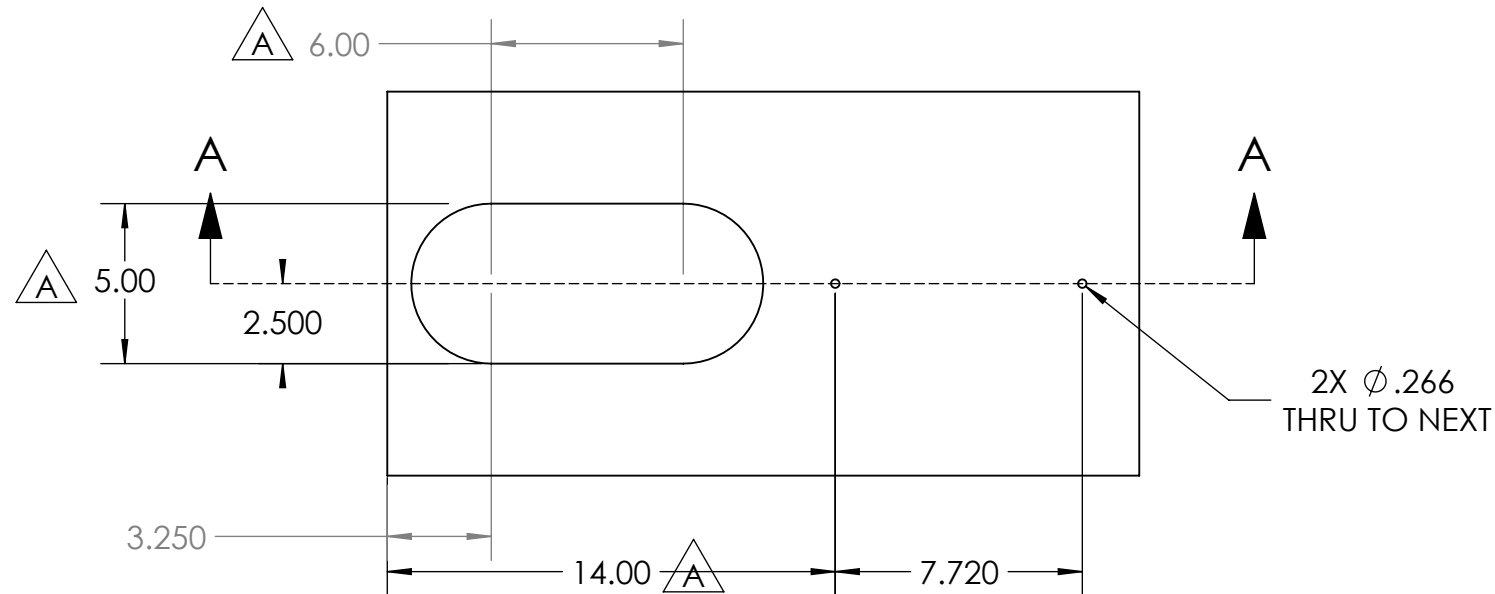

SECTION A-A
SCALE 1 : 6

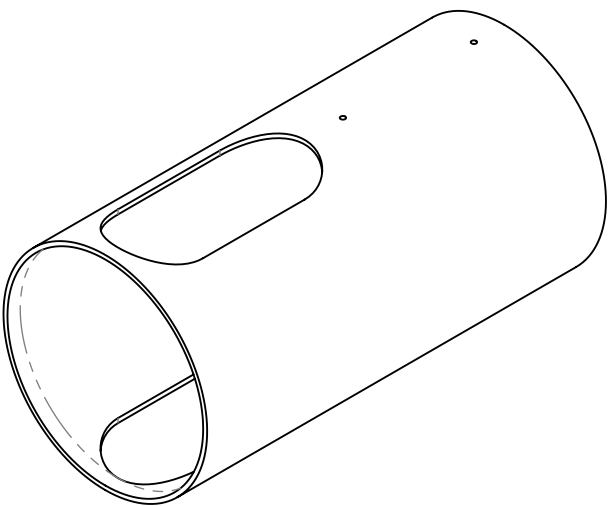

1	1	P-221402-20	PVC Pipe Shell_V1	MBARI	PVC Rigid
ITEM NO.	QTY.	Part Number	DESCRIPTION	Vendor	MATERIAL
BILL OF MATERIALS					
Shop / Q.C.		UNLESS OTHERWISE SPECIFIED TOLERANCES ARE:		APPROVALS DATE DRAWN J. ERICKSON 1/28/20 ENGINEER J. ERICKSON 1/28/20 CHECKED PROJECT NO. 701145 PROJECT PENGUIN HotSpots WEIGHT 8.438 Monterey Bay Aquarium Research Institute MBARI 7700 Sandholdt RD. Moss Landing, CA 95039 PH: (831) 775-1700 	
Inspector		1 PLACE DIM ±1/16	2 PLACE DIM ±.02	3 PLACE DIM ±.005	ANGLES ±1°
Shop Foreman		1. DIMENSIONS ARE IN INCHES 2. DIMENSION LIMITS HELD AFTER PLATING. 3. REMOVE BURRS AND SHARP EDGES .015 MAX. 4. MACHINED FILLET RADII .0150-.030.			
Engineer		5. MACHINED DIAMETERS ON A COMMON CENTERLINE CONCENTRIC WITHIN .005			
NEXT ASSY Description	NEXT ASSY Number	6. PERPENDICULARITY & PARALLELISM OF MACHINED SURFACES .002 PER INCH. MAX .012 INCHES FOR SINGLE SURFACE.			
	A-100221403				
Application		DO NOT SCALE DRAWING		SIZE B SCALE 1:8 DWG. NO. P-221402-20.DWG REV. A SHEET 1 OF 1	

7. PROJECT LIBRARY:\701145 Penguin hotspots

NOTES: (CONT. FROM TITLE BLOCK)