


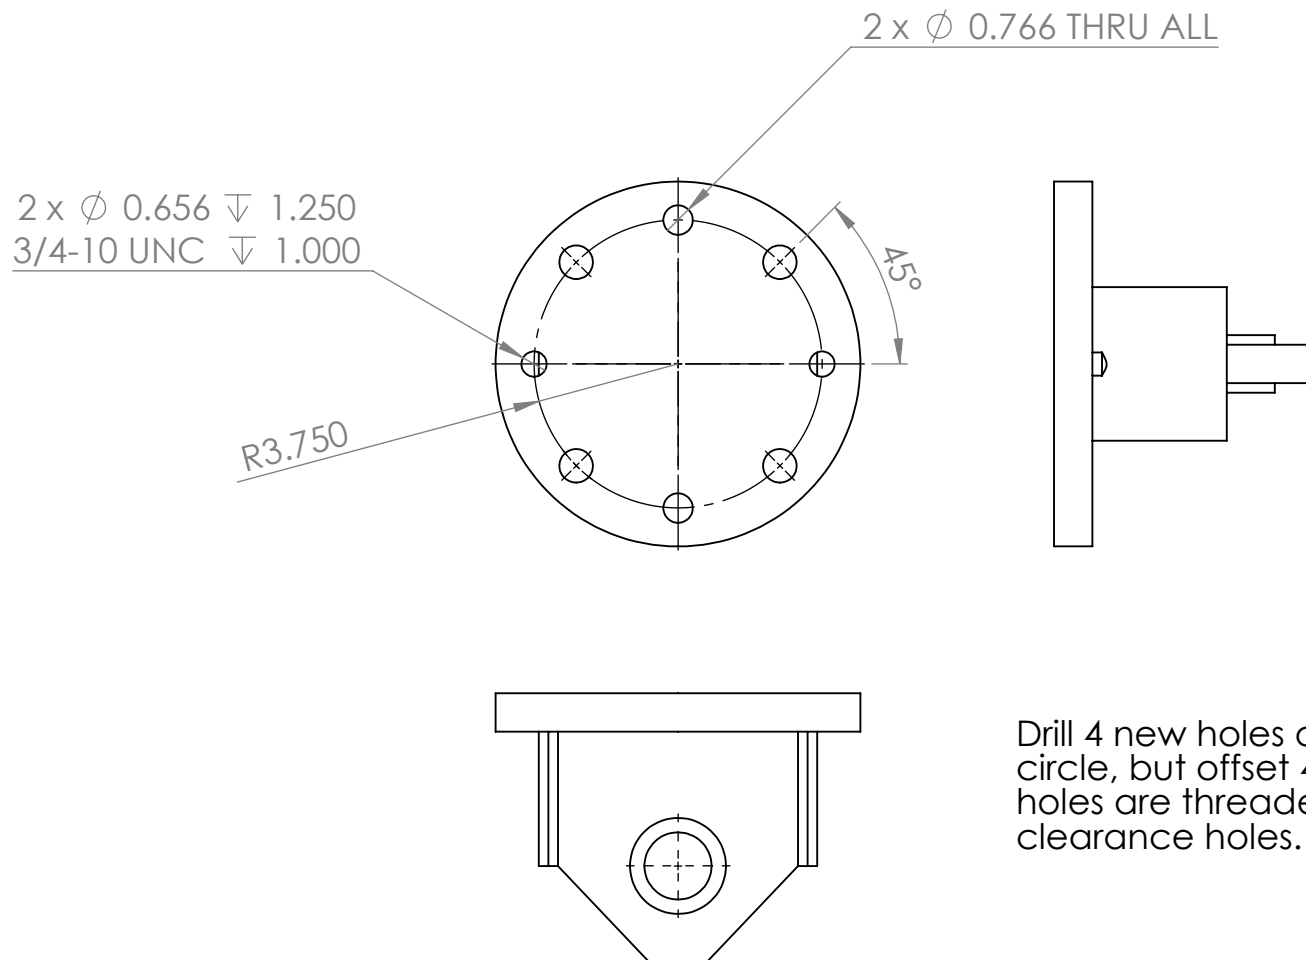

UNLESS OTHERWISE SPECIFIED TOLERANCES ARE:				APPROVALS		DATE		Monterey Bay Aquarium Research Institute MBARI 7700 Sandholdt RD. Moss Landing, CA 95039 PH: (831) 775-1700  CIMT-Oasis_bottom					
1 PLACE DIM ± 1/16	2 PLACE DIM ± .02	3 PLACE DIM ± .005	ANGLES ± 1°	DRAWN	12/23/2022								
1. DIMENSIONS ARE IN INCHES 2. DIMENSION LIMITS HELD AFTER PLATING. 3. REMOVE BURRS AND SHARP EDGES .015 MAX. 4. MACHINED FILLET RADII .0150-.030. 5. MACHINED DIAMETERS ON A COMMON CENTERLINE CONCENTRIC WITHIN .005 6. PERPENDICULARITY & PARALLELISM OF MACHINED SURFACES .002 PER INCH, MAX .012 INCHES FOR SINGLE SURFACE.				CHECKED									
				ENGINEER	Francois Cazenave								
				PROJECT NO.	900303								
				PROJECT	900303								
Vendor:								SIZE		DWG. NO.		REV.	
Material: 316 SS				WEIGHT		lb		SCALE: 1:5				SHEET 1 OF 1	