
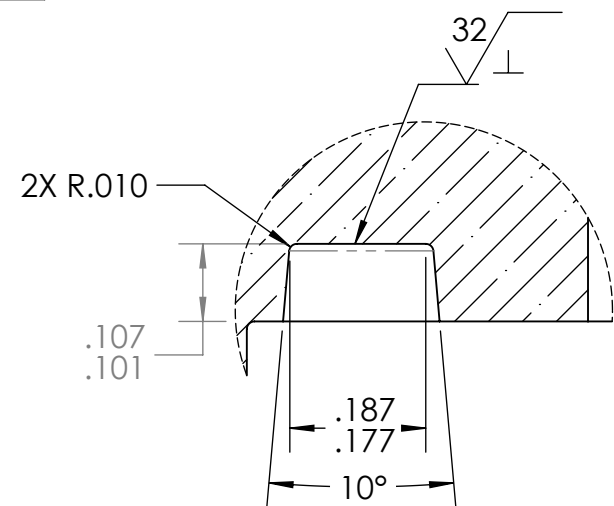
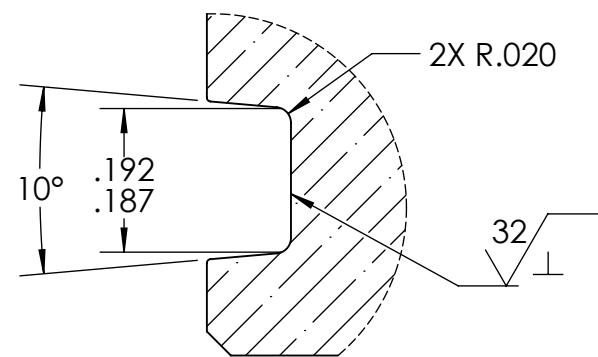
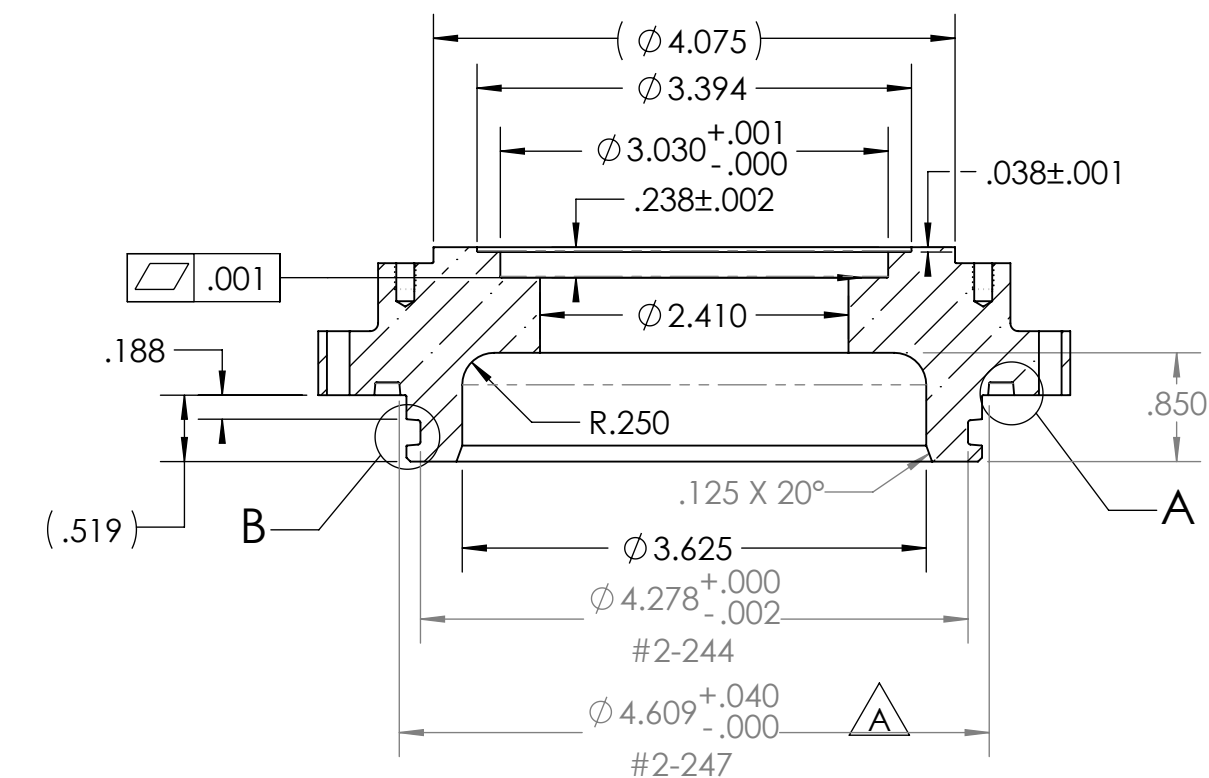
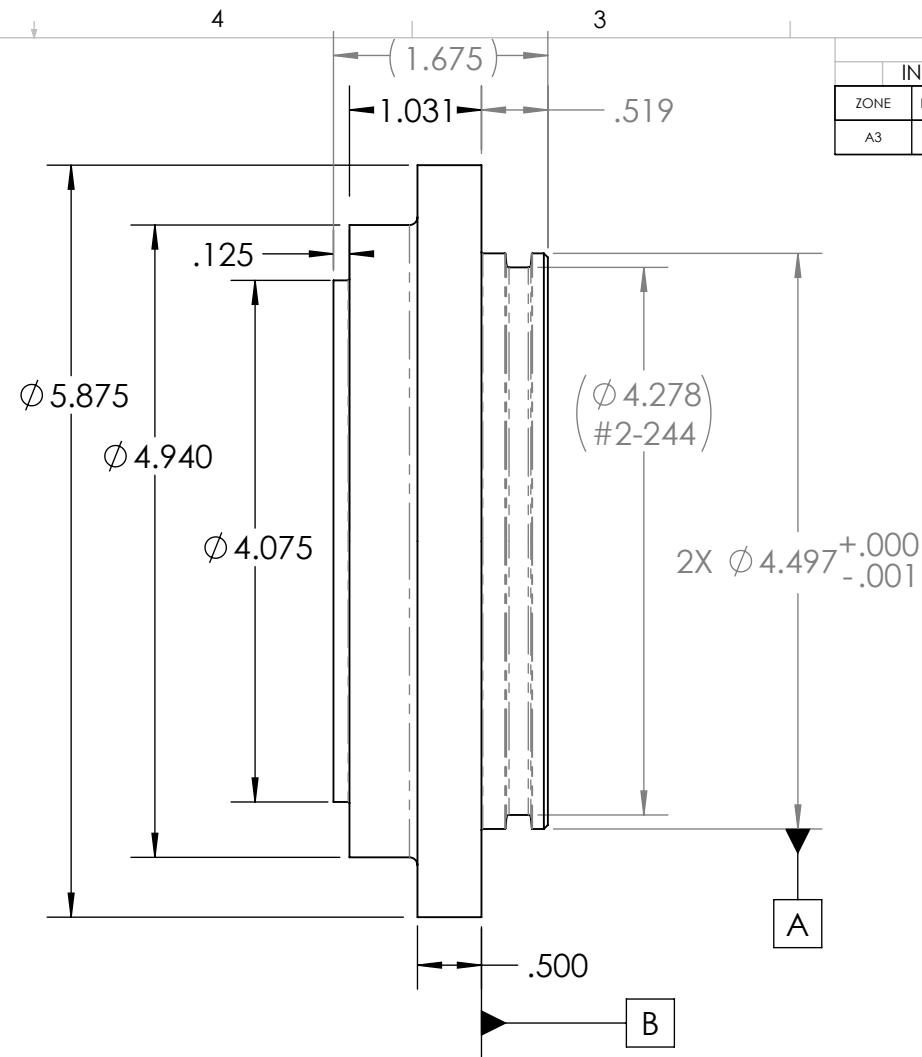



THE INFORMATION CONTAINED IN THIS DRAWING IS THE SOLE PROPERTY OF MBARI ANY REPRODUCTION IN PART OR WHOLE WITHOUT THE WRITTEN PERMISSION OF MBARI IS PROHIBITED.

REVISIONS				
	INITIAL RELEASE			X/XX/01
J.E.				
ZONE	REV.	DESCRIPTION	DATE	APPROVED
A3	A	CHG DIM CALL_OUT to 4.609 #2-247 O-RING	6/5/2019	J.E.

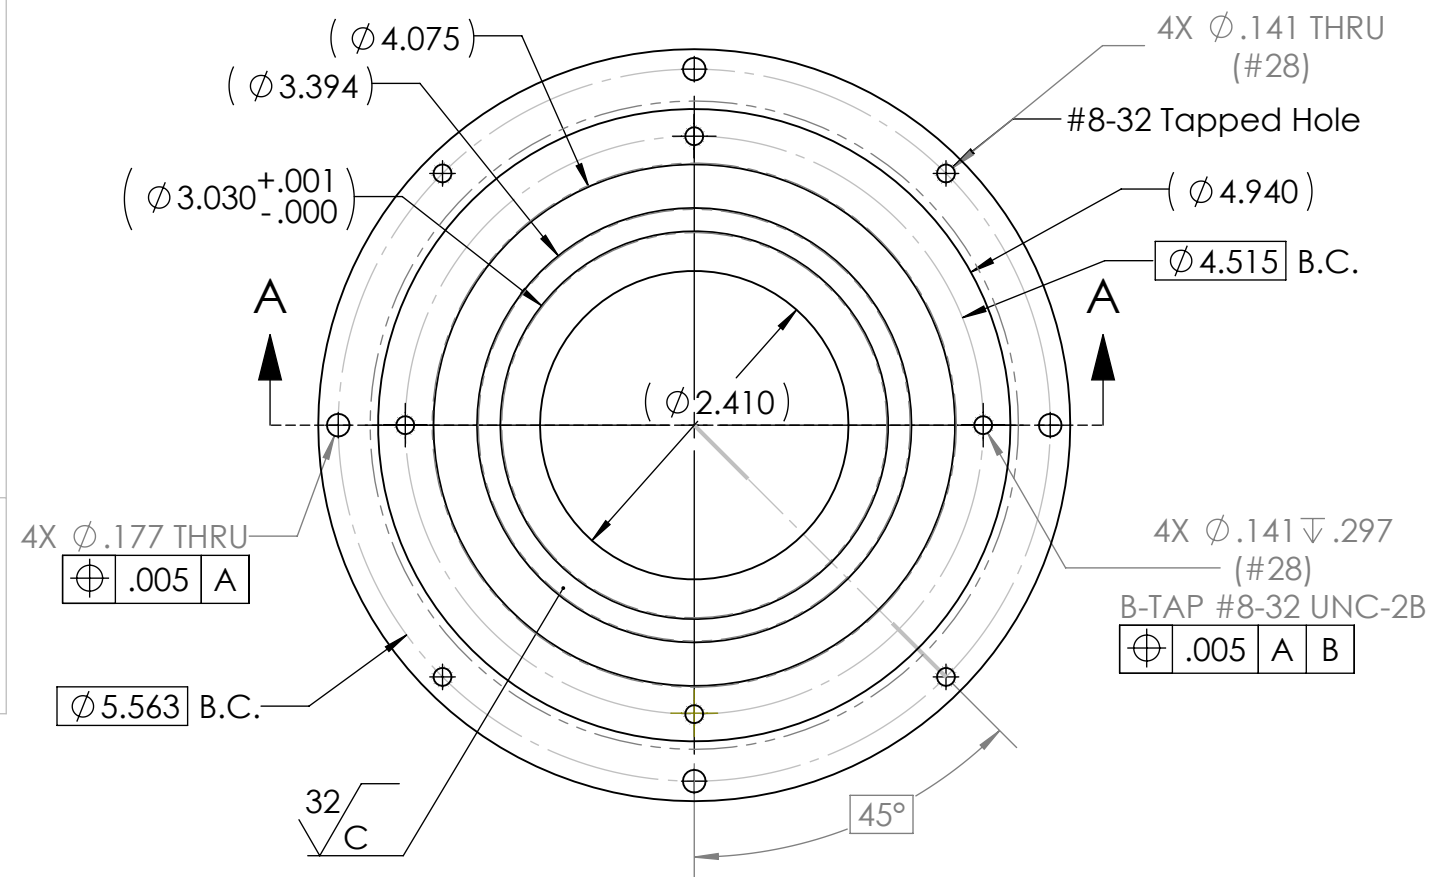

DETAIL A
SCALE 4 : 1

DETAIL B
SCALE 4 : 1

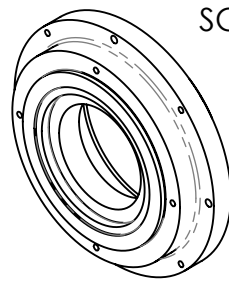

1	1	P-2018/6-19	Box Camera Window End Cap	MBARI	6AL-4V Titanium
ITEM NO.	QTY.	Part_Number	DESCRIPTION	Vendor	MATERIAL

Shop / Q.C.					UNLESS OTHERWISE SPECIFIED TOLERANCES ARE:		APPROVALS		DATE		Monterey Bay Aquarium Research Institute MBARI 7700 Sandholdt RD. Moss Landing, CA 95039 PH: (831) 775-1700 								
Inspector		1 PLACE DIM ±1/16		2 PLACE DIM ±.02		3 PLACE DIM ±.005		ANGLES ±1°		DRAWN J. ERICKSON					12/16/16				
Shop Foreman		1. DIMENSIONS ARE IN INCHES 2. DIMENSION LIMITS HELD AFTER PLATING. 3. REMOVE BURRS AND SHARP EDGES .015 MAX. 4. MACHINED FILLET RADI .0150-.030. 5. MACHINED DIAMETERS ON A COMMON CENTERLINE CONCENTRIC WITHIN .005 6. PERPENDICULARITY & PARALLELISM OF MACHINED SURFACES .002 PER INCH, MAX .012 INCHES FOR SINGLE SURFACE.													ENGINEER J. ERICKSON		12/16/16		
Engineer															CHECKED				
NEXT ASSY Description		NEXT ASSY Number		PROJECT NO. 901809															
		A-201874-16		PROJECT PIV															
Application		DO NOT SCALE DRAWING					WEIGHT		3.291										

7. PROJECT LIBRARY:\901506 DeepPIV\ME Drawings\Camera Housing\Sony Box Camera FCB-EV7320_V3

NOTES: (CONT. FROM TITLE BLOCK)