


THE INFORMATION CONTAINED IN THIS DRAWING IS THE SOLE PROPERTY OF MBARI. ANY REPRODUCTION IN PART OR WHOLE WITHOUT THE WRITTEN PERMISSION OF MBARI IS PROHIBITED.

REVISIONS				
INITIAL RELEASE			X/XX/01	J.E.
ZONE	REV.	DESCRIPTION	DATE	APPROVED
A3, B2	A	CHG Dim's to 1.125 (6 PLACES)	2/19/2021	J.E.

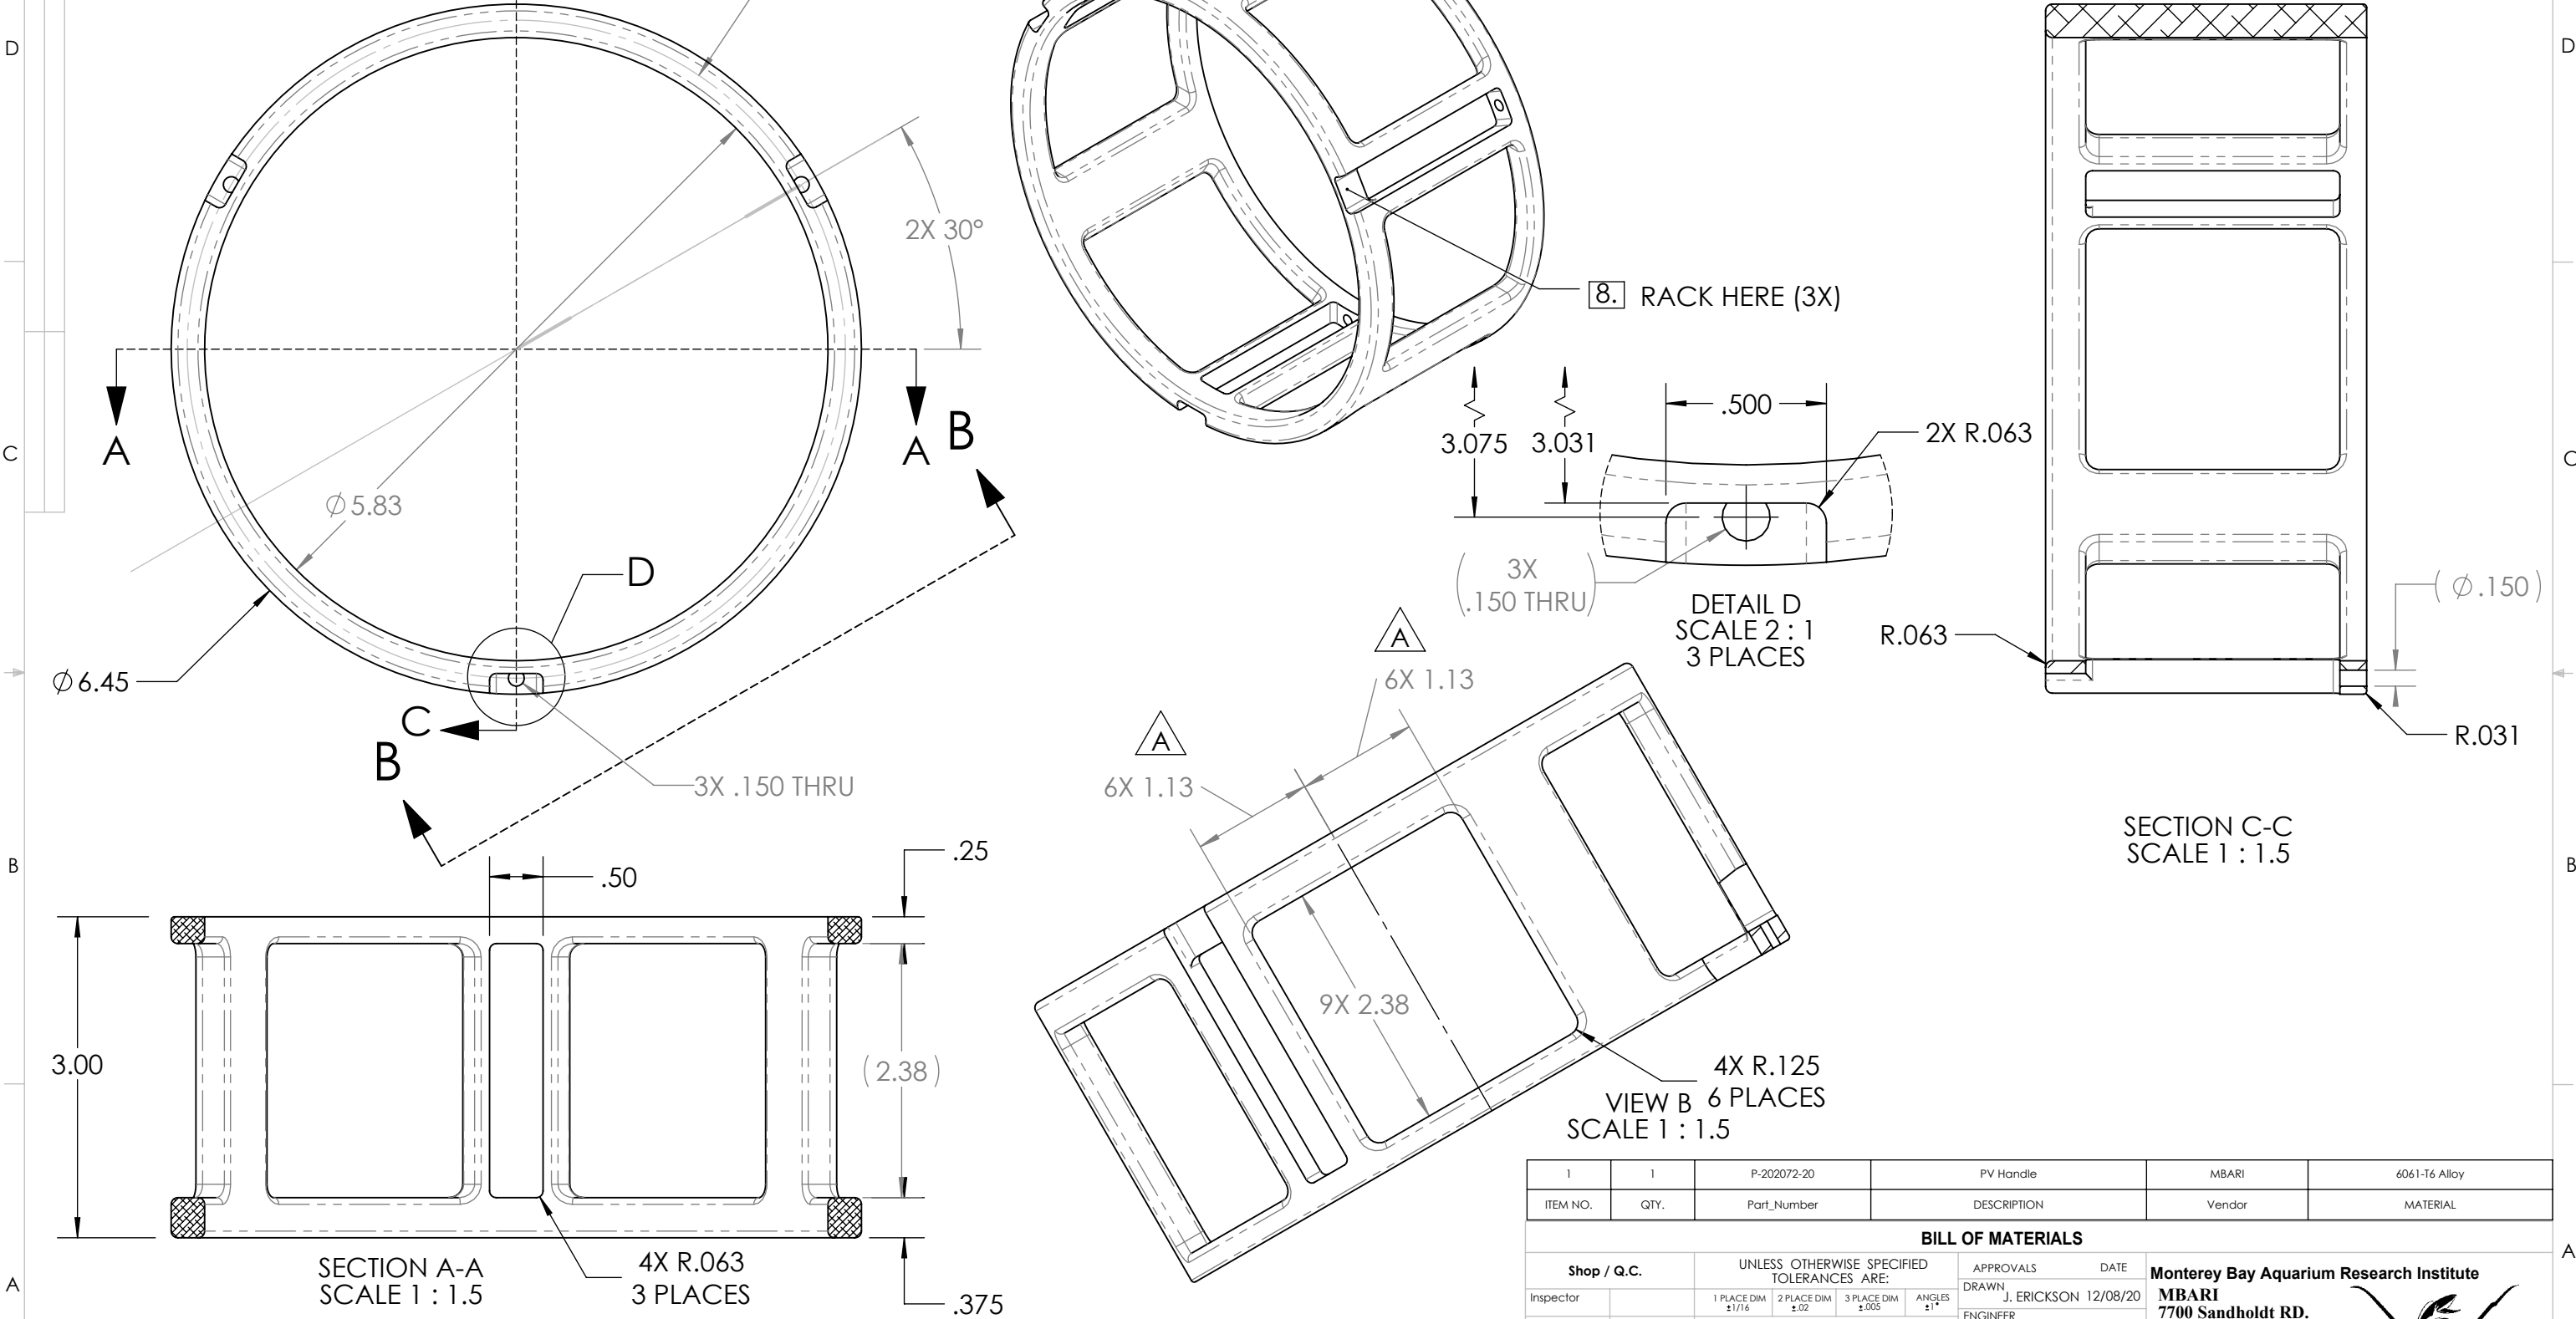

Monterey Bay Aquarium Research Institute
MBARI
7700 Sandholdt RD.
Moss Landing, CA 95039
PH: (831) 775-1700

EyeRis - LRAUV

PV Handle

P-202072-20.DWG

SIZE B

DWG. NO.

SCALE

1:2

CAD

FILE: MECH ENG ON TORNADO

SHEET


1 OF 2

REV.


A

THE INFORMATION CONTAINED IN THIS DRAWING IS THE SOLE PROPERTY OF MBARI ANY REPRODUCTION IN PART OR WHOLE WITHOUT THE WRITTEN PERMISSION OF MBARI IS PROHIBITED.

REVISIONS			
REV.	DESCRIPTION	DATE	APPROVED
	INITIAL RELEASE	X/XX/00	J.E.

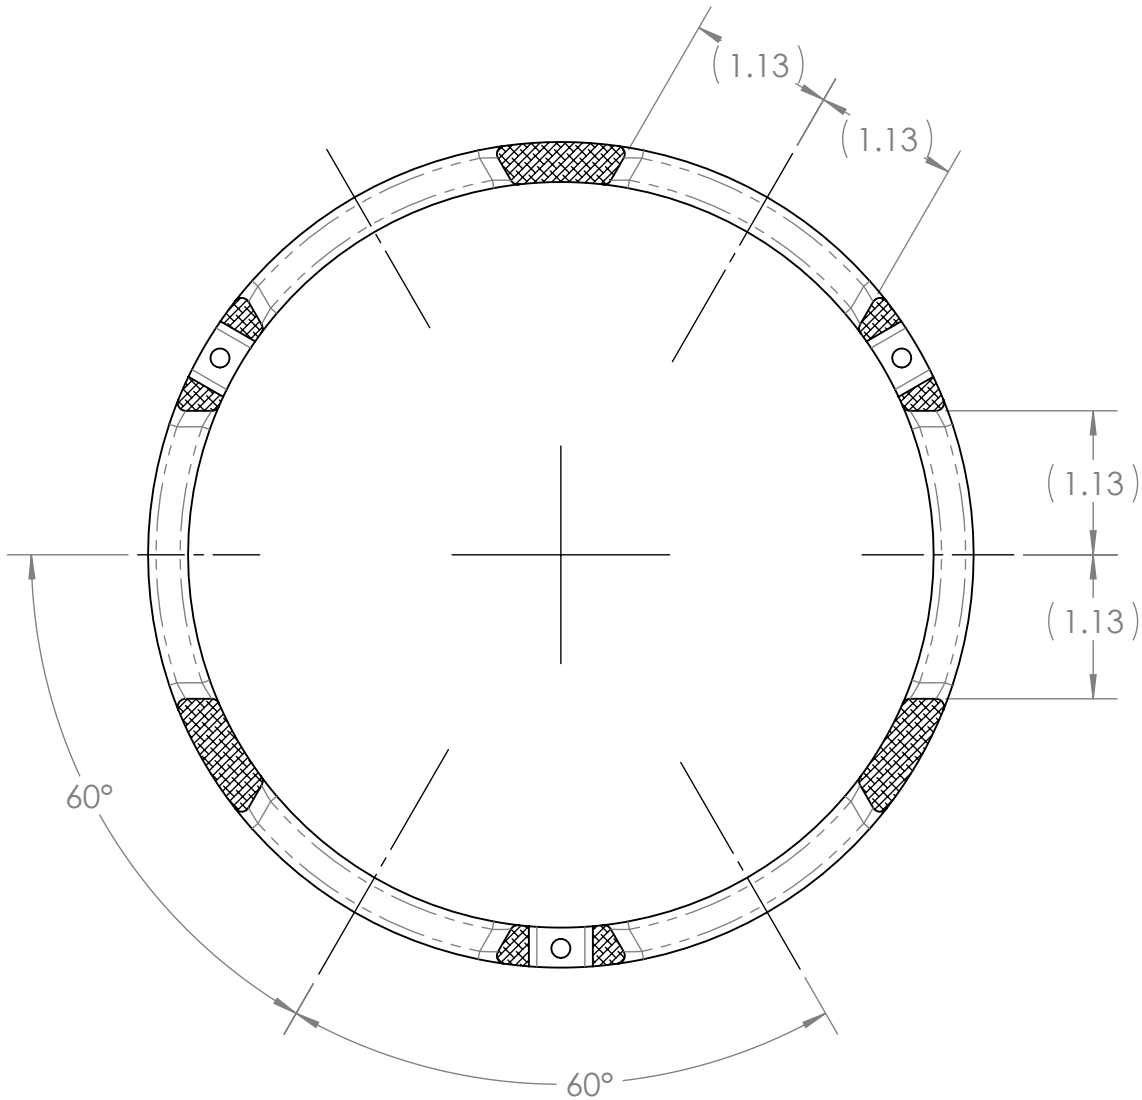

SECTION E-E
SCALE 1 : 1.5

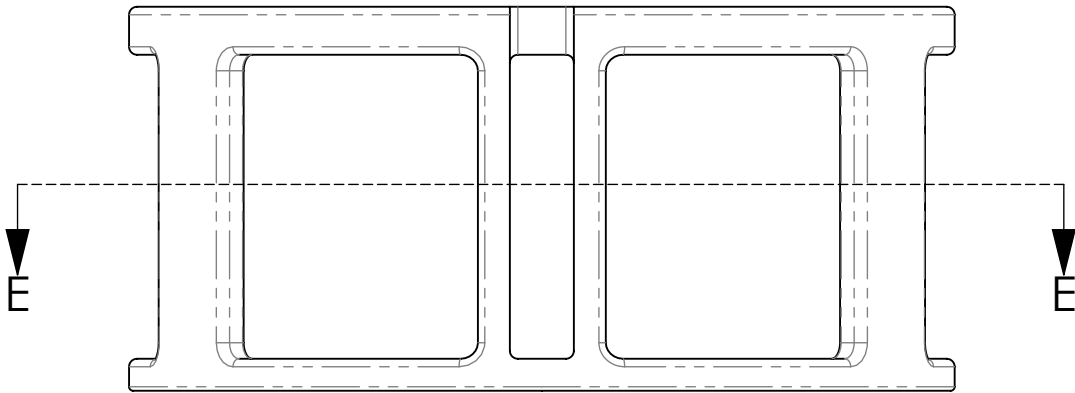

7. PROJECT LIBRARY:\800139.EyeRIS\EyeRIS.Drawings\Project.ME.Dwgs\LRAUV\1500m

NOTES: (CONT. FROM TITLE BLOCK)

ITEM NO.	QTY.	PART NO.	DESCRIPTION	VENDOR	MATERIAL SPECIFICATION
BILL OF MATERIALS					
Shop / Q.C.		UNLESS OTHERWISE SPECIFIED TOLERANCES ARE:		APPROVALS DATE	
Inspector		1 PLACE DIM ±1/16	2 PLACE DIM ±.02	3 PLACE DIM ±.005	ANGLES ±1°
Shop Foreman		1. DIMENSIONS ARE IN INCHES 2. DIMENSION LIMITS HELD AFTER PLATING. 3. REMOVE BURRS AND SHARP EDGES .015 MAX. 4. MACHINED FILLET RADII .0150-.030.			DRAWN J. ERICKSON 12/08/20
Engineer					ENGINEER J. ERICKSON 12/08/20
NEXT ASSY Description	NEXT ASSY Number	5. MACHINED DIAMETERS ON A COMMON CENTERLINE CONCENTRIC WITHIN .005 6. PERPENDICULARITY & PARALLELISM OF MACHINED SURFACES .002 PER INCH. MAX. .012 INCHES FOR SINGLE SURFACE.			CHECKED
					PROJECT NO. 800139
					PROJECT EyeRis
					SIZE B DWG. NO. REV.
					SCALE 1:2 CAD FILE: MECH ENG ON TORNADO SHEET 2 OF 2
Application		DO NOT SCALE DRAWING		WEIGHT 0.631 lb.	

Monterey Bay Aquarium Research Institute

MBARI

7700 Sandholdt RD.

Moss Landing, CA 95039

PH: (831) 775-1700



EYERIS - LRAUV

PV Handle

P-202072-20.DWG