



THE INFORMATION CONTAINED IN THIS DRAWING IS THE SOLE PROPERTY OF MBARI ANY REPRODUCTION IN PART OR WHOLE WITHOUT THE WRITTEN PERMISSION OF MBARI IS PROHIBITED.

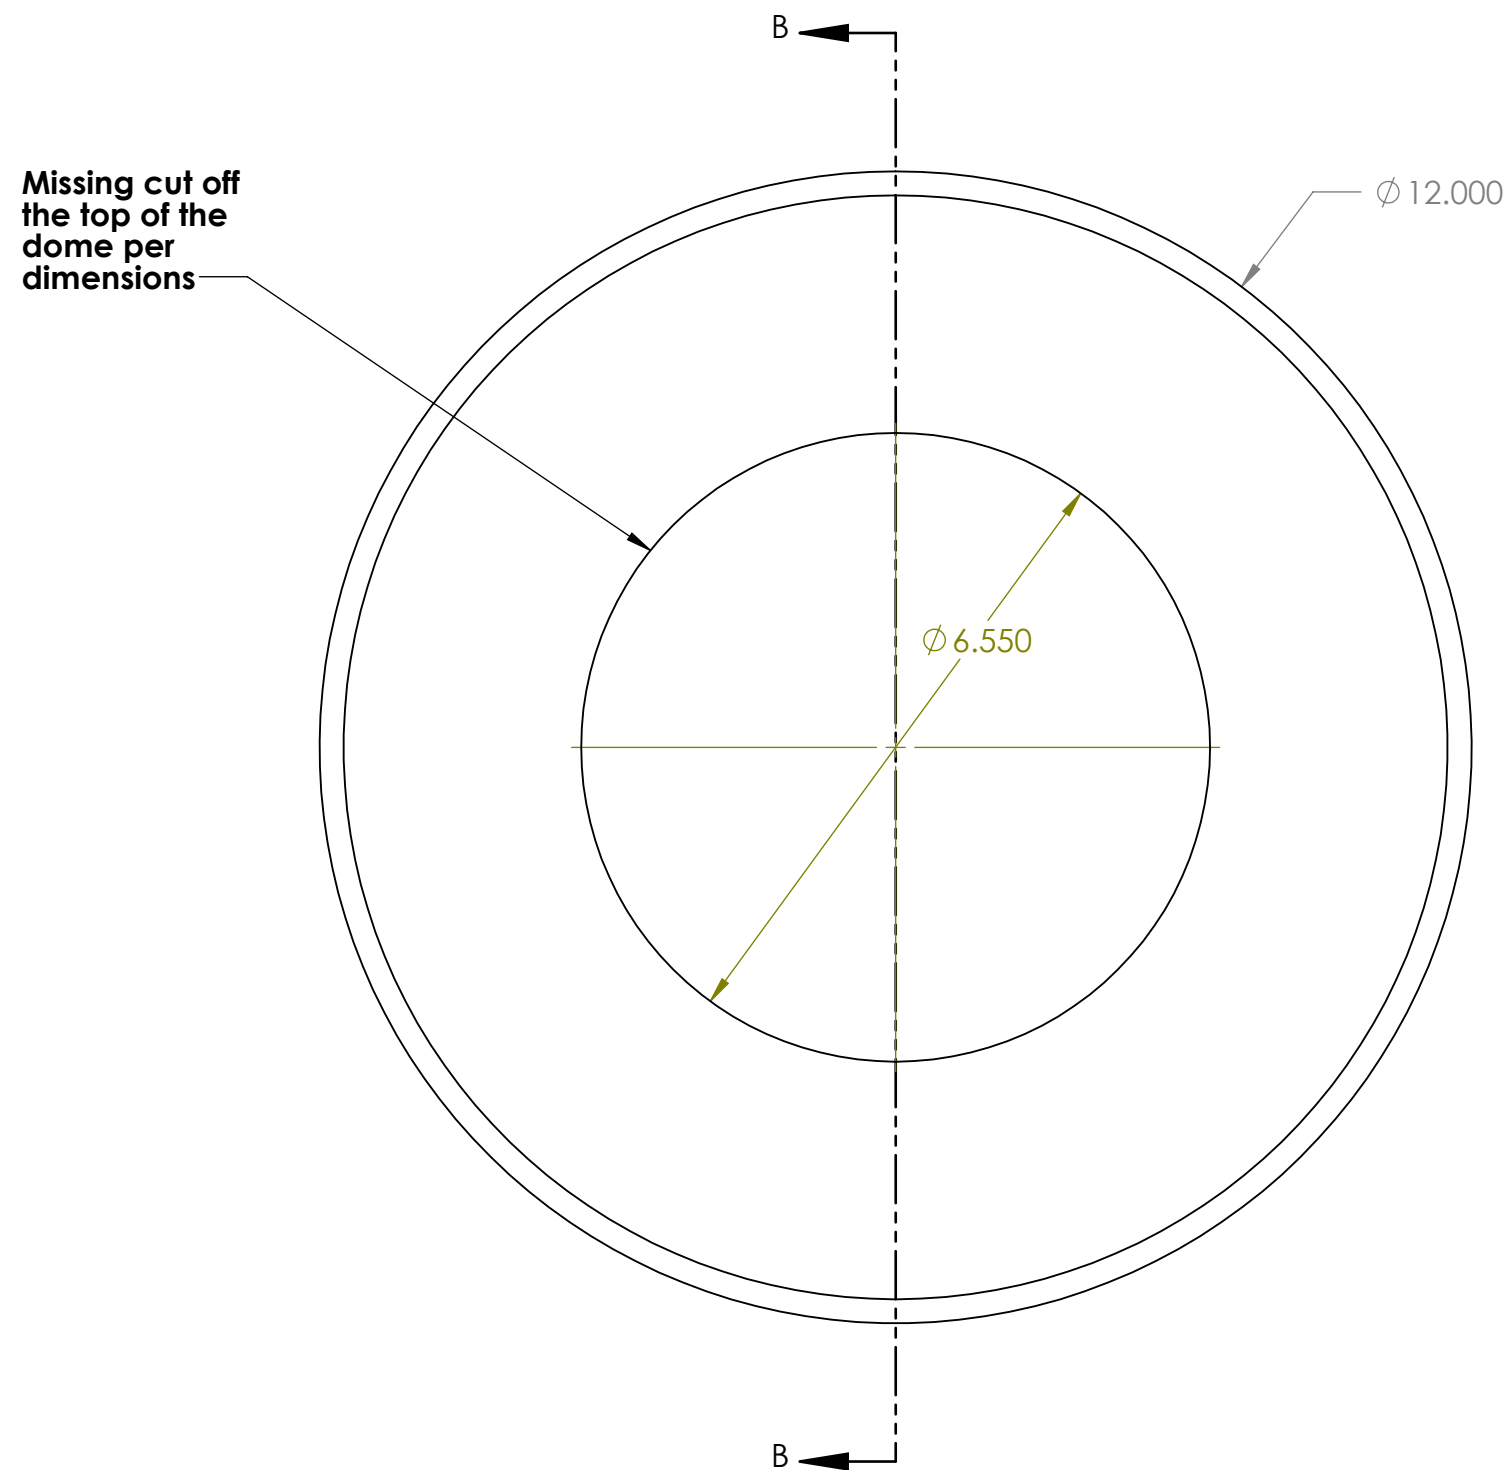

FILE LOCATION:
\\atlas\ProjectLibrary\800139.EyeRIS\EyeRIS.Drawings\
Project.ME.Dwgs\LRAUV\
P-800139-112-042621-Polycarbonate-Dome-V4

REVISIONS				
ZONE	REV.	DESCRIPTION	DATE	APPROVED
ALL	A	Initial Revision	4/20/2021	P.R.

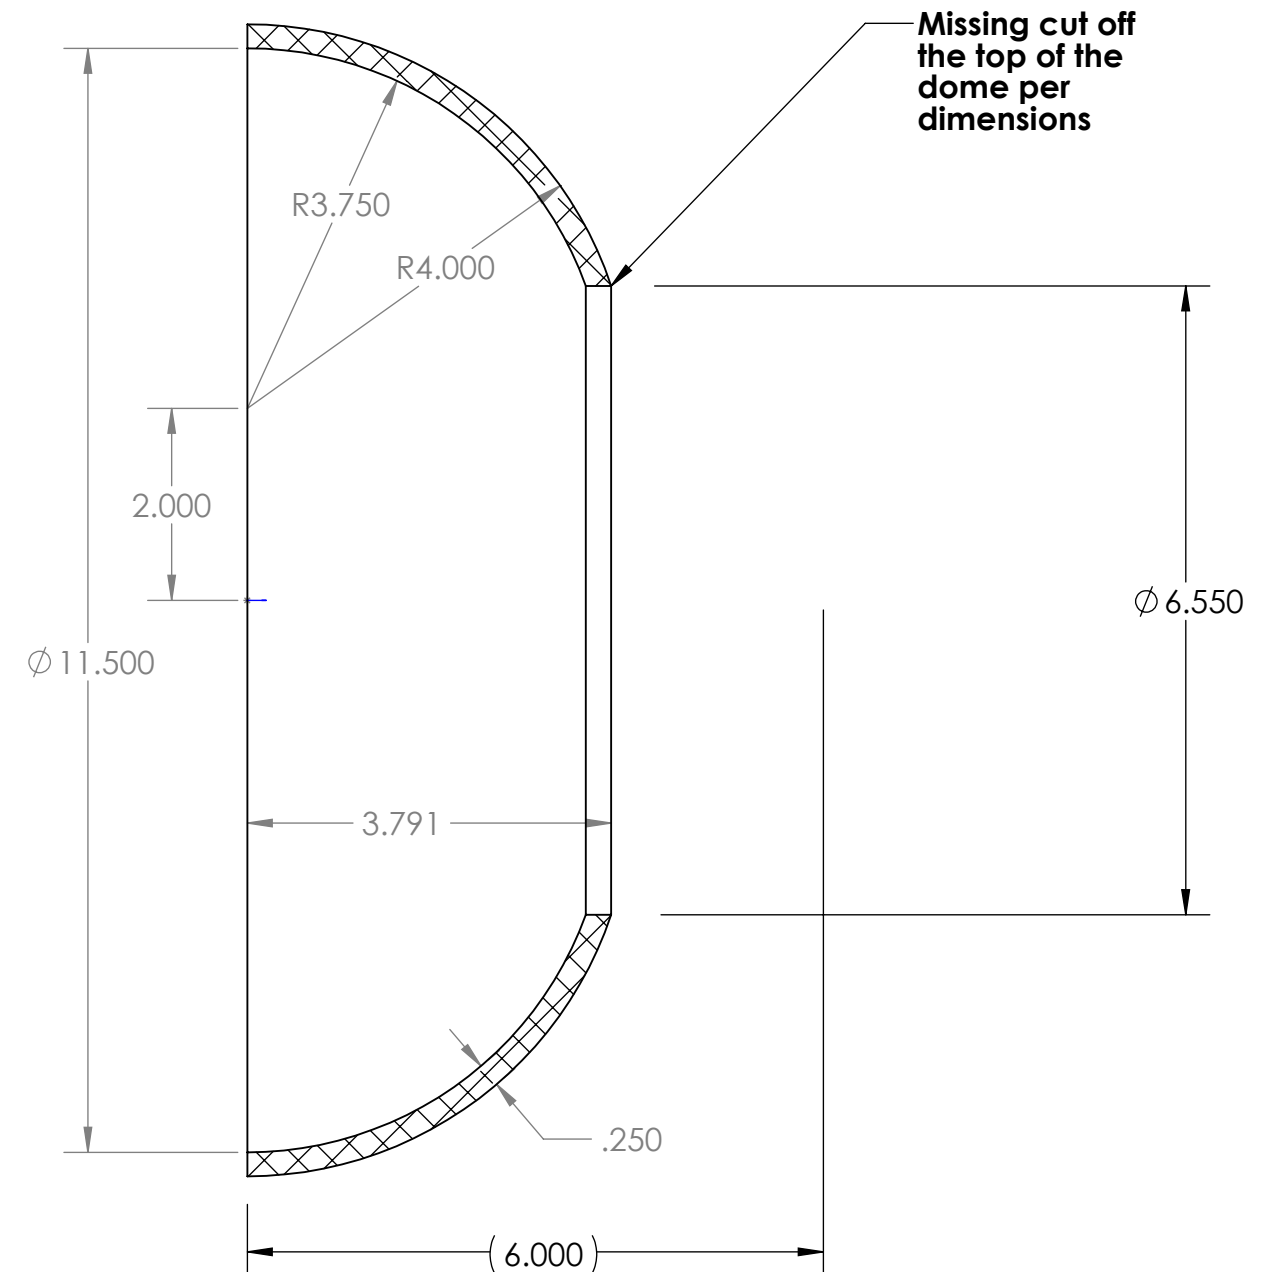

SECTION B-B
SCALE 1 : 2

BILL OF MATERIALS							
Shop / Q.C.		UNLESS OTHERWISE SPECIFIED TOLERANCES ARE:			APPROVALS DATE		Monterey Bay Aquarium Research Institute
Inspector		1 PLACE DIM $\pm .016$	2 PLACE DIM $\pm .02$	3 PLACE DIM $\pm .003$	ANGLES $\pm 1'$	DRAWN P. Roberts	MBARI
Shop Foreman		1. DIMENSIONS ARE IN INCHES 2. DIMENSION LIMITS HELD AFTER PLATING. 3. REMOVE BURRS AND SHARP EDGES .015 MAX. 4. MACHINED FILLET RADII .0150-.030. 5. MACHINED DIAMETERS ON A COMMON CENTERLINE CONCENTRIC WITHIN .005 6. PERPENDICULARITY & PARALLELISM OF MACHINED SURFACES .002 PER INCH. MAX .012 INCHES FOR SINGLE SURFACE.				ENGINEER P. ROBERTS	7700 Sandholdt RD.
Engineer						CHECKED P. ROBERTS	Moss Landing, CA 95039
NEXT ASSY Description	NEXT ASSY Number					PROJECT NO.	PH: (831) 775-1700
		PROJECT	800139			P-800139-112-042621-Polycarbonate-Dome-V4	
		WEIGHT	EyeRIS	SIZE B	DWG. NO.	REV.	
Application		DO NOT SCALE DRAWING		SCALE	800139-112-092120	SHEET 1 OF 1	