


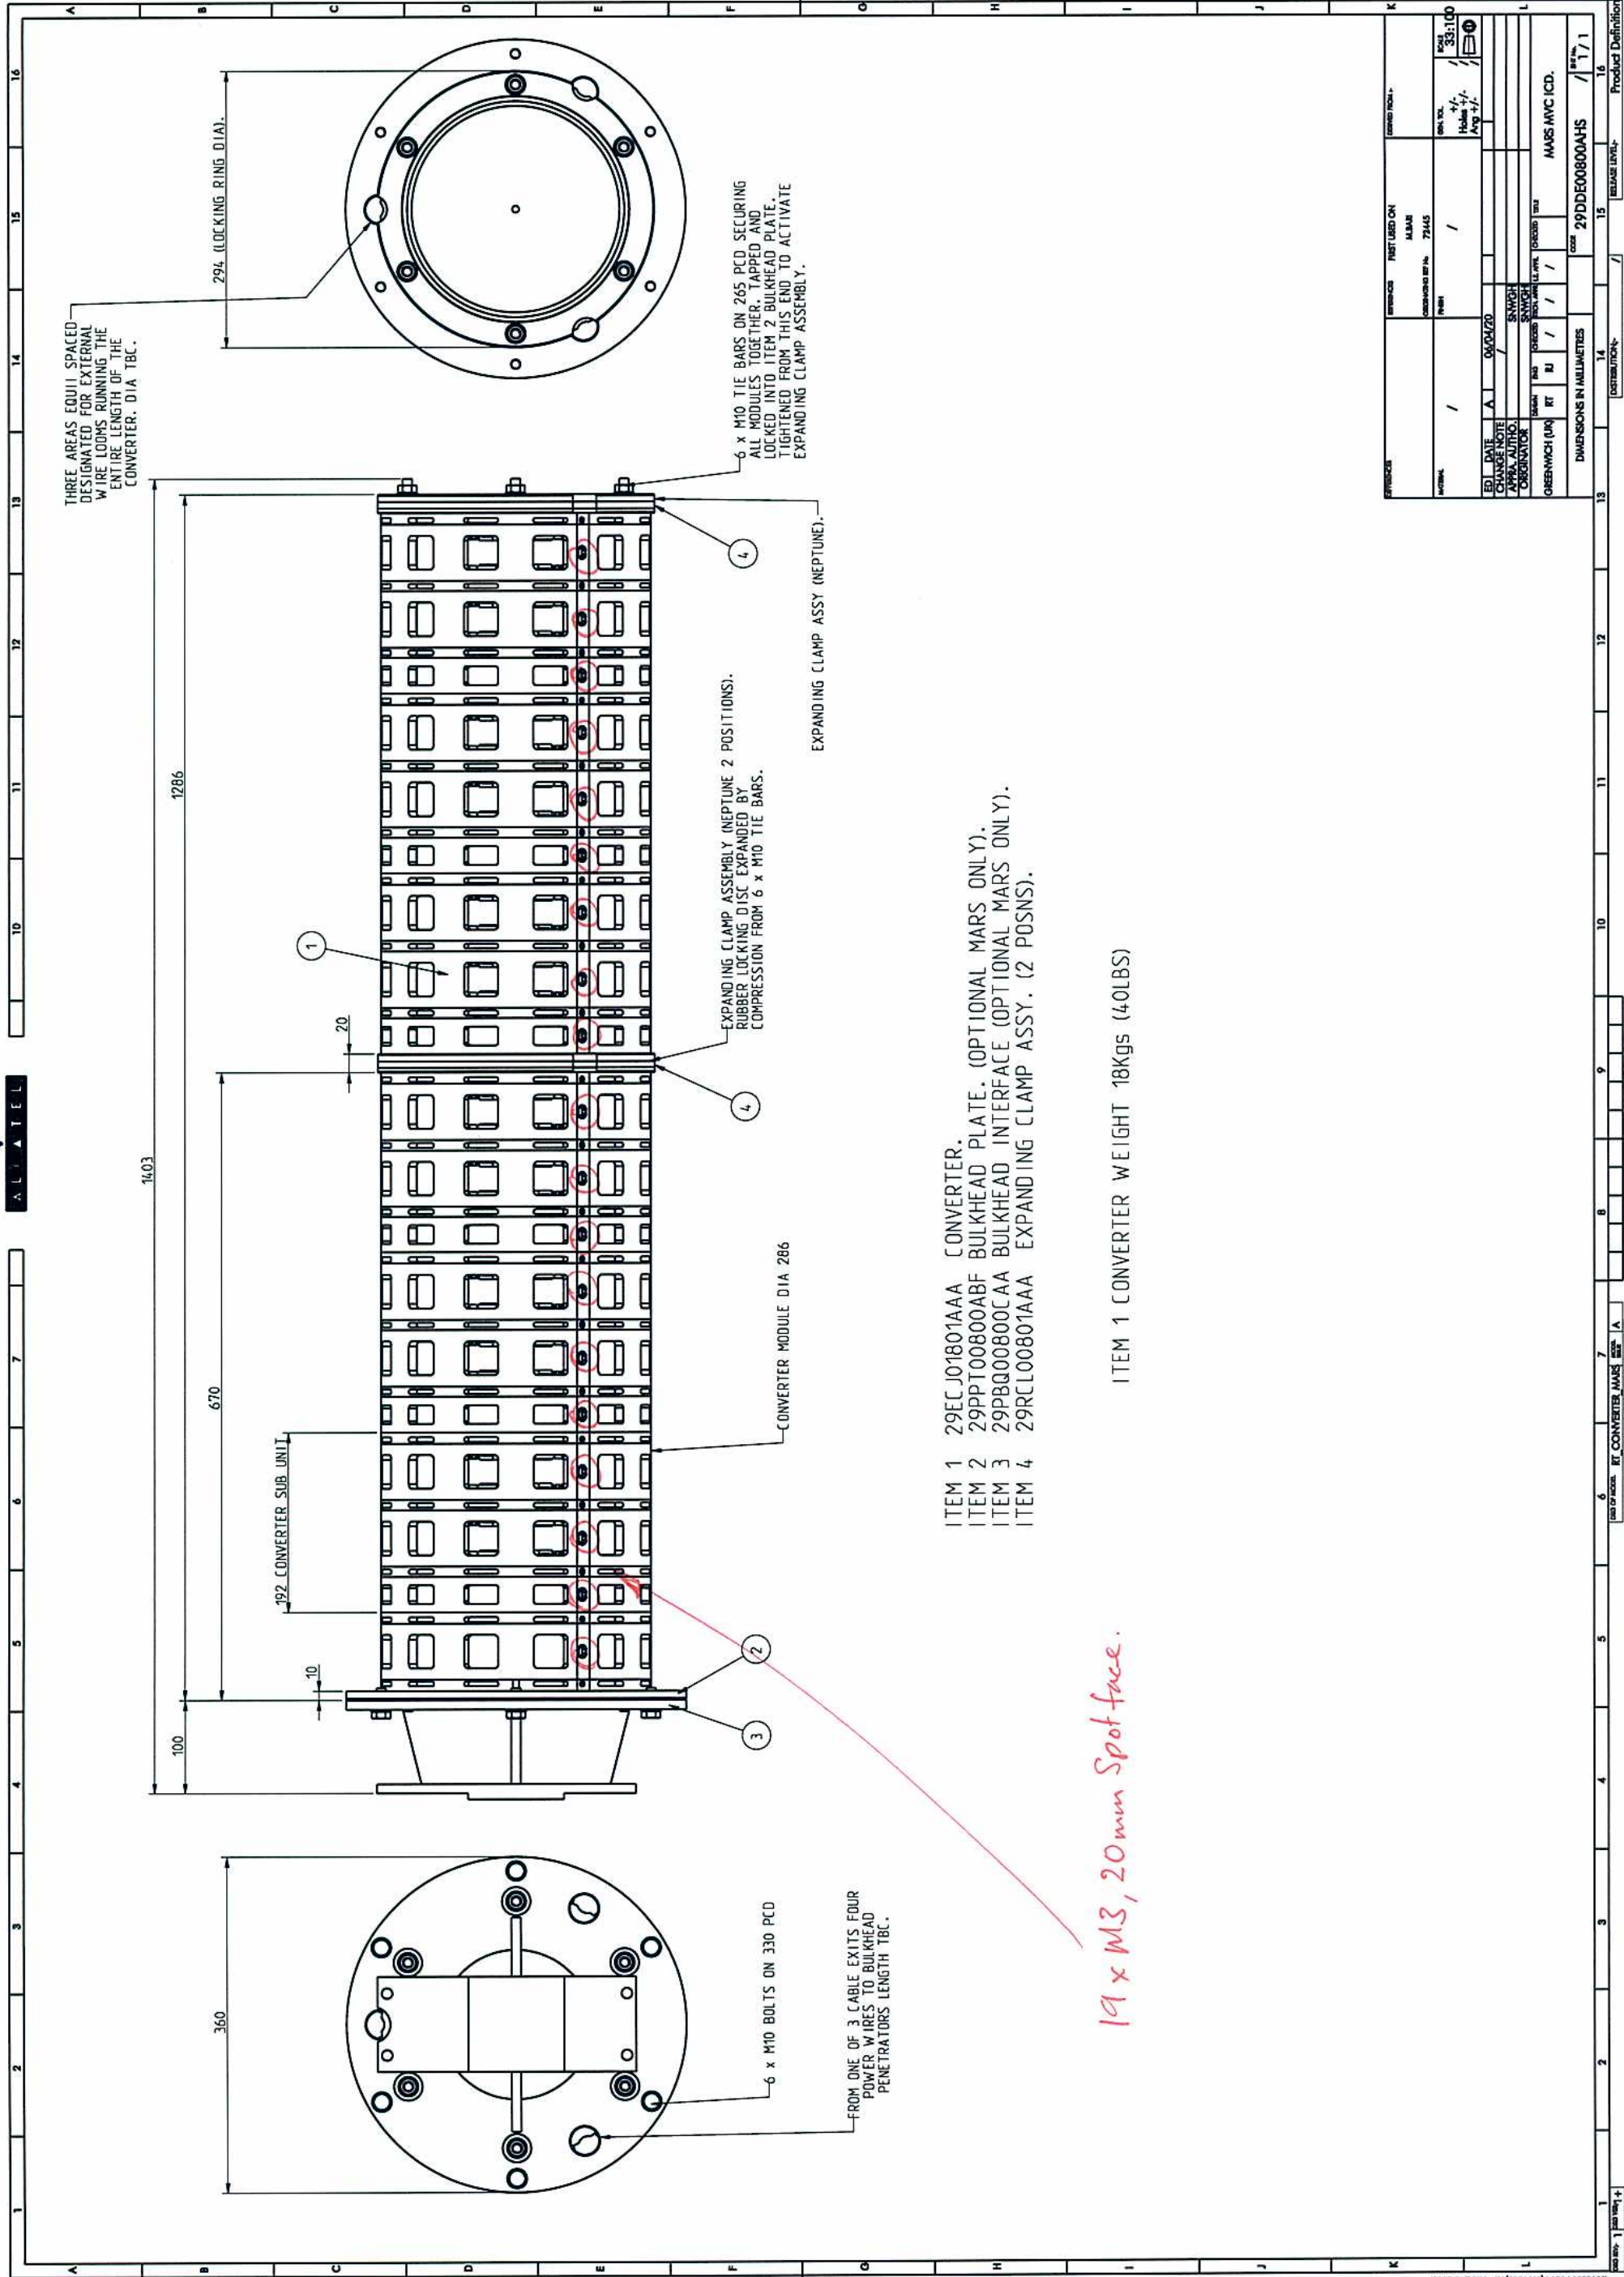

- ITEM 1 29ECJ01801AAA CONVERTER.
- ITEM 2 29PPT00800ABF BULKHEAD PLATE. (OPTIONAL MARS ONLY).
- ITEM 3 29PBQ00800CAA BULKHEAD INTERFACE (OPTIONAL MARS ONLY).
- ITEM 4 29RCL00801AAA EXPANDING CLAMP ASSY. (2 POSNS).

ITEM 1 CONVERTER WEIGHT 18Kgs (40LBS)

19 x M3, 20mm Spot-face.

