


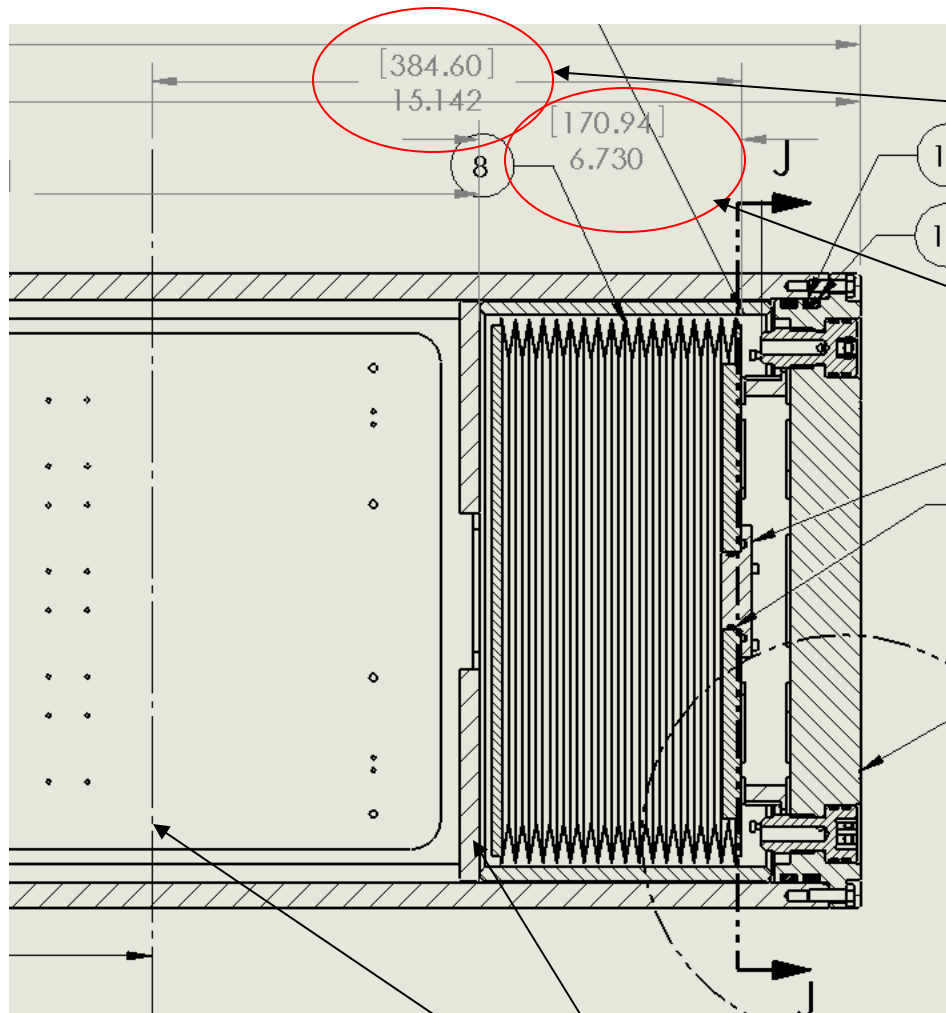

Actual max bellows
extension under vacuum
(measured from bellows
base)

Original max bellows
extension under vacuum
(measured from bellows
base)

Original stop location

Actual stop location under
vacuum