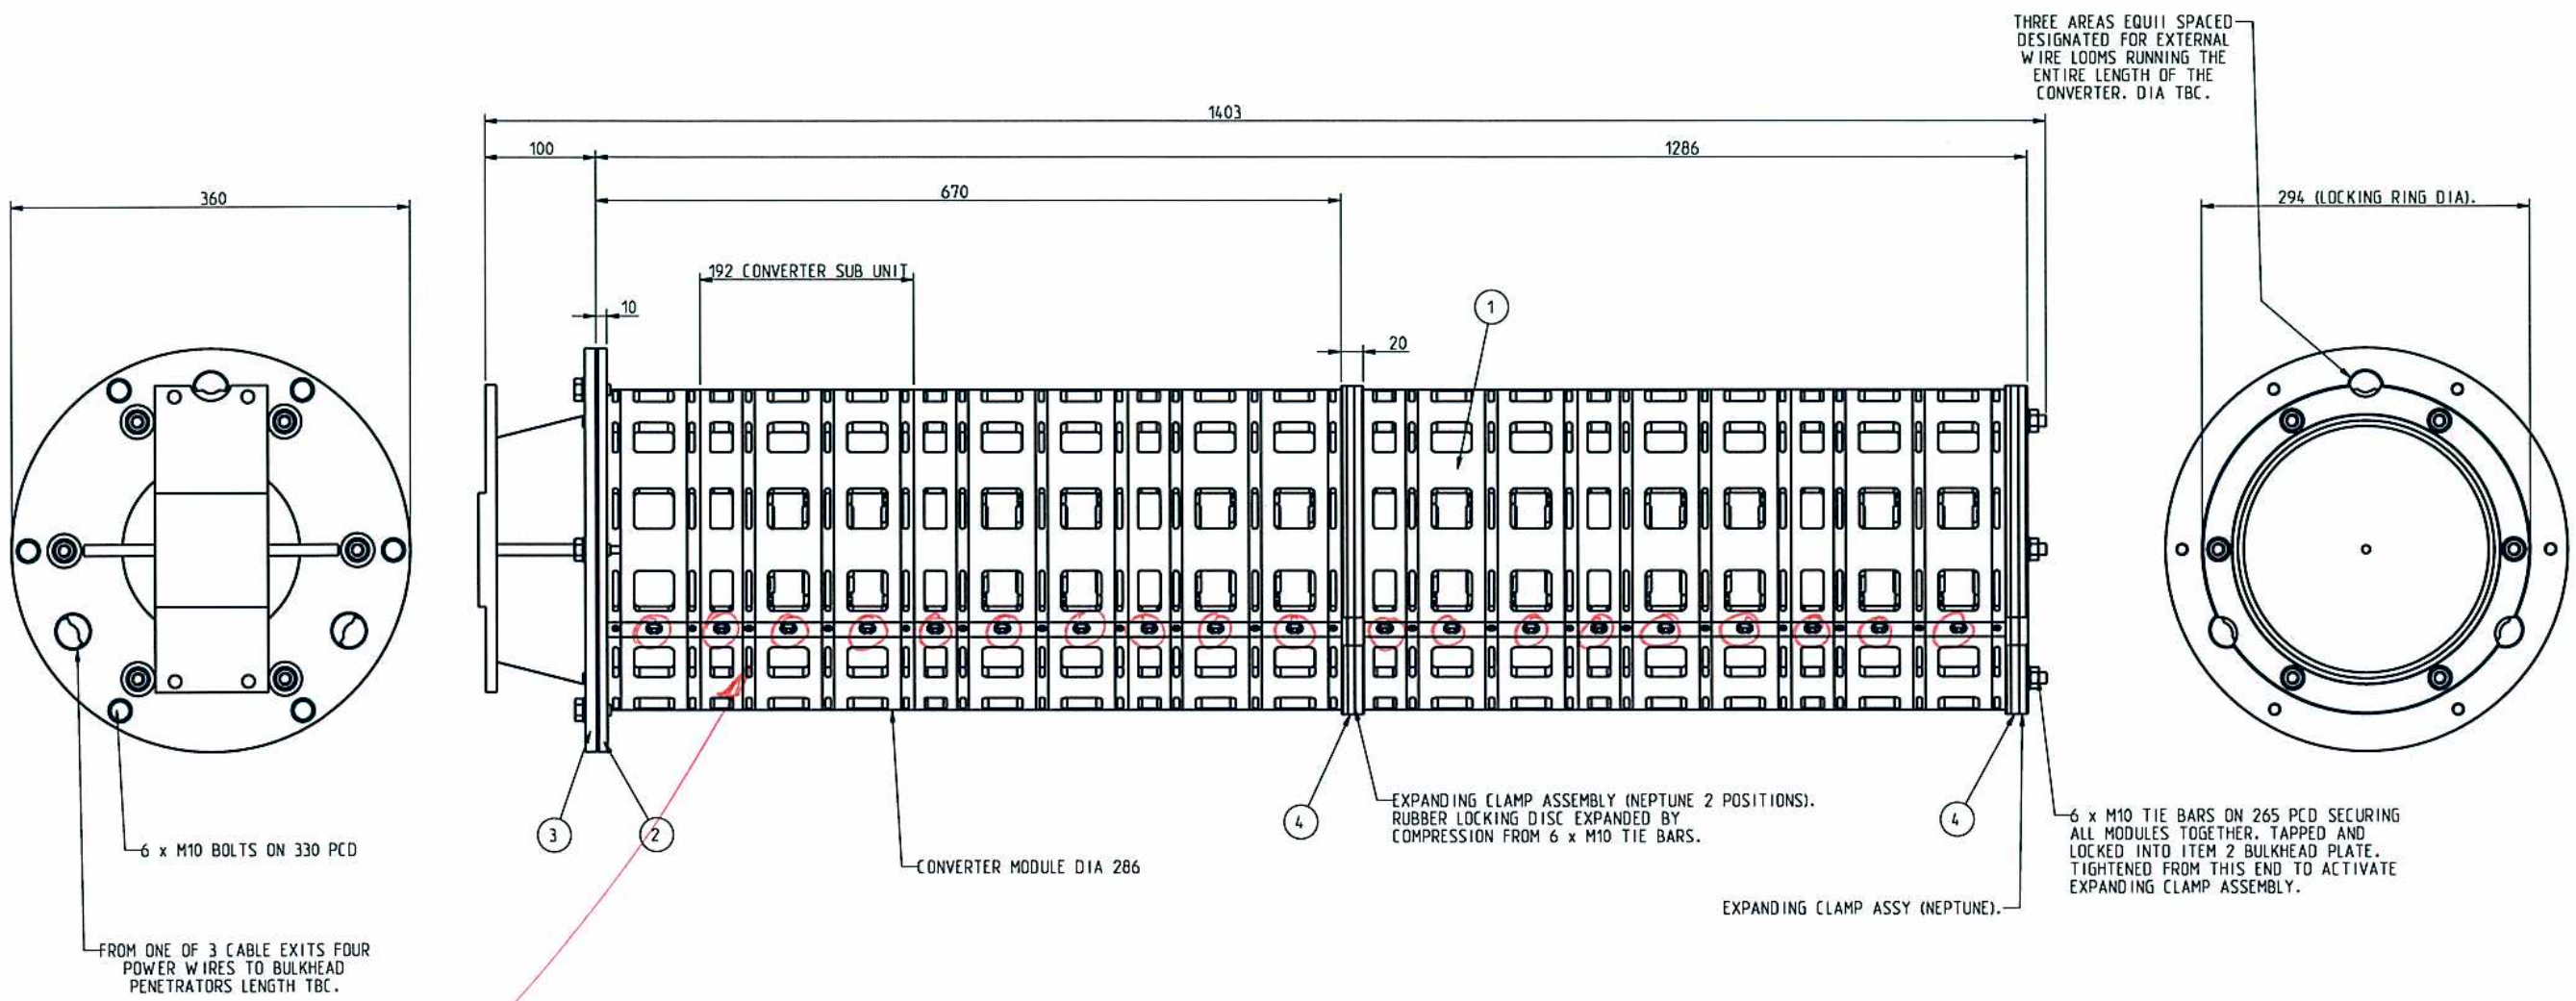

ITEM 1 29ECJ01801AAA CONVERTER.
ITEM 2 29PPT00800ABF BULKHEAD PLATE. (OPTIONAL MARS ONLY).
ITEM 3 29PBQ00800CAA BULKHEAD INTERFACE (OPTIONAL MARS ONLY).
ITEM 4 29RCL00801AAA EXPANDING CLAMP ASSY. (2 POSNS).

19 x M3, 20mm Spot face.

ITEM 1 CONVERTER WEIGHT 18Kgs (40LBS)

REFERENCES	REFERENCES FIRST USED ON M.BAR ORIGINATING REF No 72445		DERIVED FROM :-
MATERIAL /	FINISH /	GEN. TOL. +/- / Holes +/- / Ang +/- /	SCALE 33:100
ED DATE A 06/04/20			
CHANGE NOTE /			
APPRA. AUTHO. SNWGH			
ORIGINATOR SNWGH			
GREENWICH (UK) DRAWN RT ENG RJ CHECKED / TECH. APPR. / LE. APPR. / CHECKED	TITLE MARS MVC ICD.		
DIMENSIONS IN MILLIMETRES	CODE 29DDE00800AHS	/ REF No. 1/1	

DWG REV:- 1 DWG VER:- 1+ | DWG OF MODEL RT_CONVERTER_MARS MODEL REF A | DISTRIBUTION:- / | RELEASE LEVEL:- Product Definition

© 2005 ALCATEL All rights reserved. Posting on or copying of this document, use and communication of its contents is not permitted without written authorisation from ALCATEL.

1AA 00014 0014 (1999/03) A1 - FRONT 20031