

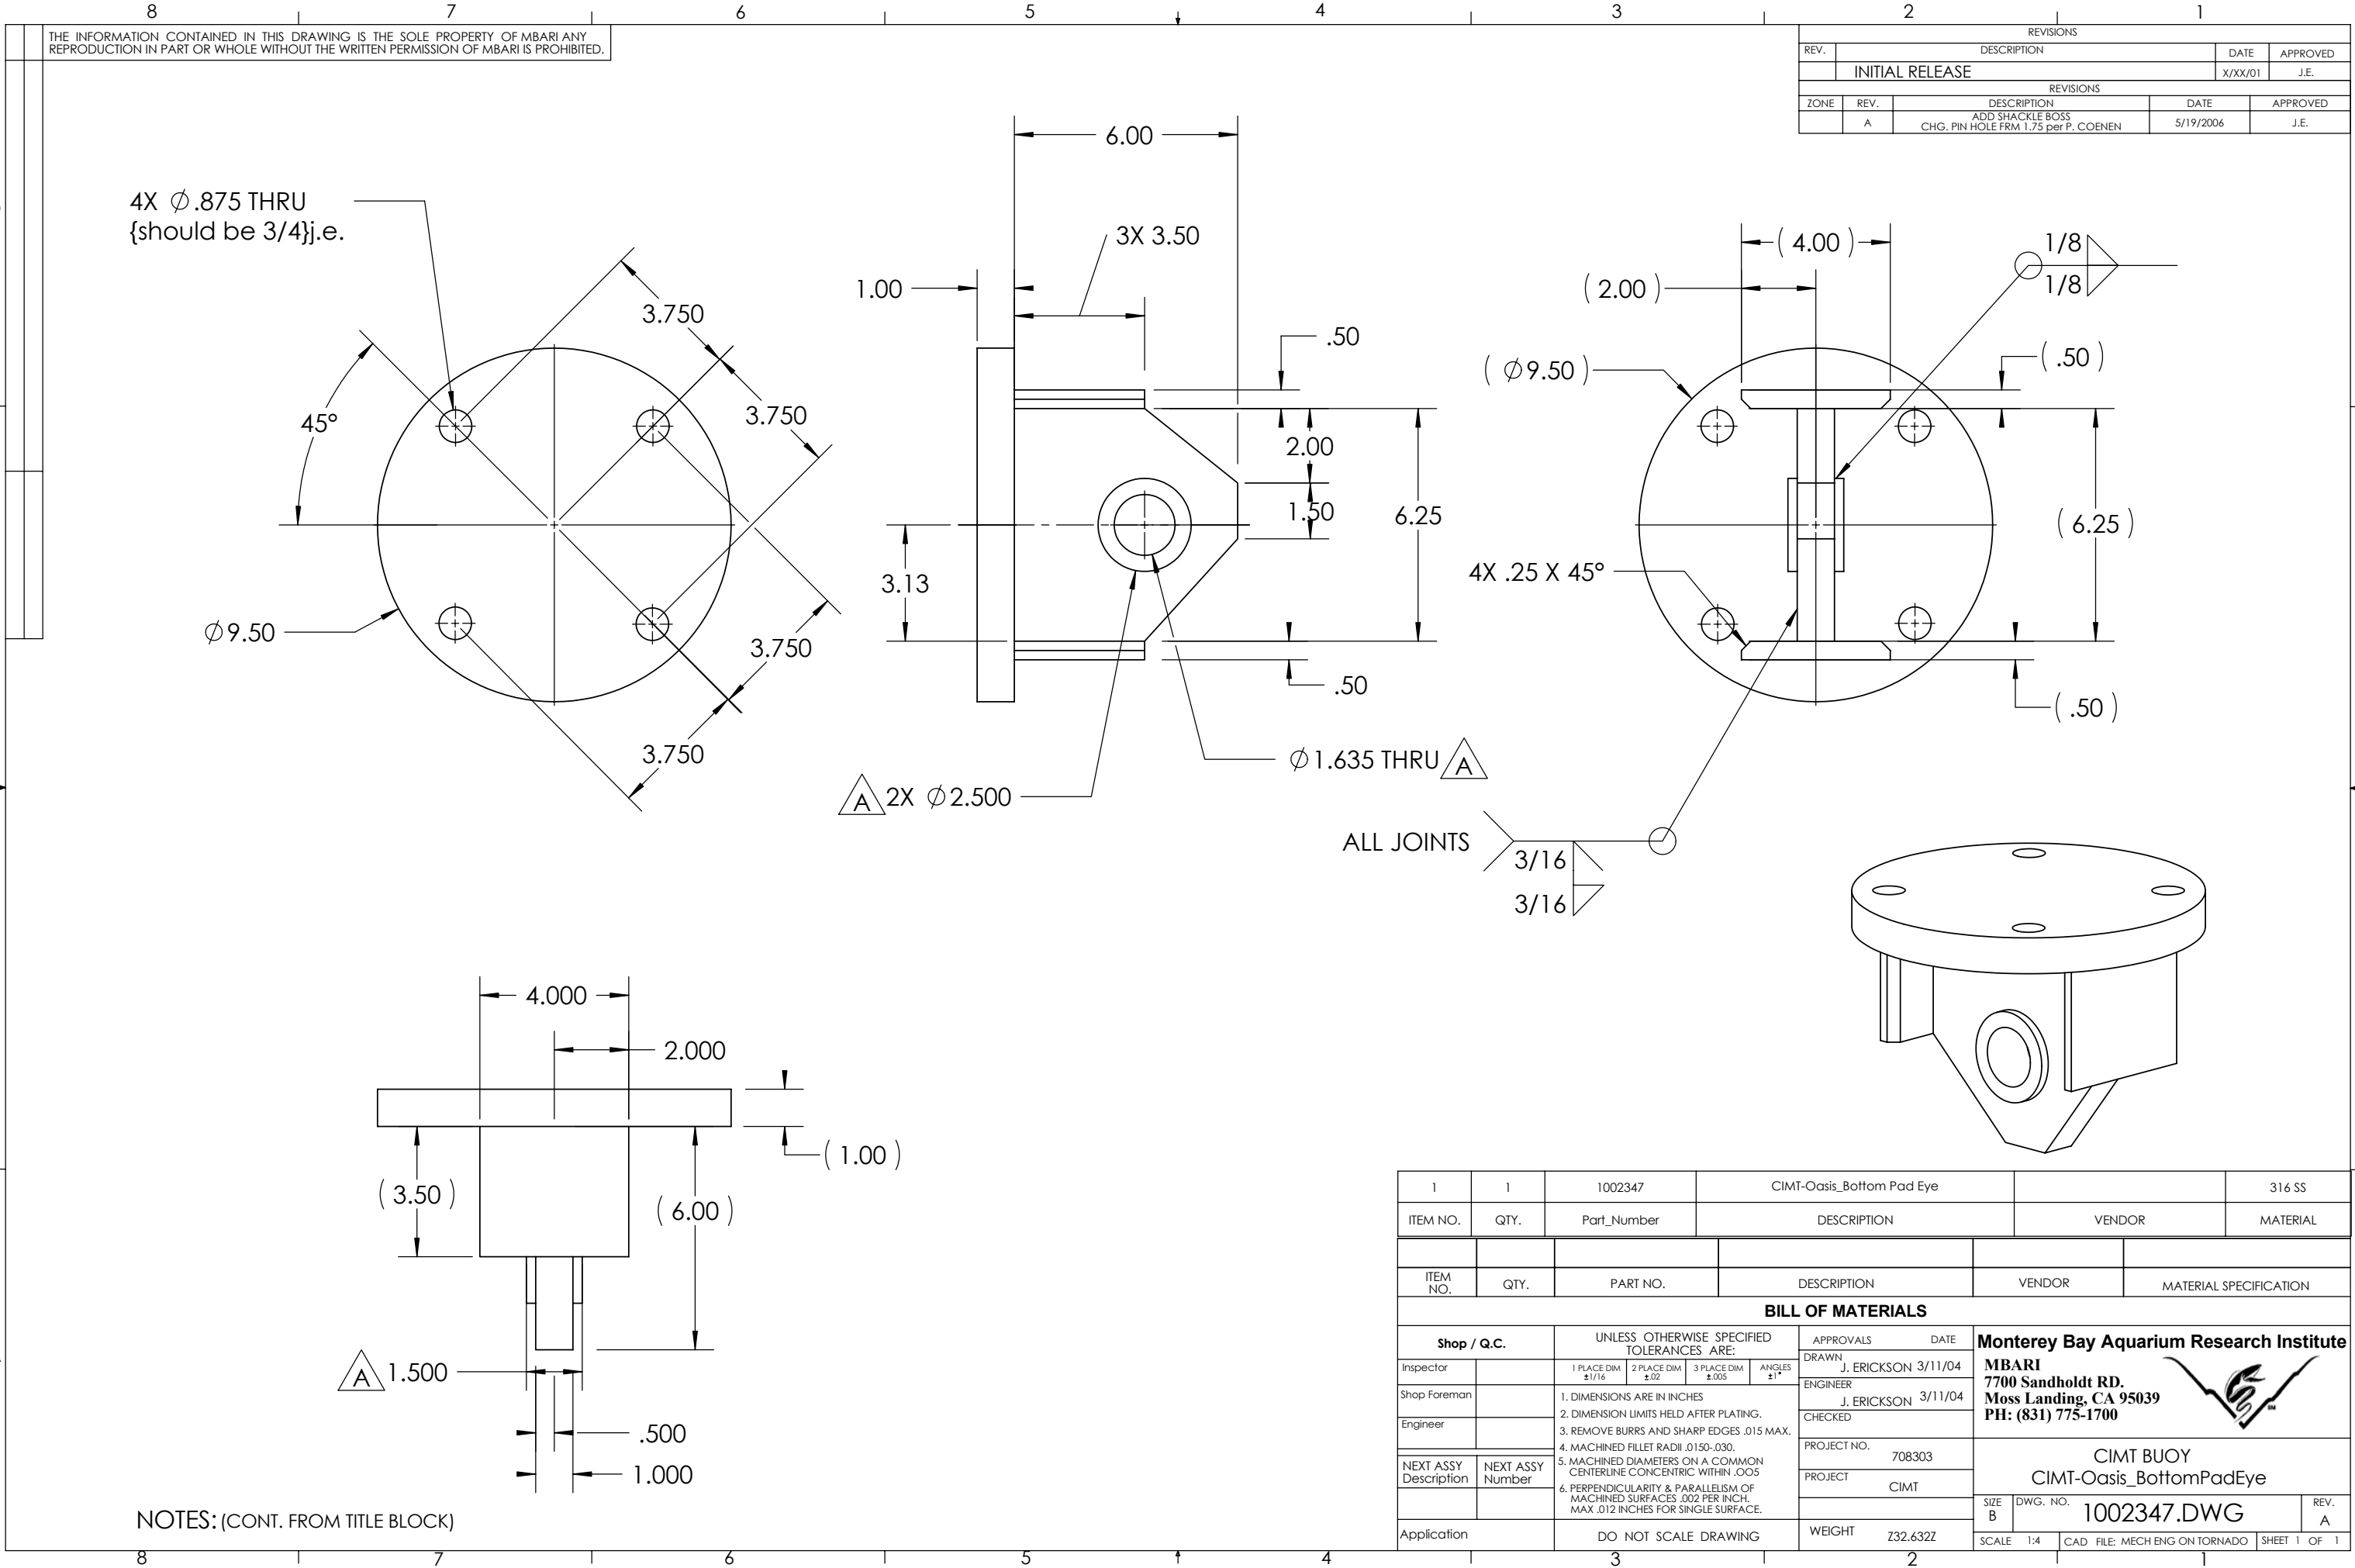
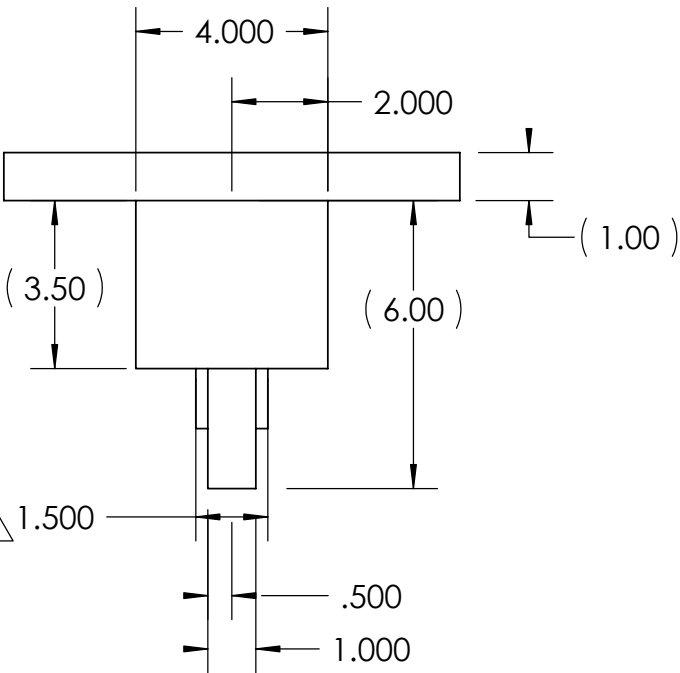
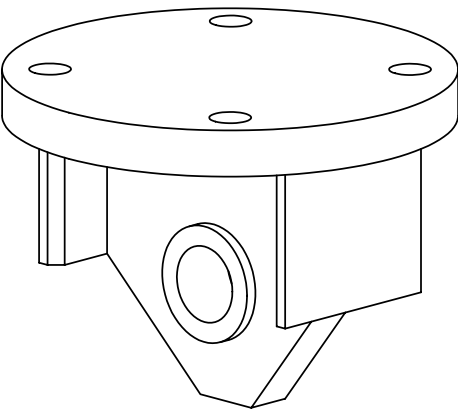
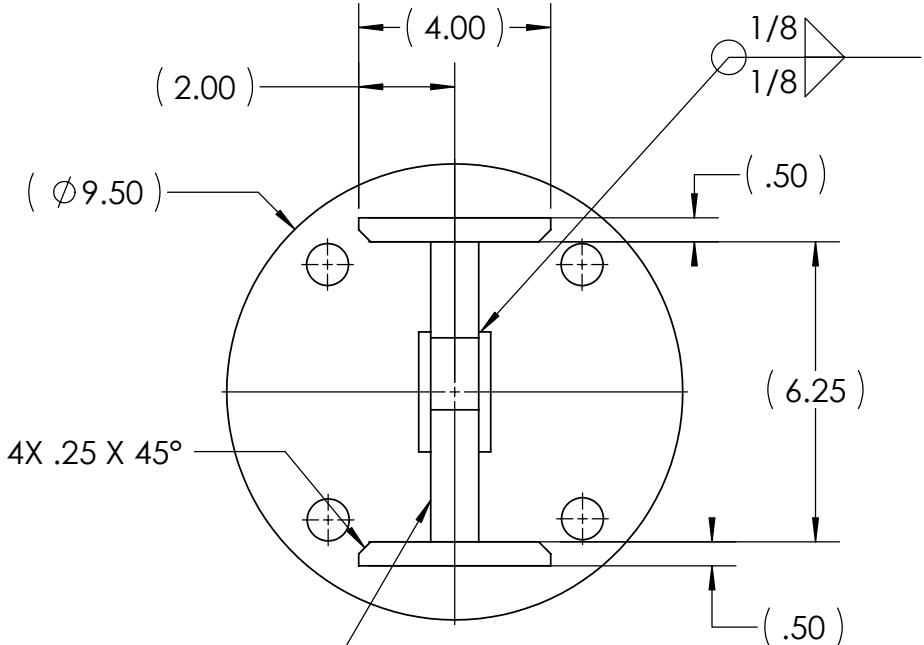


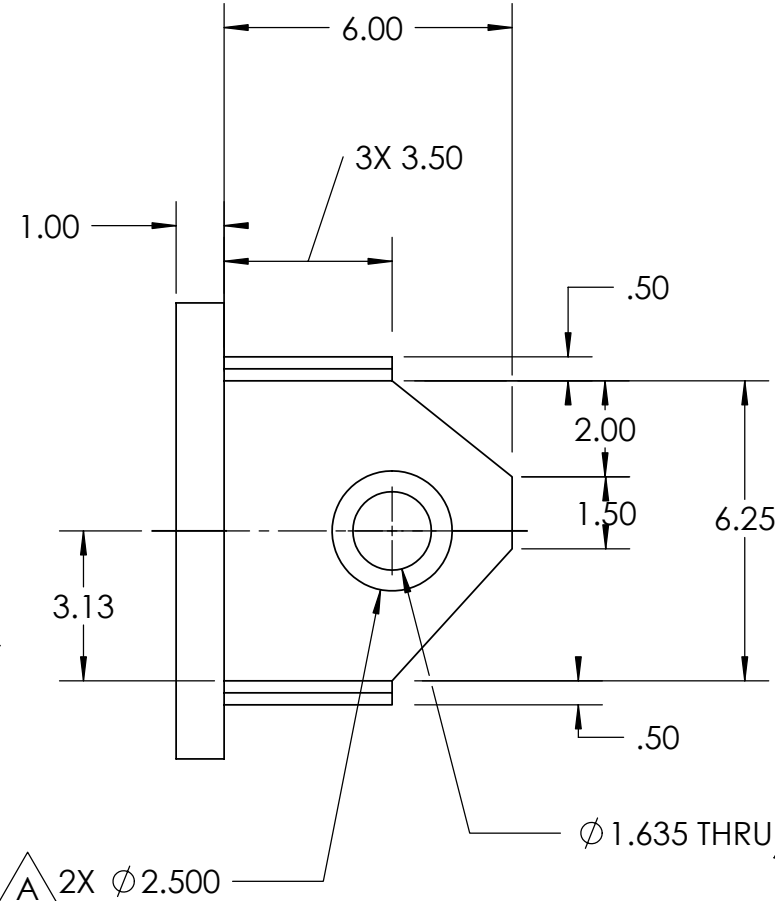

THE INFORMATION CONTAINED IN THIS DRAWING IS THE SOLE PROPERTY OF MBARI ANY REPRODUCTION IN PART OR WHOLE WITHOUT THE WRITTEN PERMISSION OF MBARI IS PROHIBITED.

REVISIONS				
REV.	DESCRIPTION		DATE	APPROVED
	INITIAL RELEASE		X/XX/01	J.E.
REVISIONS				
ZONE	REV.	DESCRIPTION	DATE	APPROVED
	A	ADD SHACKLE BOSS CHG. PIN HOLE FRM 1.75 per P. COENEN	5/19/2006	J.E.

4X Ø.875 THRU
{should be 3/4}j.e.

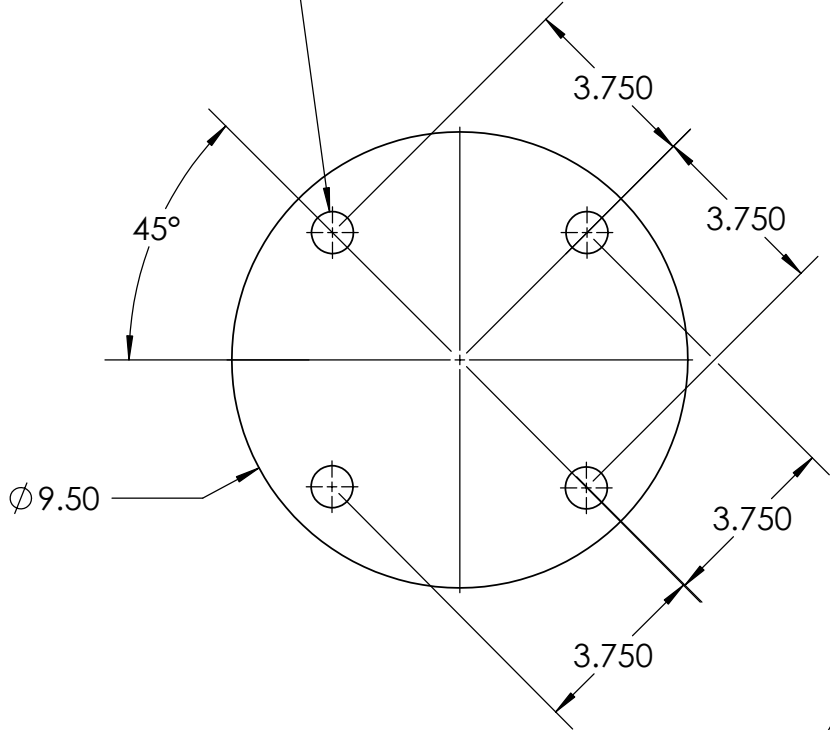

NOTES: (CONT. FROM TITLE BLOCK)

1	1	1002347	CIMT-Oasis_Bottom Pad Eye			316 SS	
ITEM NO.	QTY.	Part_Number	DESCRIPTION			VENDOR	MATERIAL
ITEM NO.	QTY.	PART NO.	DESCRIPTION			VENDOR	MATERIAL SPECIFICATION
BILL OF MATERIALS							
Shop / Q.C.		UNLESS OTHERWISE SPECIFIED TOLERANCES ARE:			APPROVALS DATE		
Inspector		1 PLACE DIM ±1/16	2 PLACE DIM ±.02	3 PLACE DIM ±.005	ANGLES ±1°	DRAWN J. ERICKSON 3/11/04	
Shop Foreman		1. DIMENSIONS ARE IN INCHES 2. DIMENSION LIMITS HELD AFTER PLATING. 3. REMOVE BURRS AND SHARP EDGES .015 MAX. 4. MACHINED FILLET RADII .0150-.030. 5. MACHINED DIAMETERS ON A COMMON CENTERLINE CONCENTRIC WITHIN .005 6. PERPENDICULARITY & PARALLELISM OF MACHINED SURFACES .002 PER INCH. MAX .012 INCHES FOR SINGLE SURFACE.				ENGINEER J. ERICKSON 3/11/04	
Engineer						CHECKED	
						PROJECT NO. 708303	
NEXT ASSY Description	NEXT ASSY Number					PROJECT CIMT	
Application		DO NOT SCALE DRAWING			WEIGHT Z32.632Z		
					SIZE B DWG. NO. 1002347.DWG		
					SCALE 1:4 CAD FILE: MECH ENG ON TORNADO SHEET 1 OF 1		

Monterey Bay Aquarium Research Institute

MBARI

7700 Sandholdt RD.

Moss Landing, CA 95039

PH: (831) 775-1700






CIMT BUOY
CIMT-Oasis_BottomPadEye

REV. A