

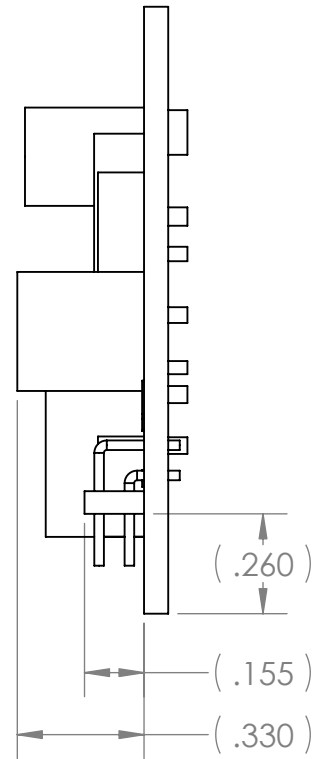
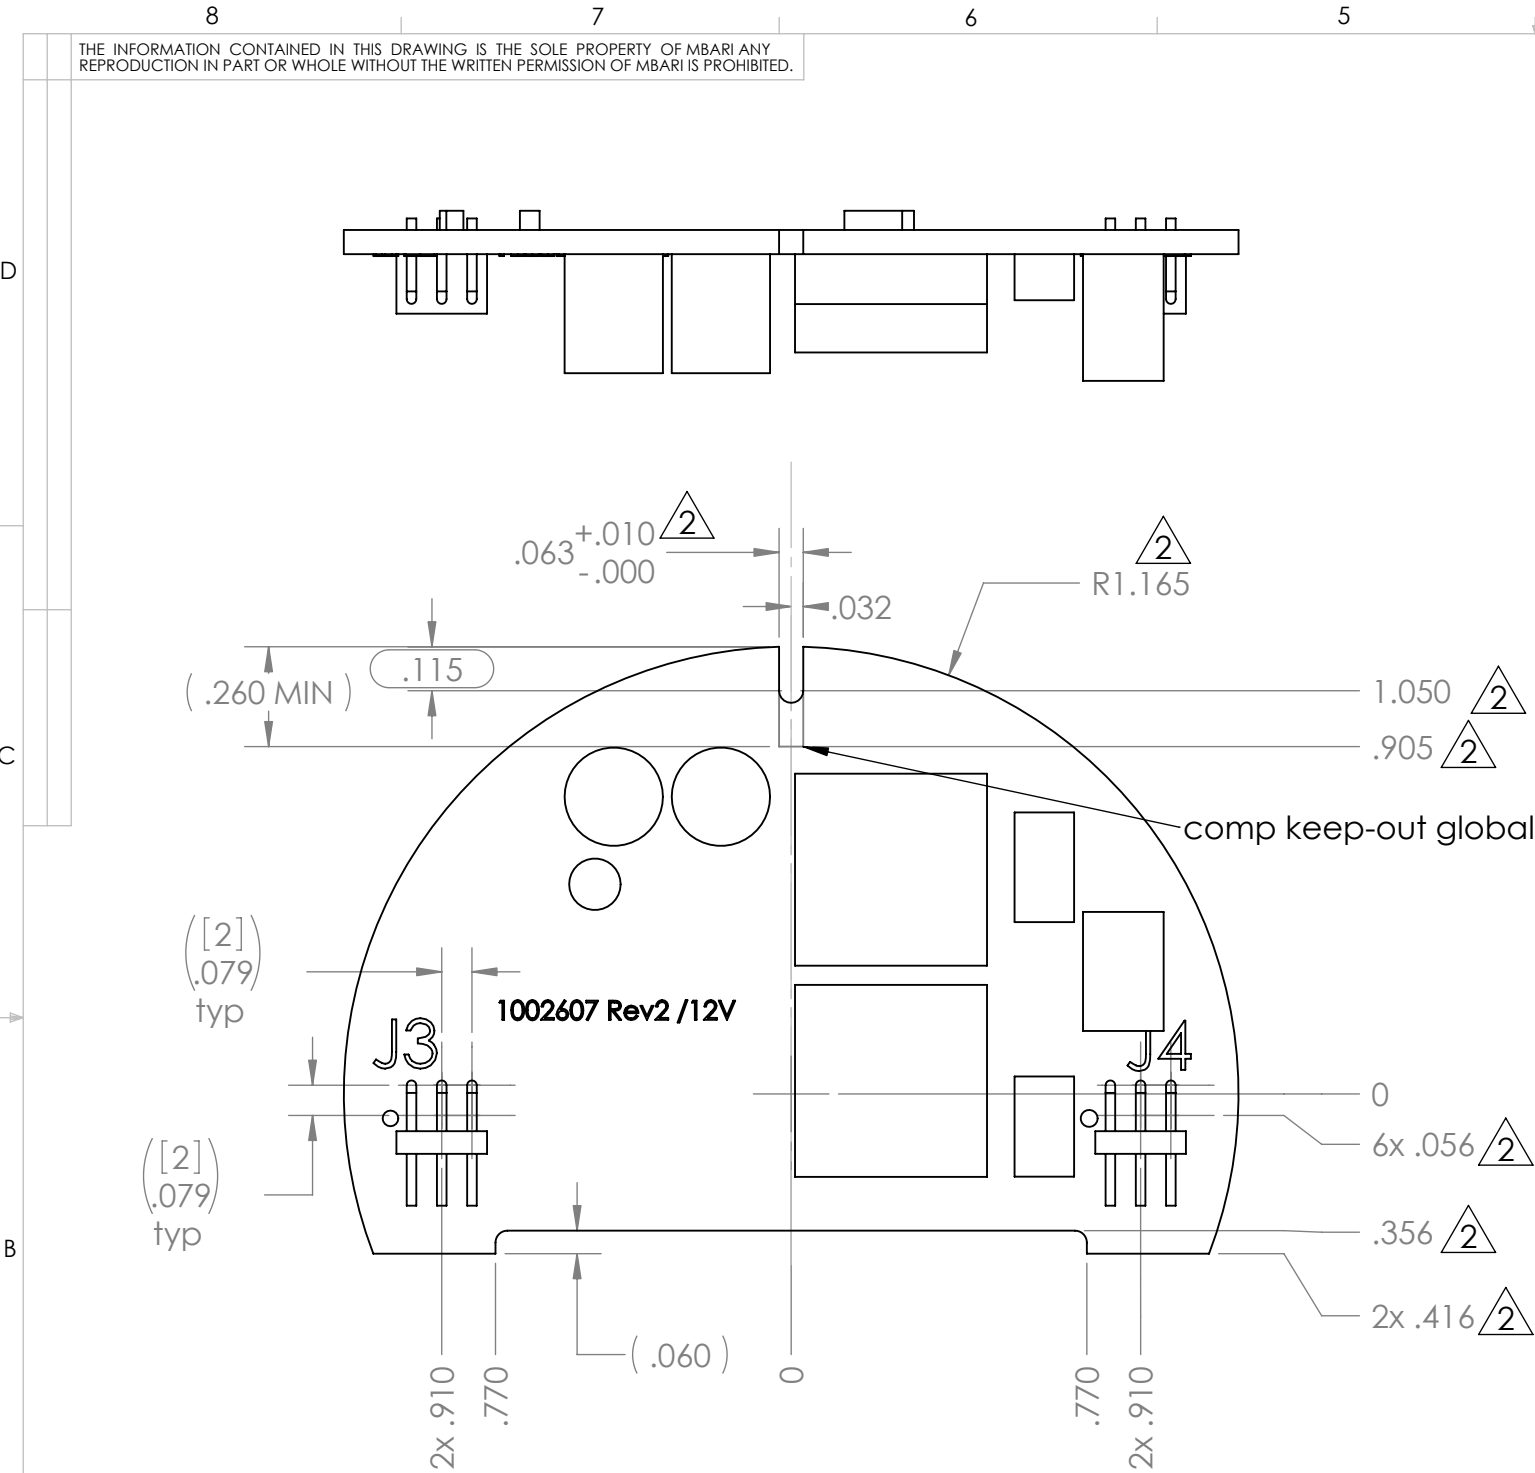


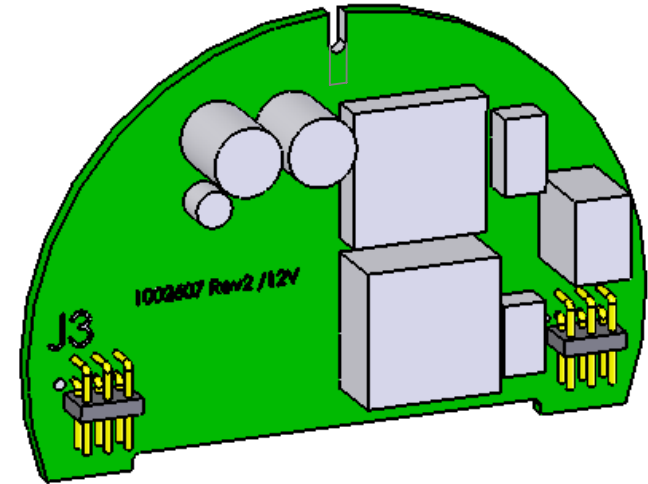

2x
SAMTEC TMM-103-01-G-D-RA

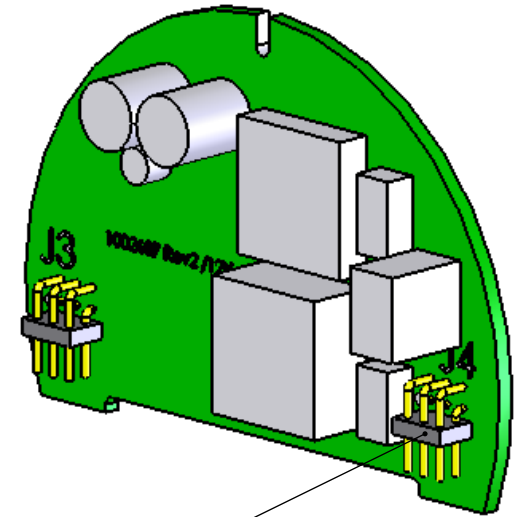

Rev1.5(10/7/2005): capture of assembled board (1002607Rev1)
Rev2.0(11/6/2007): redesign to add the notch, conn positions and correct board size

BILL OF MATERIALS									
Shop / Q.C.		UNLESS OTHERWISE SPECIFIED TOLERANCES ARE:				APPROVALS		DATE	
Inspector		1 PLACE DIM ±1/16	2 PLACE DIM ±.02	3 PLACE DIM ±.005	ANGLES ±1°	DRAWN	XX	XX	
Shop Foreman		1. DIMENSIONS ARE IN INCHES 2. DIMENSION LIMITS HELD AFTER PLATING. 3. REMOVE BURRS AND SHARP EDGES .015 MAX. 4. MACHINED FILLET RADII .0150-.030. 5. MACHINED DIAMETERS ON A COMMON CENTERLINE CONCENTRIC WITHIN .005 6. PERPENDICULARITY & PARALLELISM OF MACHINED SURFACES .002 PER INCH, MAX .012 INCHES FOR SINGLE SURFACE.				ENGINEER	Klimov	11/6/2007	
Engineer						CHECKED			
NEXT ASSY Description	NEXT ASSY Number					PROJECT NO.	900392		
						PROJECT	BiOSA		
Application		DO NOT SCALE DRAWING				WEIGHT			
		3							

Monterey Bay Aquarium Research Institute
MBARI
7700 Sandholdt RD.
Moss Landing, CA 95039
PH: (831) 775-1700



1002607 - Power_Board_12V