


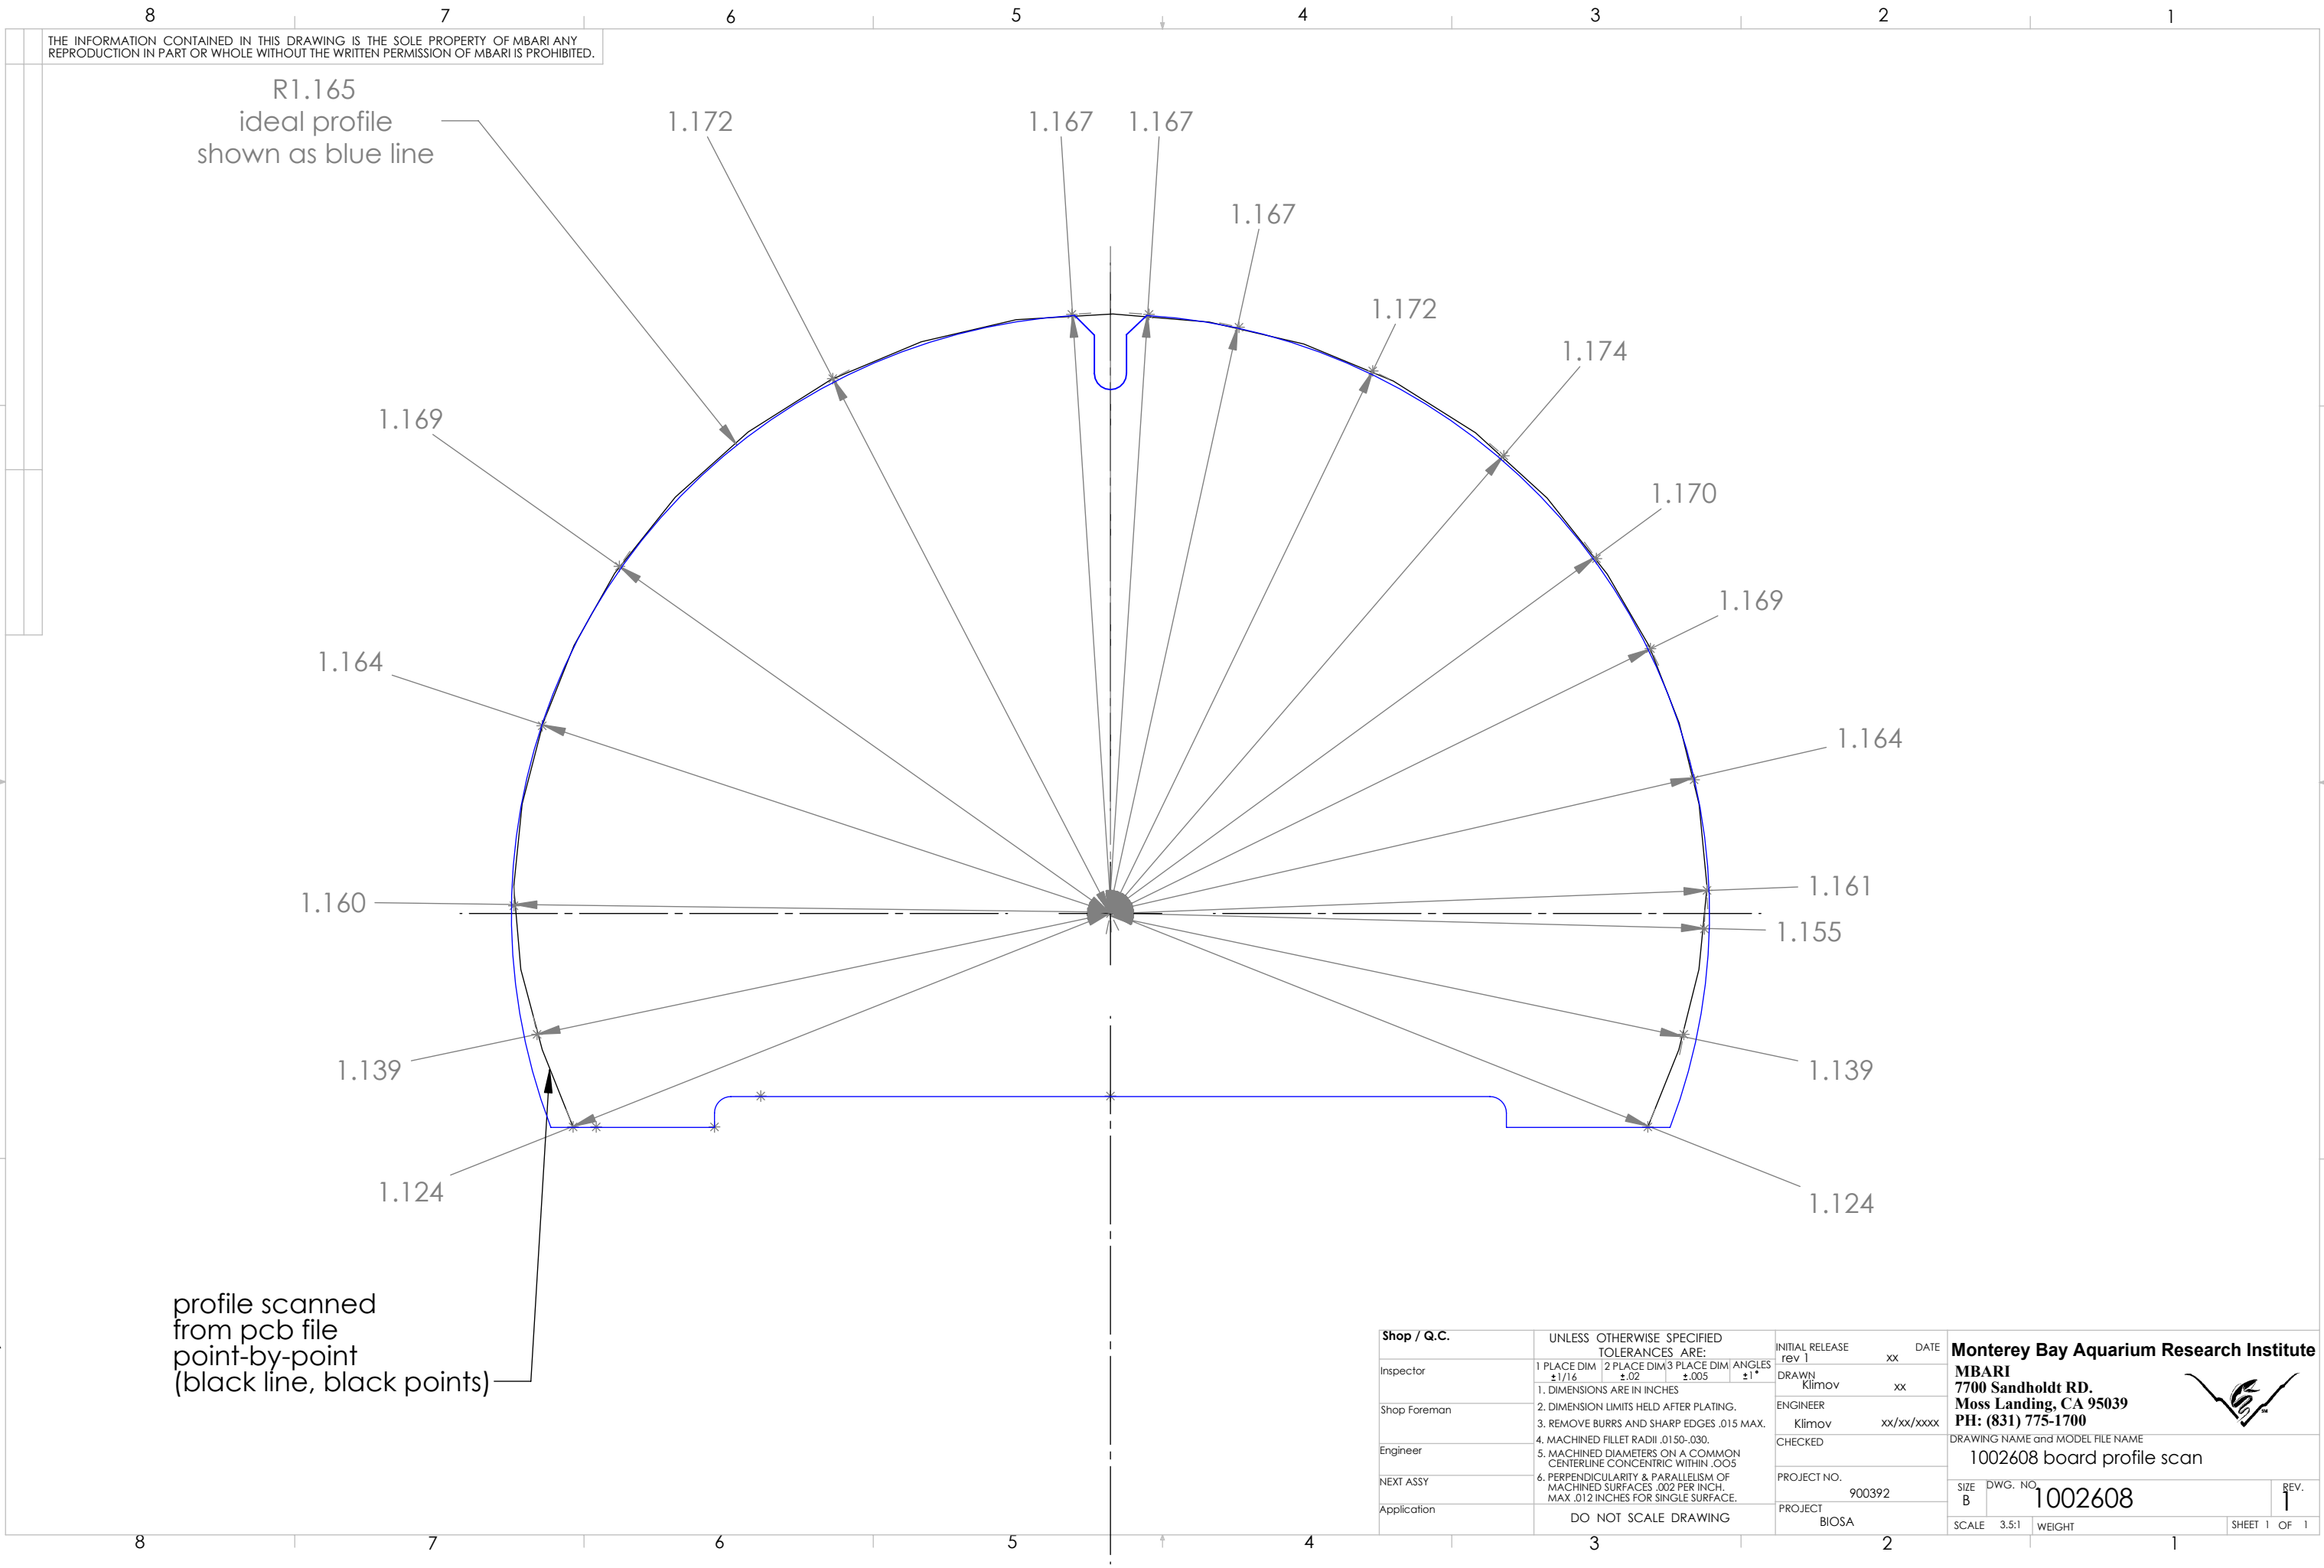

THE INFORMATION CONTAINED IN THIS DRAWING IS THE SOLE PROPERTY OF MBARI ANY REPRODUCTION IN PART OR WHOLE WITHOUT THE WRITTEN PERMISSION OF MBARI IS PROHIBITED.

Shop / Q.C.		UNLESS OTHERWISE SPECIFIED TOLERANCES ARE:		INITIAL RELEASE	DATE	Monterey Bay Aquarium Research Institute	
Inspector		1 PLACE DIM $\pm 1/16$	2 PLACE DIM $\pm .02$	3 PLACE DIM $\pm .005$	xx		
Shop Foreman		1. DIMENSIONS ARE IN INCHES		DRAWN	xx	MBARI 7700 Sandholdt RD. Moss Landing, CA 95039 PH: (831) 775-1700	
Engineer		2. DIMENSION LIMITS HELD AFTER PLATING.		ENGINEER	xx/xx/xxxx		
NEXT ASSY		3. REMOVE BURRS AND SHARP EDGES .015 MAX.		CHECKED		DRAWING NAME and MODEL FILE NAME	
Application		4. MACHINED FILLET RADII .0150-.030.		PROJECT NO.	900392	1002608 board profile scan	
		5. MACHINED DIAMETERS ON A COMMON CENTERLINE CONCENTRIC WITHIN .005		PROJECT	BIOSA	SIZE B	DWG. NO. 1002608
		6. PERPENDICULARITY & PARALLELISM OF MACHINED SURFACES .002 PER INCH. MAX .012 INCHES FOR SINGLE SURFACE.				SCALE 3.5:1	WEIGHT
		DO NOT SCALE DRAWING				SHEET 1 OF 1	REV. 1