


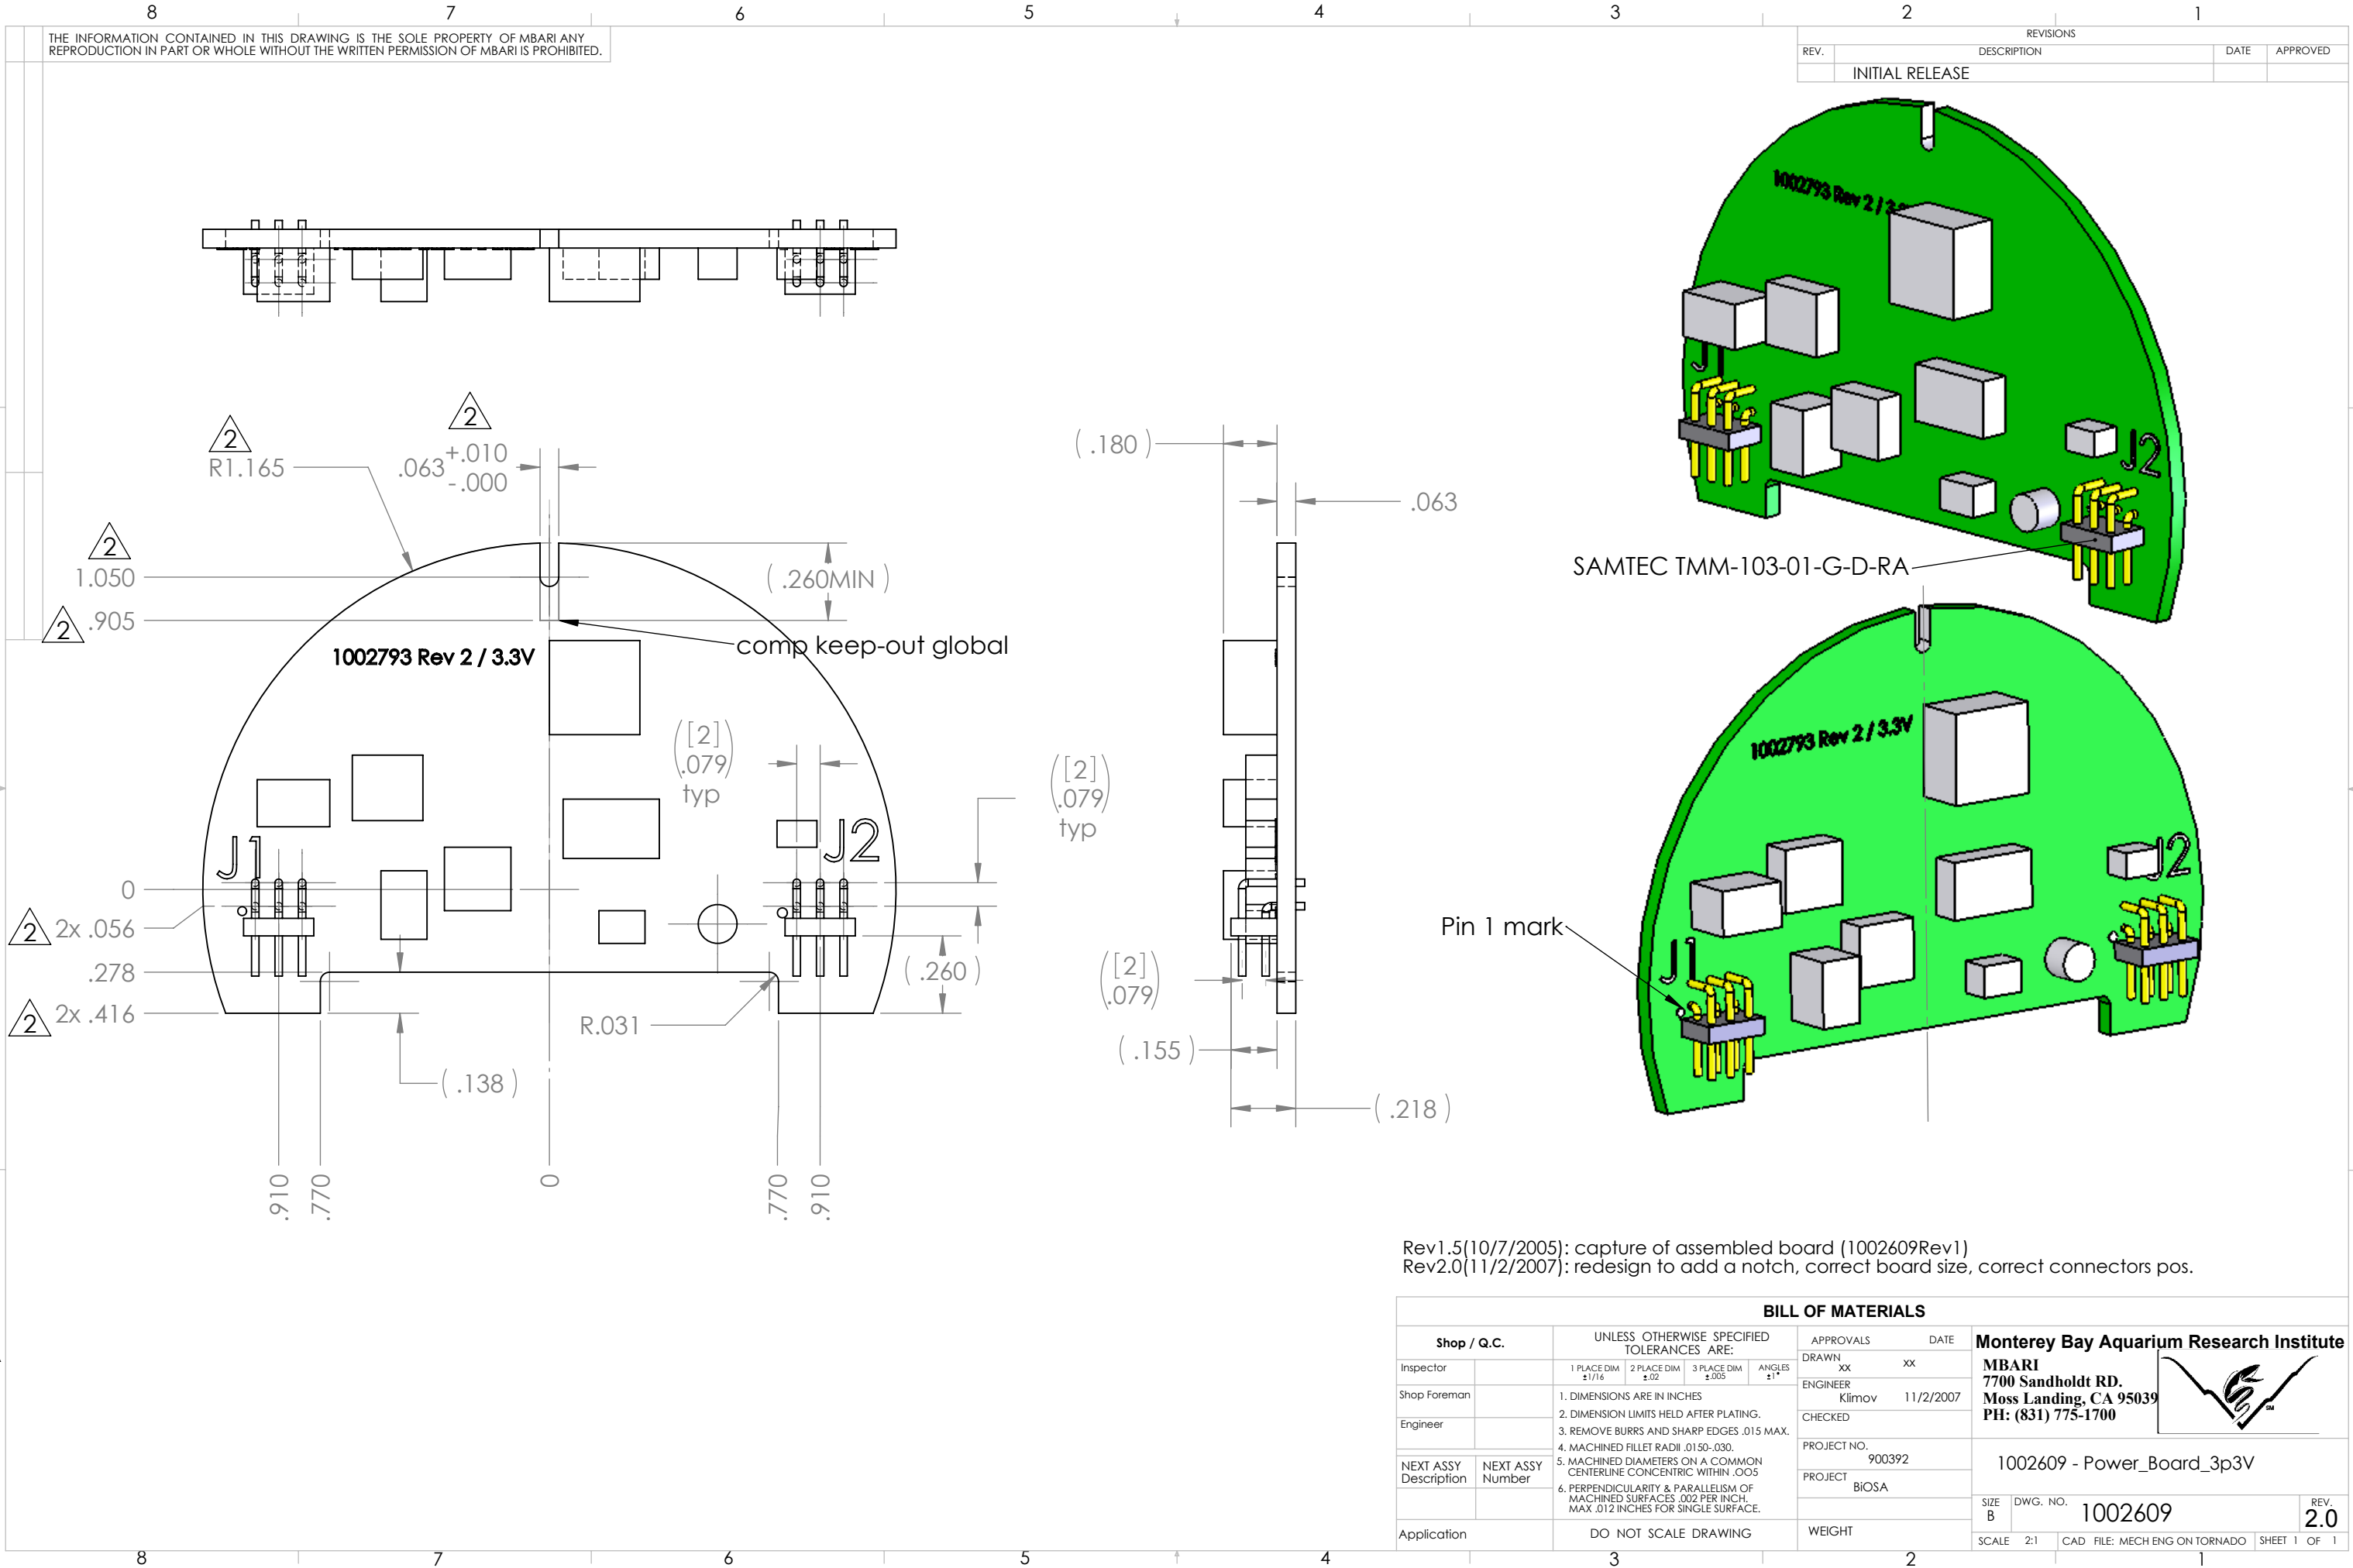

BILL OF MATERIALS														
Shop / Q.C.		UNLESS OTHERWISE SPECIFIED TOLERANCES ARE:				APPROVALS		DATE		Monterey Bay Aquarium Research Institute MBARI 7700 Sandholdt RD. Moss Landing, CA 95039 PH: (831) 775-1700				
Inspector		1 PLACE DIM ±1/16	2 PLACE DIM ±.02	3 PLACE DIM ±.005	ANGLES ±1°	DRAWN	XX	XX						
Shop Foreman		1. DIMENSIONS ARE IN INCHES 2. DIMENSION LIMITS HELD AFTER PLATING. 3. REMOVE BURRS AND SHARP EDGES .015 MAX. 4. MACHINED FILLET RADII .0150-.030. 5. MACHINED DIAMETERS ON A COMMON CENTERLINE CONCENTRIC WITHIN .005 6. PERPENDICULARITY & PARALLELISM OF MACHINED SURFACES .002 PER INCH, MAX .012 INCHES FOR SINGLE SURFACE.				ENGINEER	Klimov	11/2/2007						
Engineer						CHECKED								
NEXT ASSY Description	NEXT ASSY Number									PROJECT NO.	900392	1002609 - Power_Board_3p3V		
										PROJECT	BIO5A			
Application		DO NOT SCALE DRAWING				WEIGHT		SIZE B		DWG. NO. 1002609		REV. 2.0		
		3				2		SCALE 2:1		CAD FILE: MECH ENG ON TORNADO		SHEET 1 OF 1		