

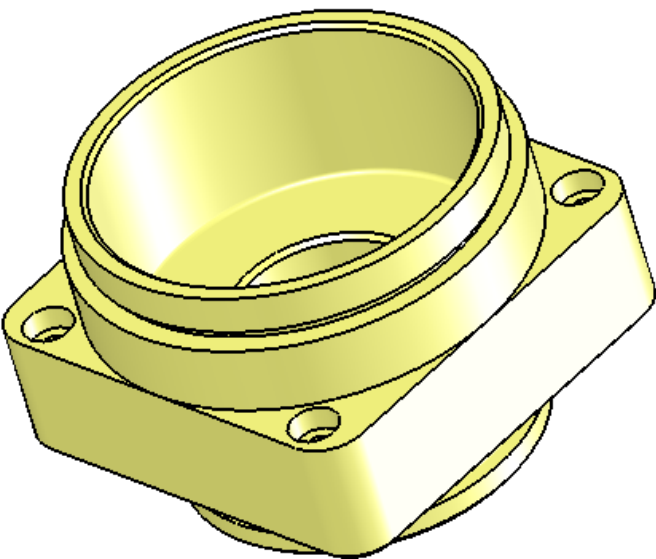


THE INFORMATION CONTAINED IN THIS DRAWING IS THE SOLE PROPERTY OF MBARI.
ANY REPRODUCTION IN PART OR WHOLE WITHOUT THE WRITTEN PERMISSION OF MBARI
IS PROHIBITED.

REVISIONS			
REV.	DESCRIPTION	DATE	APPROVED
	INITIAL RELEASE		
4	1. Add Radii. 2. Add Geometric Tolerance.	07Dec05	F. Shane
5	1. Height reduced by 0.04". 2. Make Body Squared.	12Dec06	F. Shane

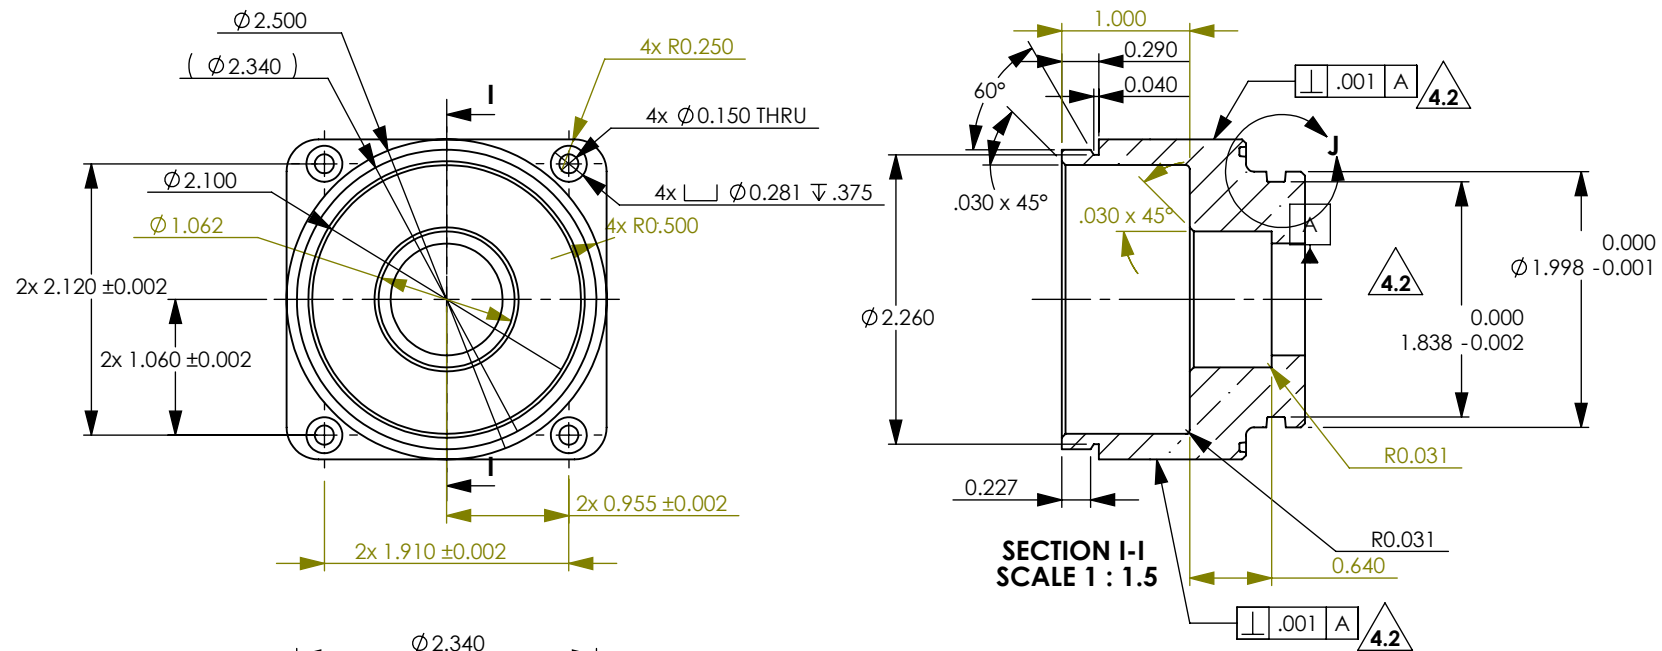

④

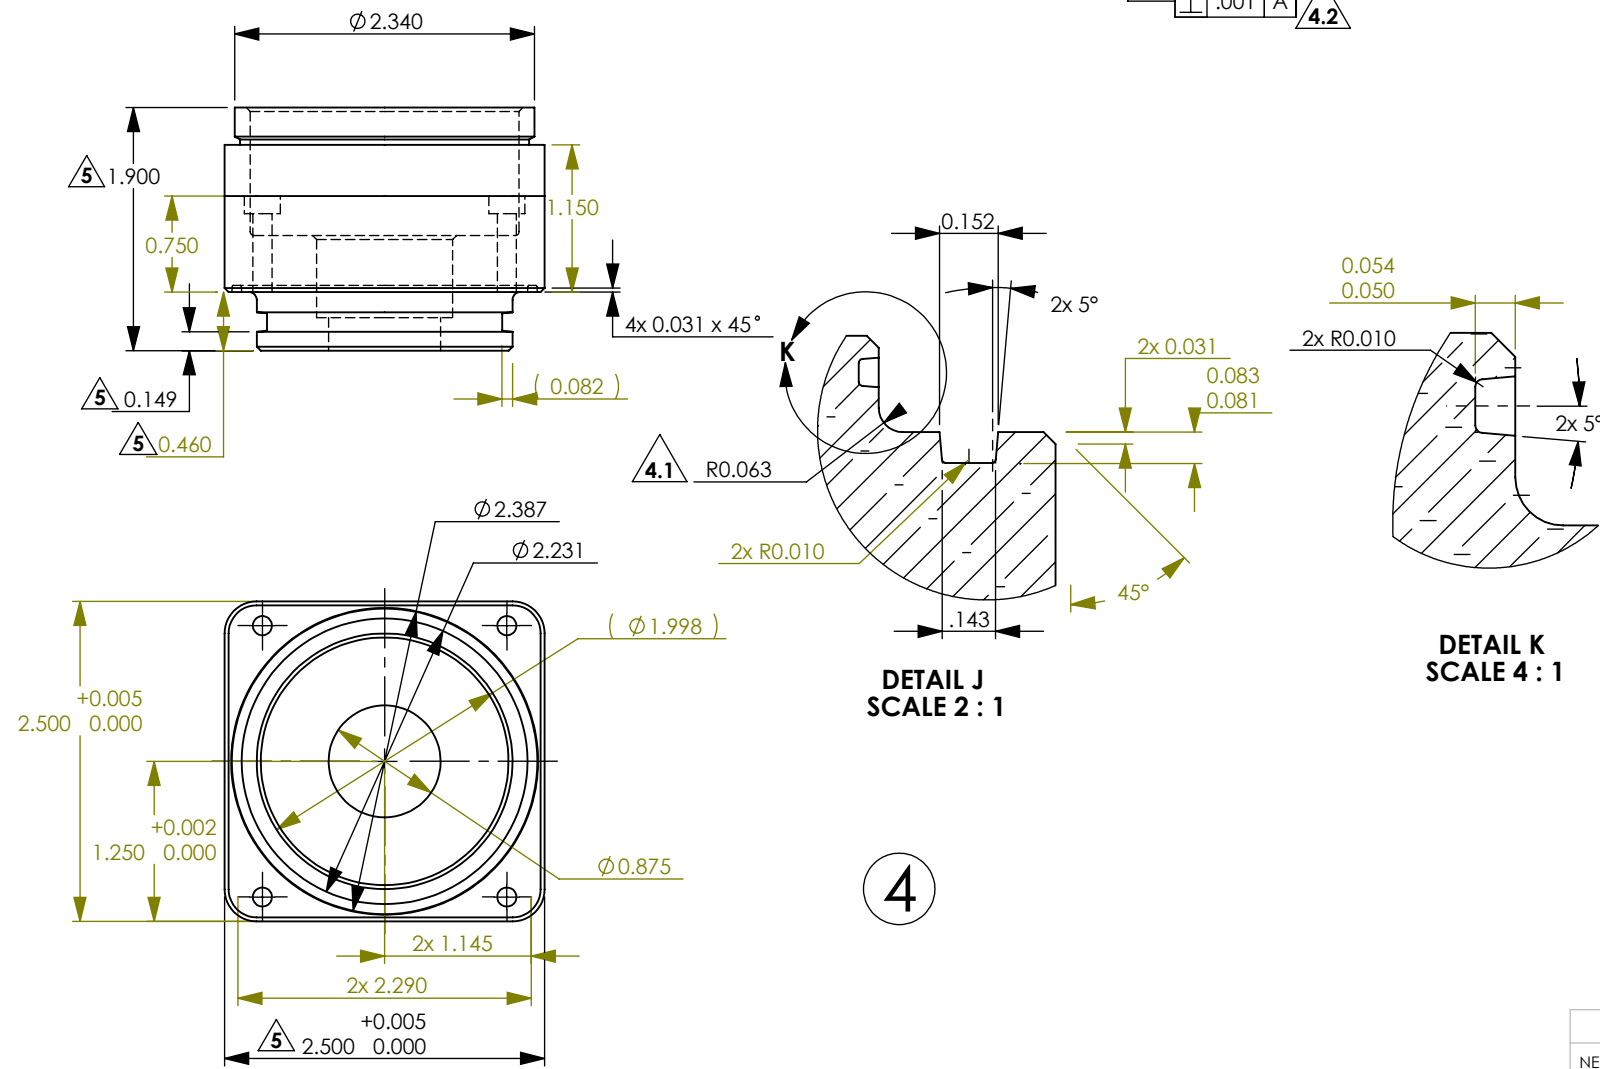

1	3ea.					Sensor Base				6Al-4V Titanium							
Item No.	Qty	Part No.				Description				Material Specification							
UNLESS OTHERWISE SPECIFIED TOLERANCES ARE: 1 PLACE DIM ±.1/16" 2 PLACE DIM ±.02 3 PLACE DIM ±.005 ANGLES ±.1° 1. DIMENSIONS ARE IN INCHES 2. DIMENSION LIMITS HELD AFTER PLATING. 3. REMOVE BURRS AND SHARP EDGES .015 MAX. 4. MACHINED FILLET RADII .0150-.030. 5. MACHINED DIAMETERS ON A COMMON CENTERLINE CONCENTRIC WITHIN .005 6. PERPENDICULARITY & PARALLELISM OF MACHINED SURFACES .002 PER INCH. MAX .012 INCHES FOR SINGLE SURFACE. DO NOT SCALE DRAWING						APPROVALS		DATE		Monterey Bay Aquarium Research Institute 7700 Sandholdt RD. Moss Landing, CA 95039 PH: (408) 775-1700  BIOSA Optical Sensor Base							
						DRAWN		F. Shane								18Oct2005	
						ENGINEER		F. Shane								18Oct2005	
						CHECKED											
						PROJECT NO.		900392									
						PROJECT		BIOSA									
						WEIGHT				SIZE B		DWG. NO. 1002892DWG-004 Optical Sensor Base		REV. 5			
				SCALE NONE		CAD FILE: Project Library/BIOSA		SHEET 1 OF 1									