


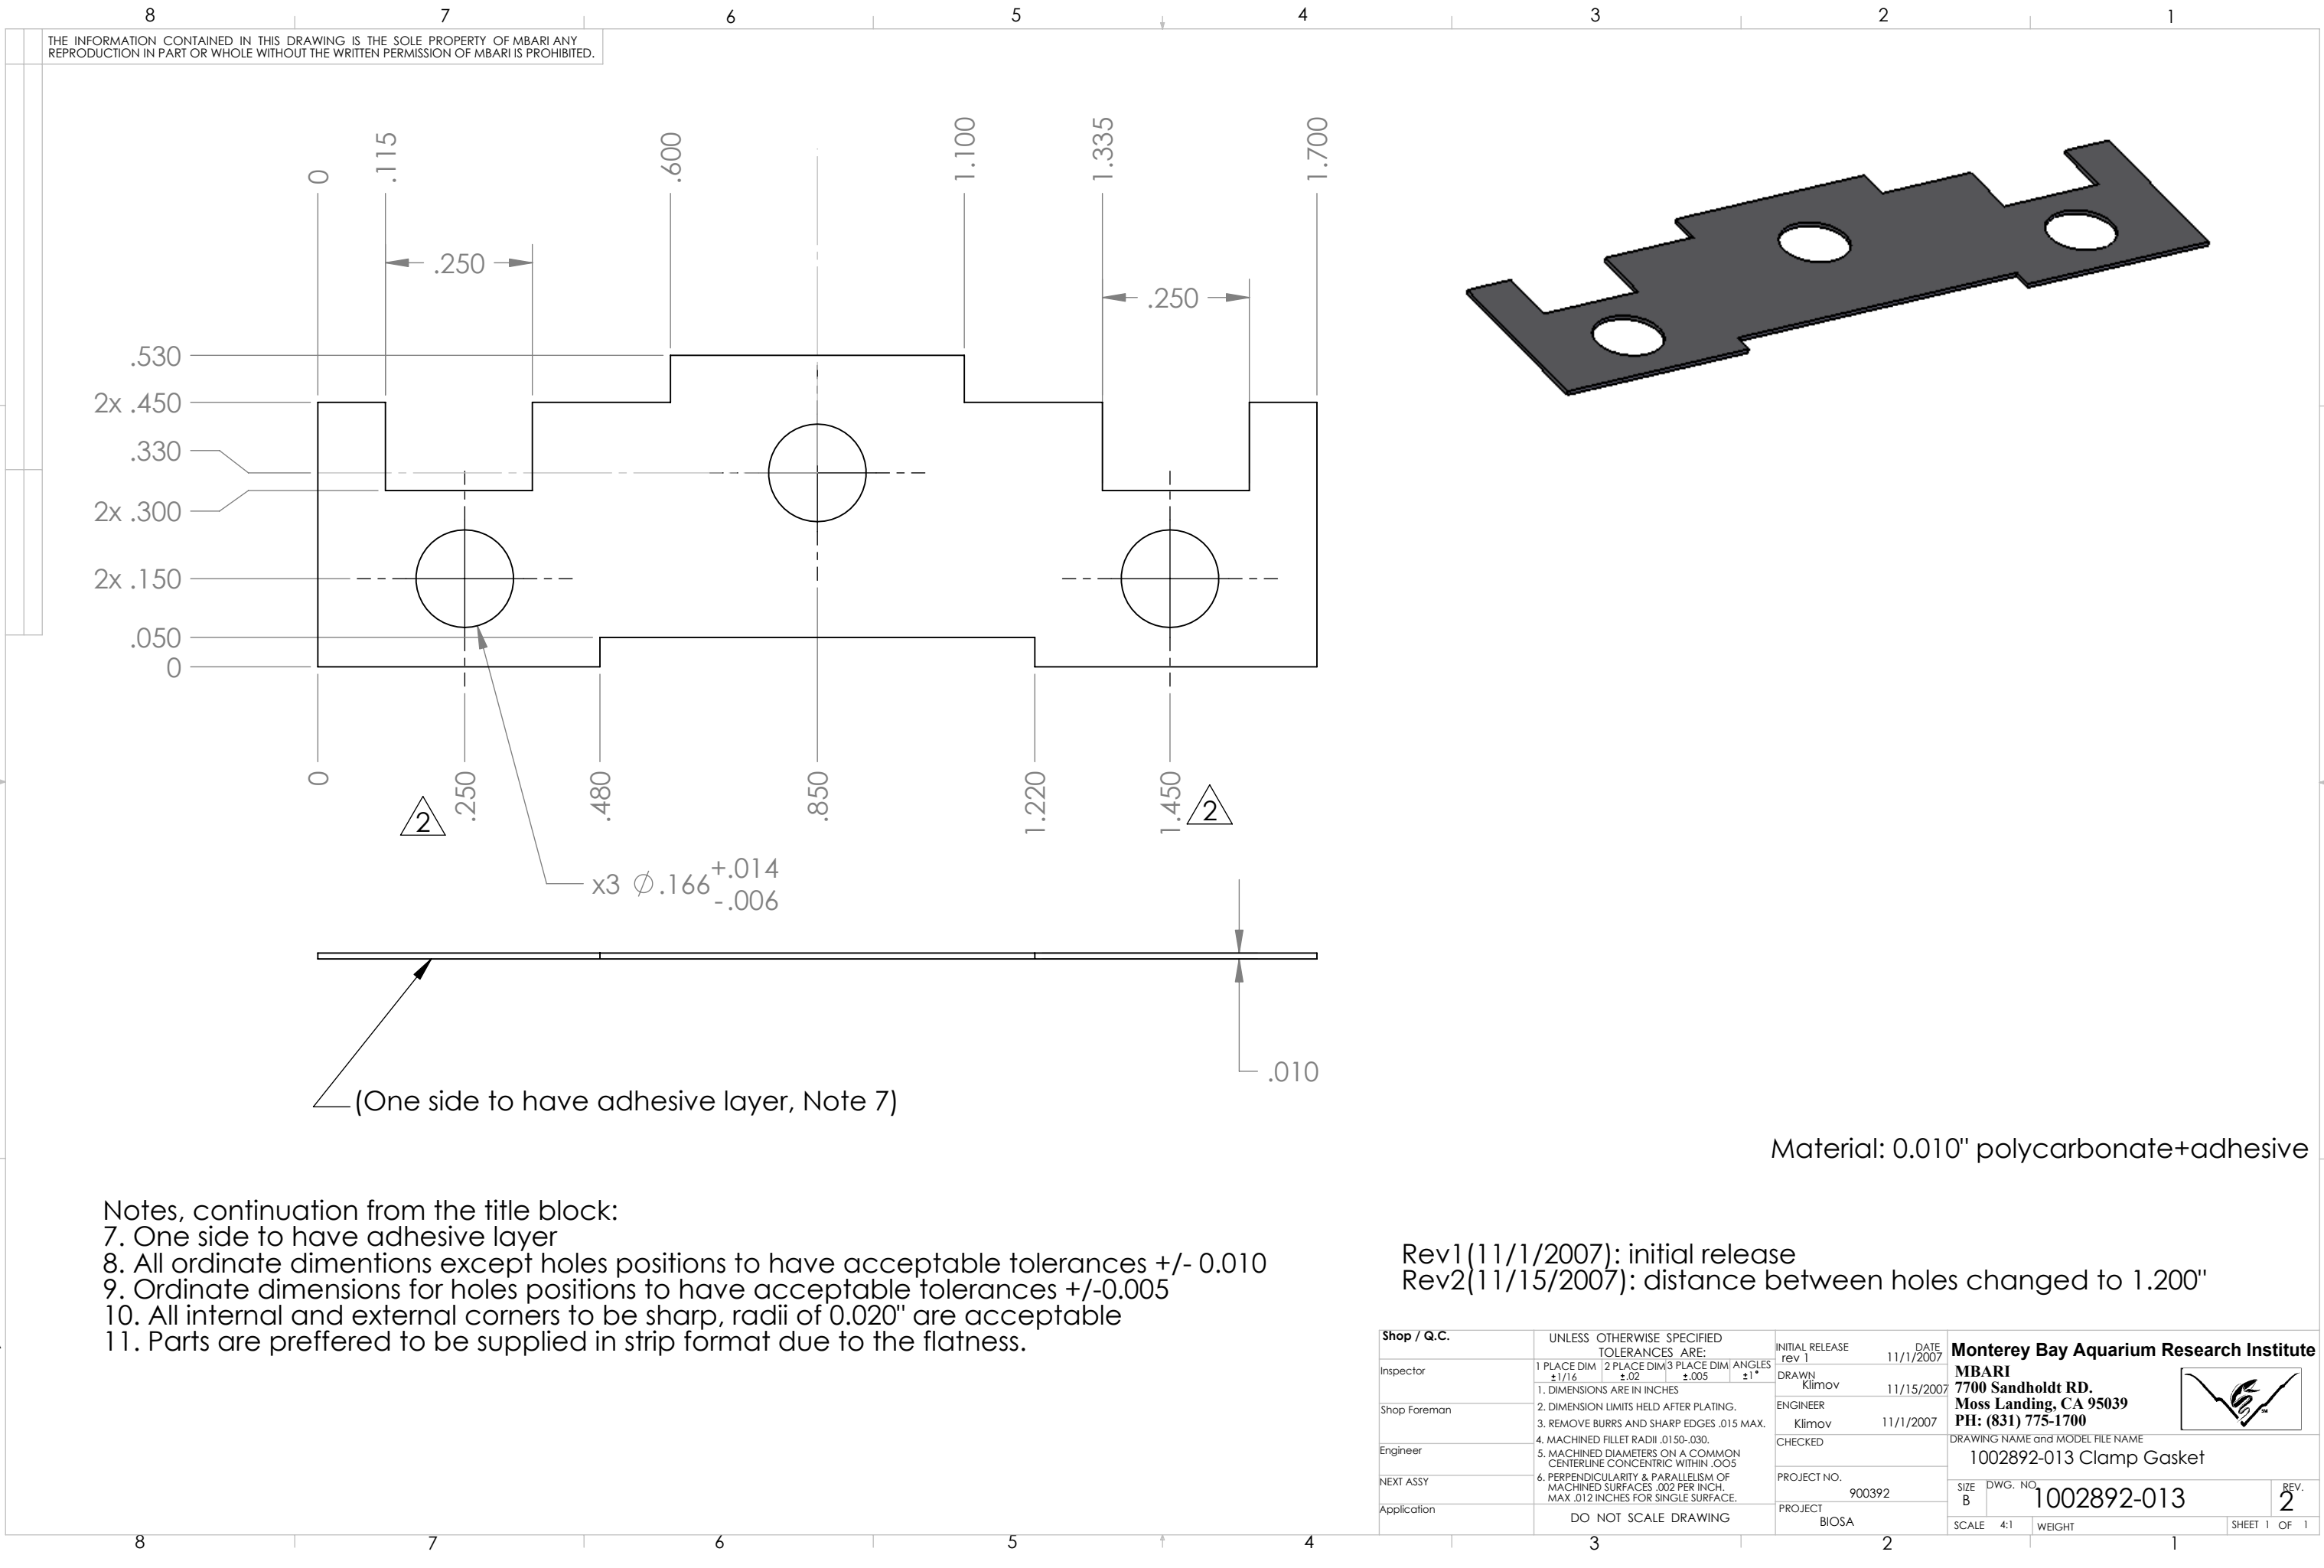

Material: 0.010" polycarbonate+adhesive

- Notes, continuation from the title block:
- 7. One side to have adhesive layer
 - 8. All ordinate dimintions except holes positions to have acceptable tolerances +/- 0.010
 - 9. Ordinate dimensions for holes positions to have acceptable tolerances +/-0.005
 - 10. All internal and external corners to be sharp, radii of 0.020" are acceptable
 - 11. Parts are preffered to be supplied in strip format due to the flatness.

Rev1(11/1/2007): initial release
Rev2(11/15/2007): distance between holes changed to 1.200"

Shop / Q.C.	UNLESS OTHERWISE SPECIFIED TOLERANCES ARE:	INITIAL RELEASE rev 1	DATE 11/1/2007	Monterey Bay Aquarium Research Institute MBARI 7700 Sandholdt RD. Moss Landing, CA 95039 PH: (831) 775-1700	
Inspector	1 PLACE DIM $\pm 1/16$ 2 PLACE DIM $\pm .02$ 3 PLACE DIM $\pm .005$ ANGLES $\pm 1^\circ$	DRAWN Klimov	11/15/2007		
Shop Foreman	1. DIMENSIONS ARE IN INCHES 2. DIMENSION LIMITS HELD AFTER PLATING. 3. REMOVE BURRS AND SHARP EDGES .015 MAX.	ENGINEER Klimov	11/1/2007	DRAWING NAME and MODEL FILE NAME 1002892-013 Clamp Gasket	
Engineer	4. MACHINED FILLET RADII .0150-.030. 5. MACHINED DIAMETERS ON A COMMON CENTERLINE CONCENTRIC WITHIN .005	CHECKED			
NEXT ASSY	6. PERPENDICULARITY & PARALLELISM OF MACHINED SURFACES .002 PER INCH. MAX .012 INCHES FOR SINGLE SURFACE.	PROJECT NO. 900392		SIZE B	DWG. NO. 1002892-013
Application	DO NOT SCALE DRAWING	PROJECT BIOSA		SCALE 4:1	WEIGHT
				SHEET 1	OF 1