


THE INFORMATION CONTAINED IN THIS DRAWING IS THE SOLE PROPERTY OF MBARI. ANY REPRODUCTION IN PART OR WHOLE WITHOUT THE WRITTEN PERMISSION OF MBARI IS PROHIBITED.

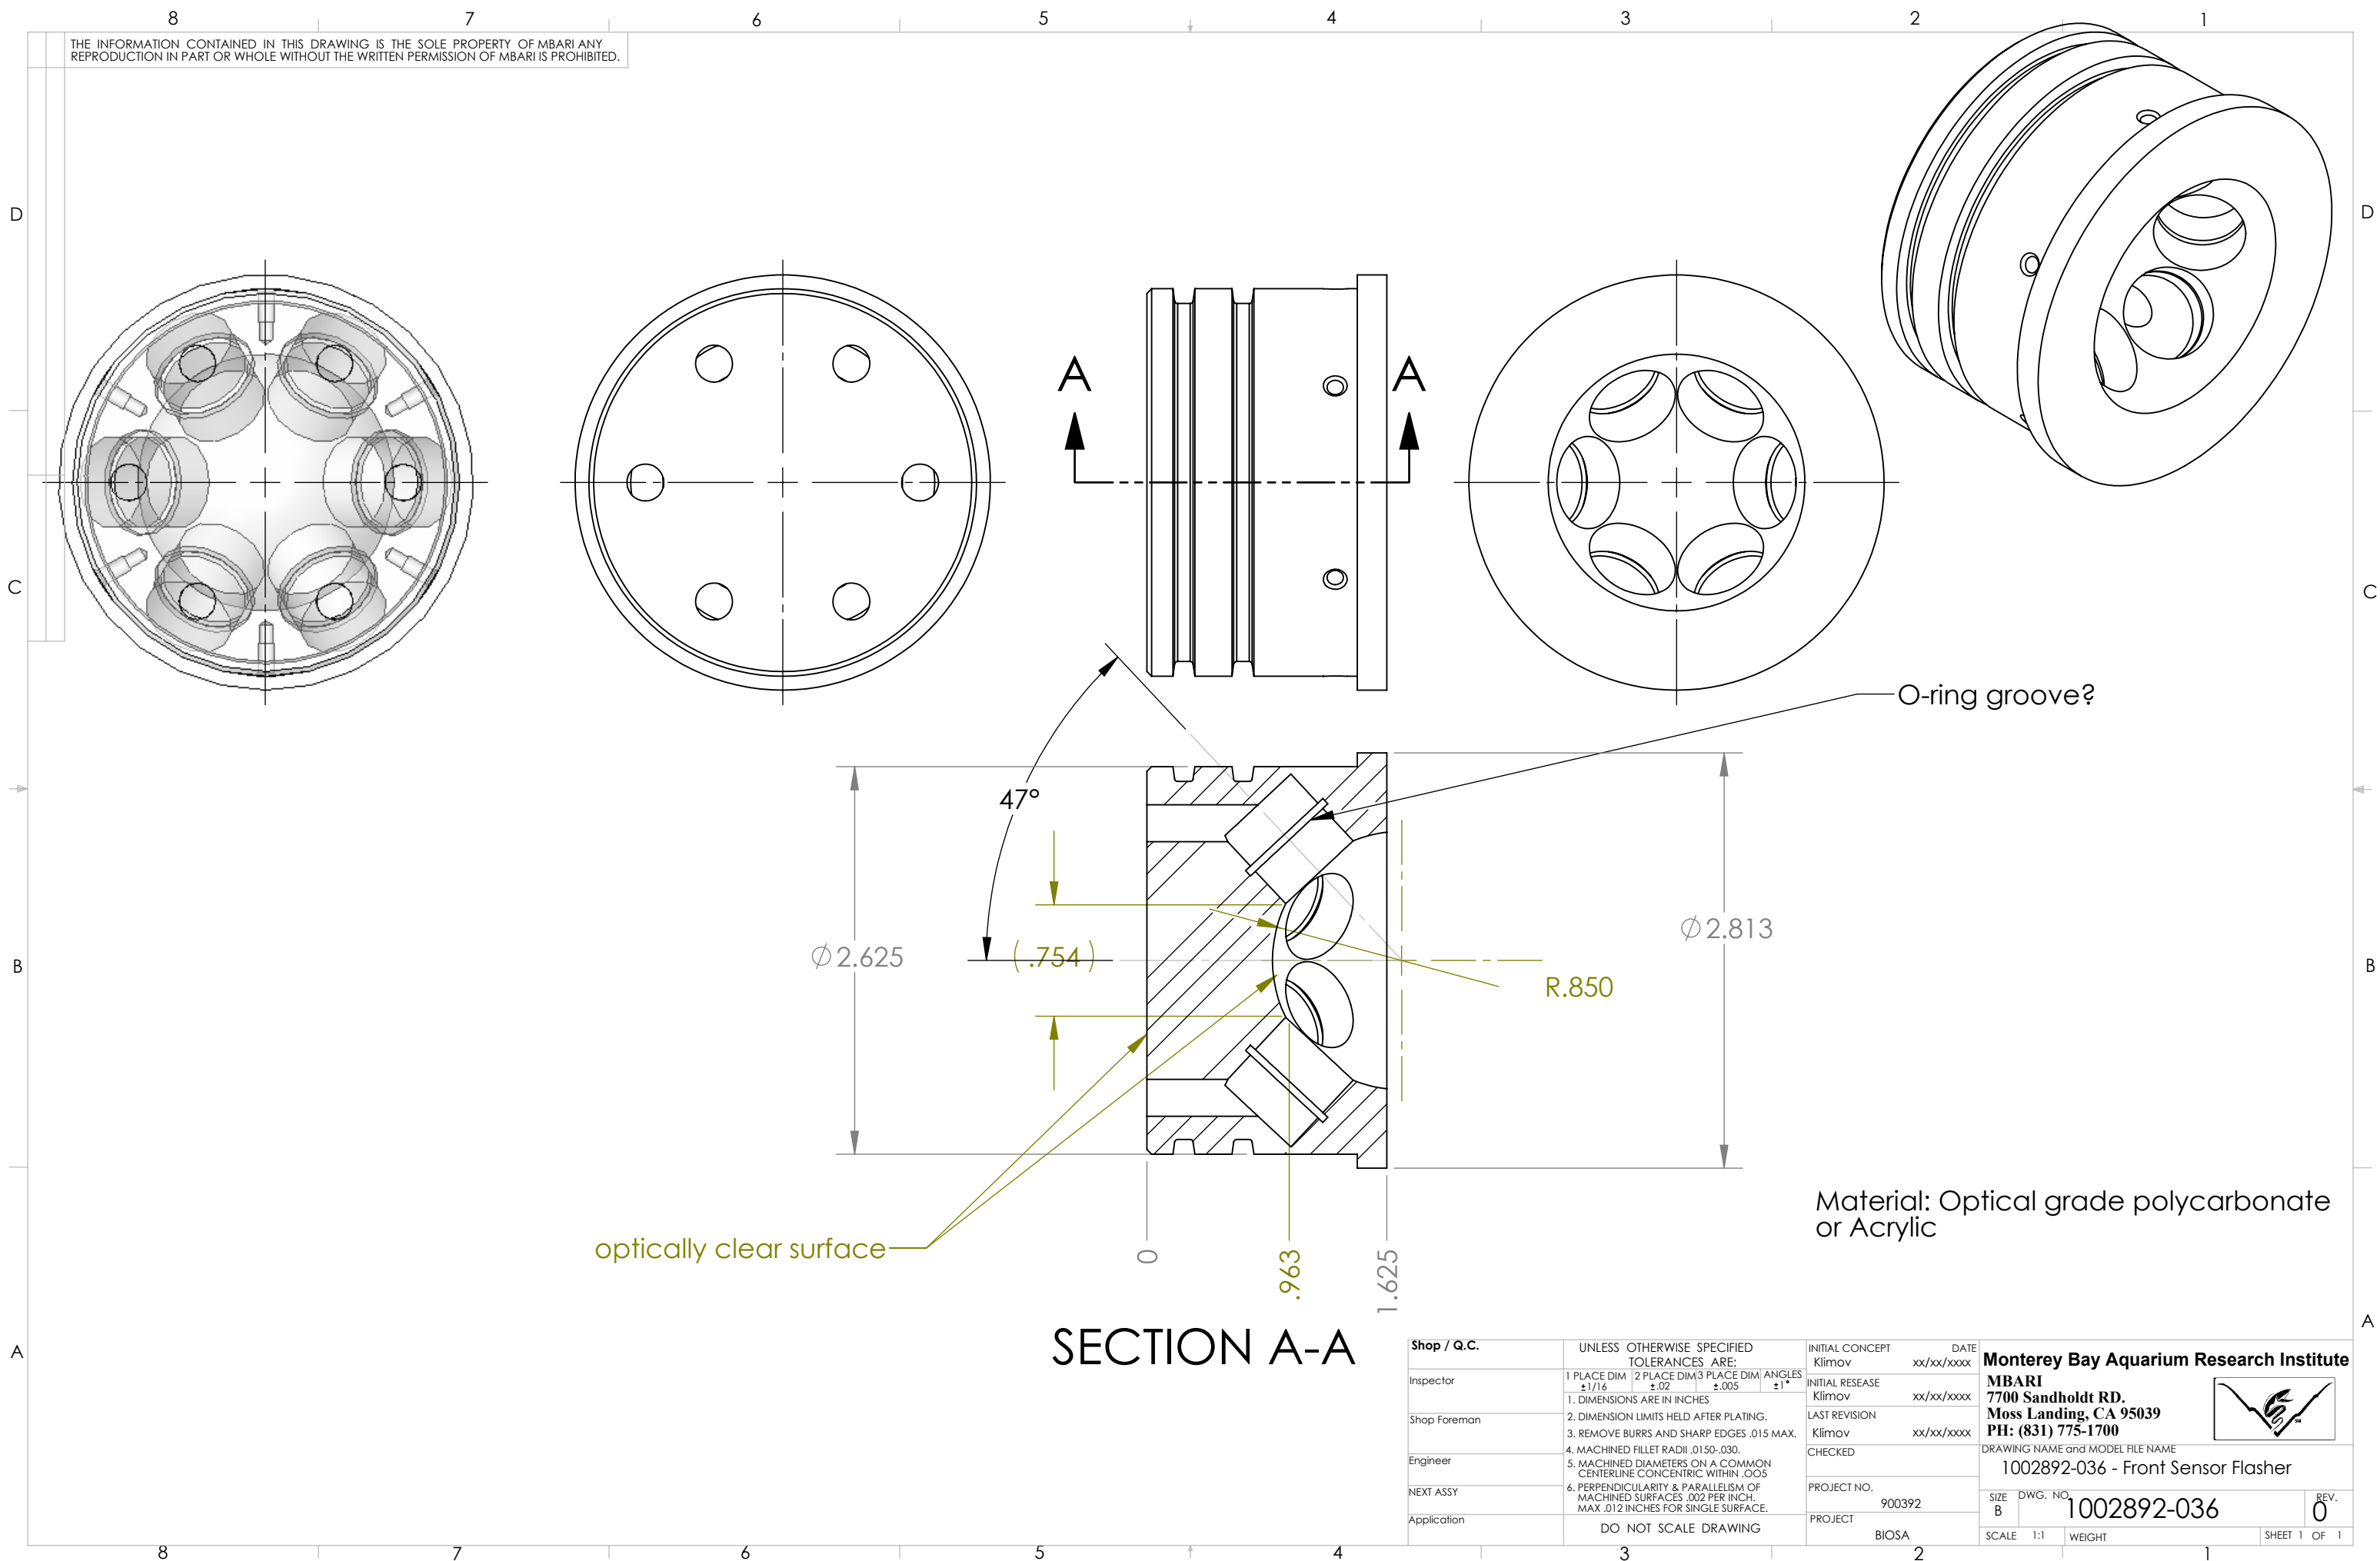

SECTION A-A

Shop / Q.C.	UNLESS OTHERWISE SPECIFIED TOLERANCES ARE:	INITIAL CONCEPT Klimov	DATE xx/xx/xxxx	Monterey Bay Aquarium Research Institute	
Inspector	1 PLACE DIM $\pm 1/16$ 2 PLACE DIM $\pm .02$ 3 PLACE DIM $\pm .005$ ANGLES $\pm 1^\circ$	INITIAL RESEAL Klimov	xx/xx/xxxx		
Shop Foreman	1. DIMENSIONS ARE IN INCHES	LAST REVISION Klimov	xx/xx/xxxx	MBARI 7700 Sandholdt RD. Moss Landing, CA 95039 PH: (831) 775-1700	
Engineer	2. DIMENSION LIMITS HELD AFTER PLATING.	CHECKED			
NEXT ASSY	3. REMOVE BURRS AND SHARP EDGES .015 MAX.	PROJECT NO.	900392	DRAWING NAME and MODEL FILE NAME 1002892-036 - Front Sensor Flasher	
Application	4. MACHINED FILLET RADII .0150-.030.	PROJECT	BIOSA		
	5. MACHINED DIAMETERS ON A COMMON CENTERLINE CONCENTRIC WITHIN .005.	SCALE	1:1	SIZE B	DWG. NO. 1002892-036
	6. PERPENDICULARITY & PARALLELISM OF MACHINED SURFACES .002 PER INCH. MAX .012 INCHES FOR SINGLE SURFACE.	WEIGHT		REV. 0	SHEET 1 OF 1
	DO NOT SCALE DRAWING				