


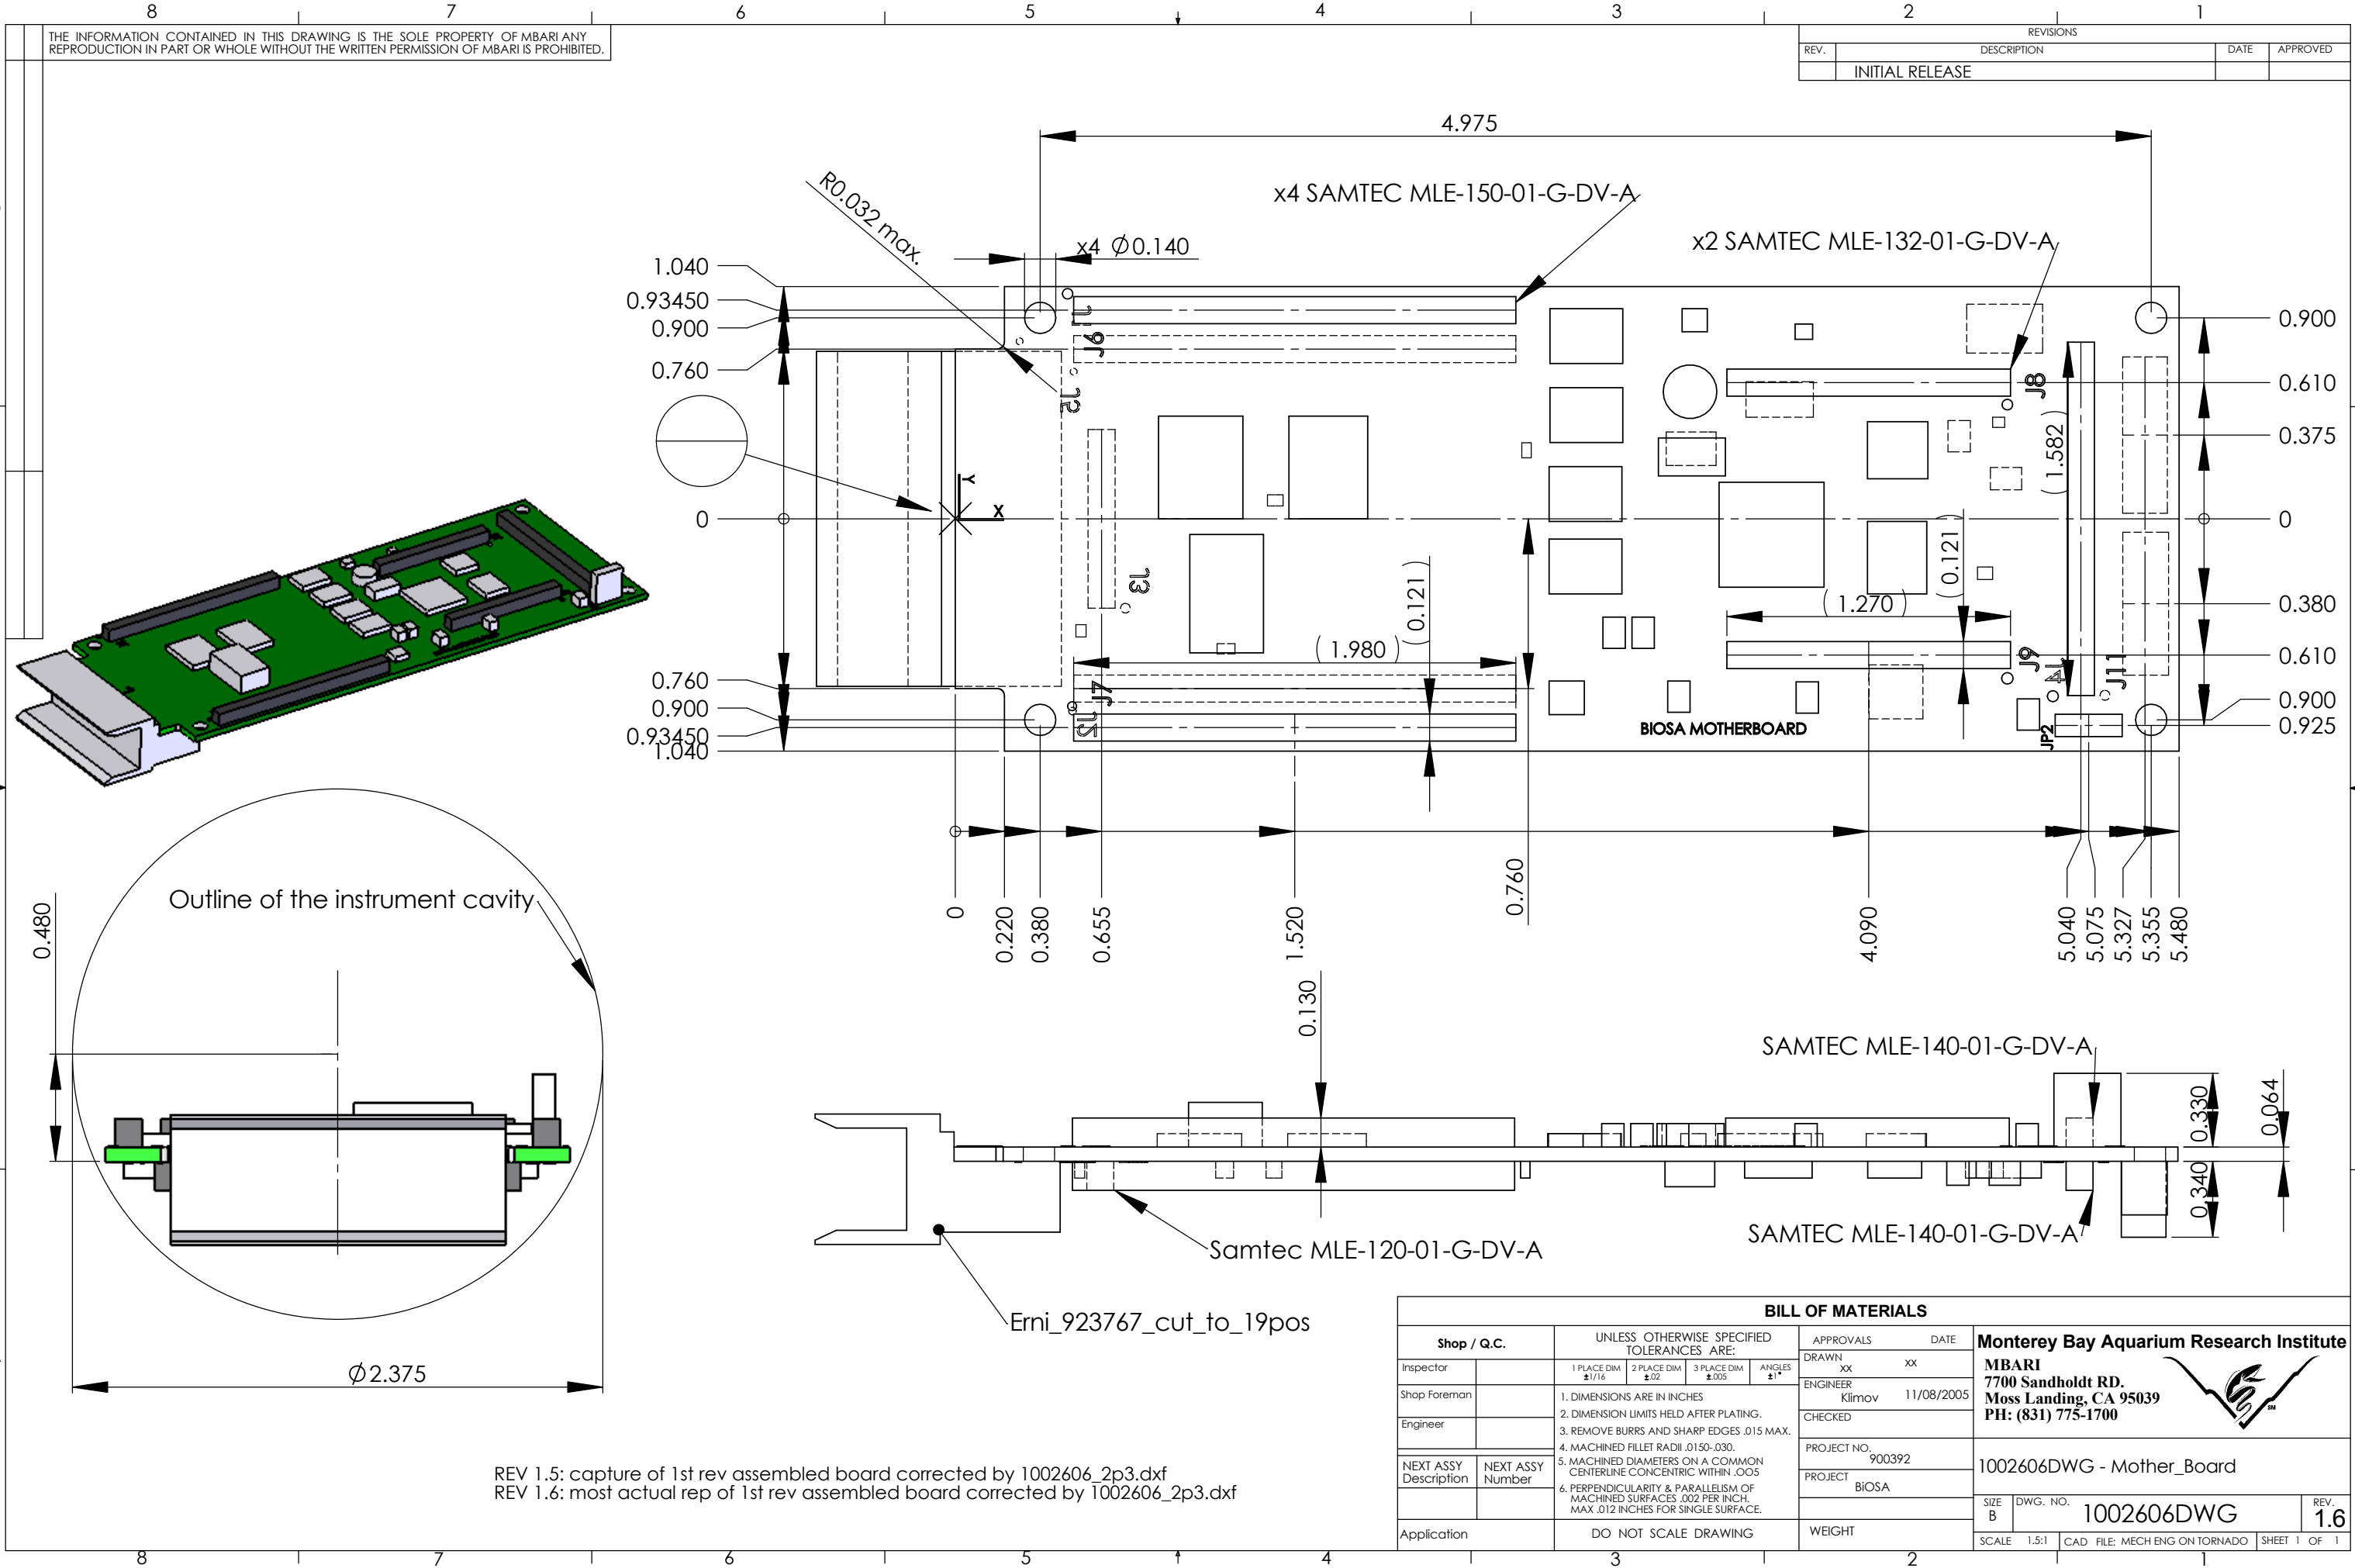

REV 1.5: capture of 1st rev assembled board corrected by 1002606_2p3.dxf
REV 1.6: most actual rep of 1st rev assembled board corrected by 1002606_2p3.dxf

BILL OF MATERIALS											
Shop / Q.C.		UNLESS OTHERWISE SPECIFIED TOLERANCES ARE:				APPROVALS		DATE		Monterey Bay Aquarium Research Institute MBARI 7700 Sandholdt RD. Moss Landing, CA 95039 PH: (831) 775-1700 	
Inspector		1 PLACE DIM ±1/16	2 PLACE DIM ±.02	3 PLACE DIM ±.005	ANGLES ±1°	DRAWN	XX	XX			
Shop Foreman		1. DIMENSIONS ARE IN INCHES 2. DIMENSION LIMITS HELD AFTER PLATING. 3. REMOVE BURRS AND SHARP EDGES .015 MAX. 4. MACHINED FILLET RADII .0150-.030. 5. MACHINED DIAMETERS ON A COMMON CENTERLINE CONCENTRIC WITHIN .005 6. PERPENDICULARITY & PARALLELISM OF MACHINED SURFACES .002 PER INCH, MAX .012 INCHES FOR SINGLE SURFACE.				ENGINEER	Klimov	11/08/2005			
Engineer						CHECKED					
NEXT ASSY Description	NEXT ASSY Number					PROJECT NO.	900392		1002606DWG - Mother_Board		
						PROJECT	BIOSA				
Application		DO NOT SCALE DRAWING				WEIGHT		SIZE B	DWG. NO. 1002606DWG	REV. 1.6	
						SCALE	1.5:1	CAD FILE: MECH ENG ON TORNADO		SHEET 1 OF 1	

Monterey Bay Aquarium Research Institute
MBARI
7700 Sandholdt RD.
Moss Landing, CA 95039
PH: (831) 775-1700

1002606DWG - Mother_Board