


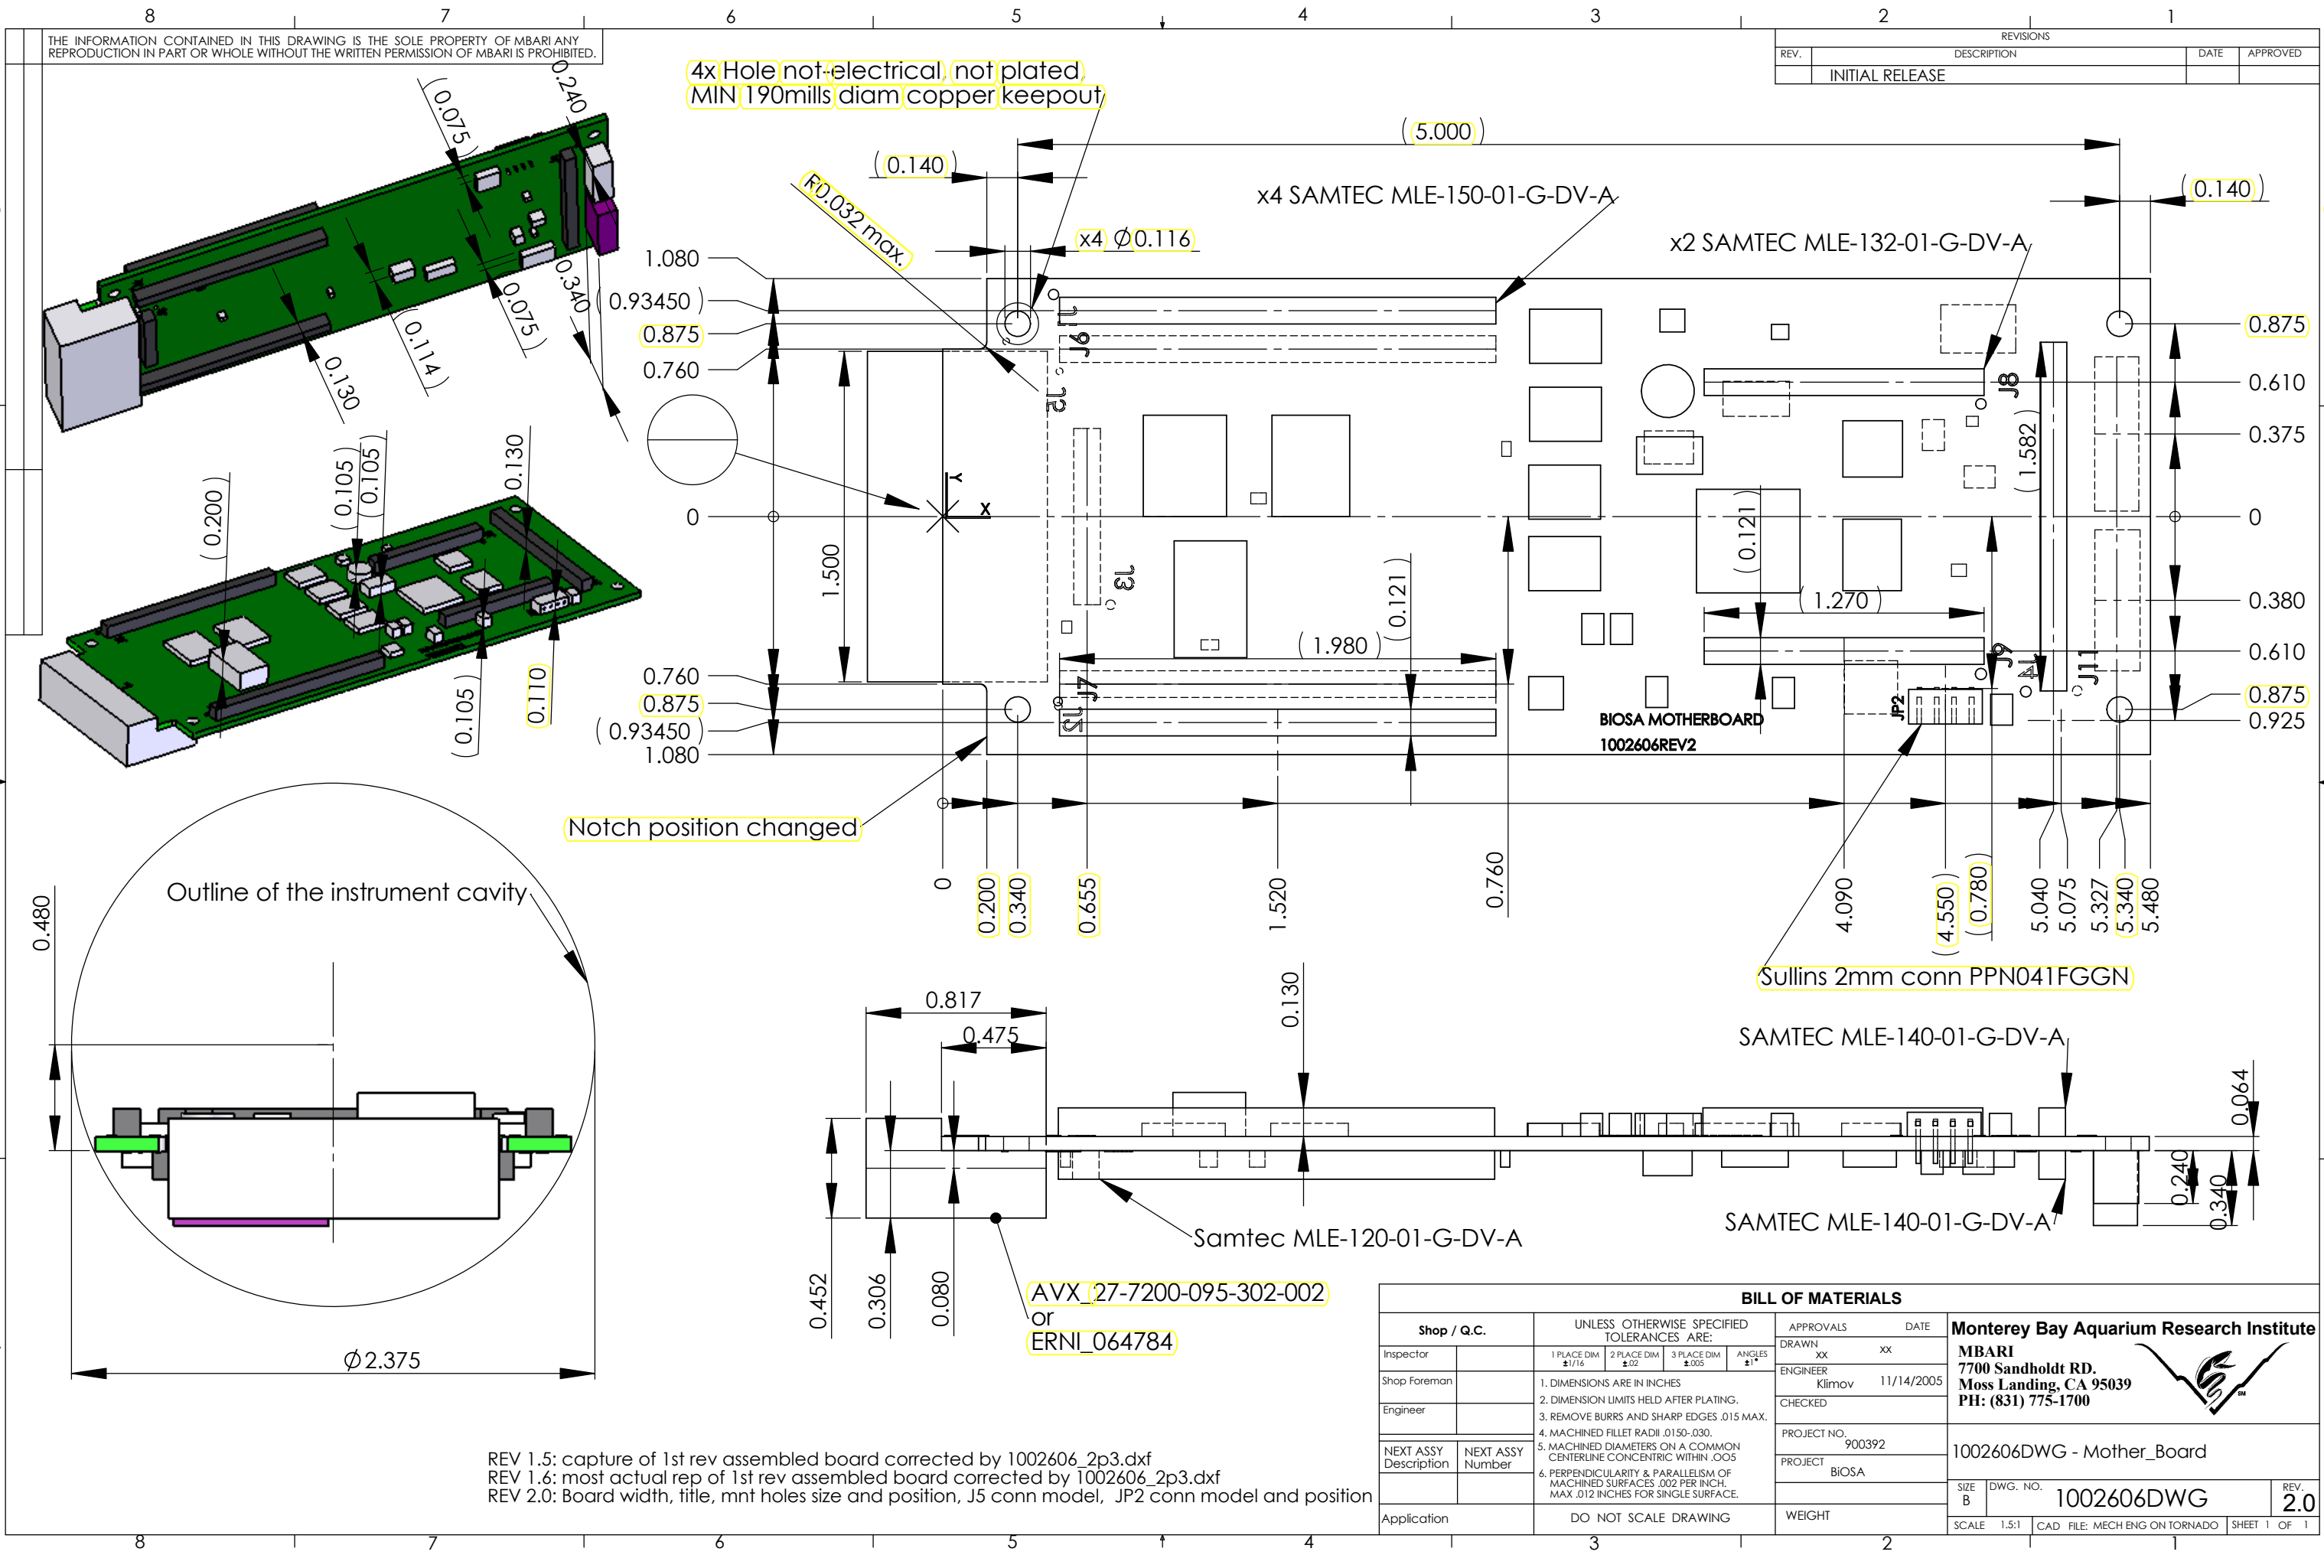

REV 1.5: capture of 1st rev assembled board corrected by 1002606_2p3.dxf
REV 1.6: most actual rep of 1st rev assembled board corrected by 1002606_2p3.dxf
REV 2.0: Board width, title, mnt holes size and position, J5 conn model, JP2 conn model and position

Shop / Q.C.				UNLESS OTHERWISE SPECIFIED TOLERANCES ARE:				APPROVALS		DATE		Monterey Bay Aquarium Research Institute			
Inspector				1 PLACE DIM $\pm 1/16$	2 PLACE DIM $\pm .02$	3 PLACE DIM $\pm .005$	ANGLES $\pm 1^\circ$	DRAWN	XX	XX		MBARI 7700 Sandholdt RD. Moss Landing, CA 95039 PH: (831) 775-1700			
Shop Foreman				1. DIMENSIONS ARE IN INCHES				ENGINEER	Klimov	11/14/2005					
Engineer				2. DIMENSION LIMITS HELD AFTER PLATING.				CHECKED				1002606DWG - Mother_Board			
				3. REMOVE BURRS AND SHARP EDGES .015 MAX.				PROJECT NO.	900392						
NEXT ASSY Description				4. MACHINED FILLET RADII .015-.030.				PROJECT	BIOSA			SIZE B DWG. NO. 1002606DWG REV. 2.0			
				5. MACHINED DIAMETERS ON A COMMON CENTERLINE CONCENTRIC WITHIN .005											
				6. PERPENDICULARITY & PARALLELISM OF MACHINED SURFACES .002 PER INCH. MAX .012 INCHES FOR SINGLE SURFACE.				WEIGHT				SCALE 1:5:1 CAD FILE: MECH ENG ON TORNADO SHEET 1 OF 1			
Application				DO NOT SCALE DRAWING											