
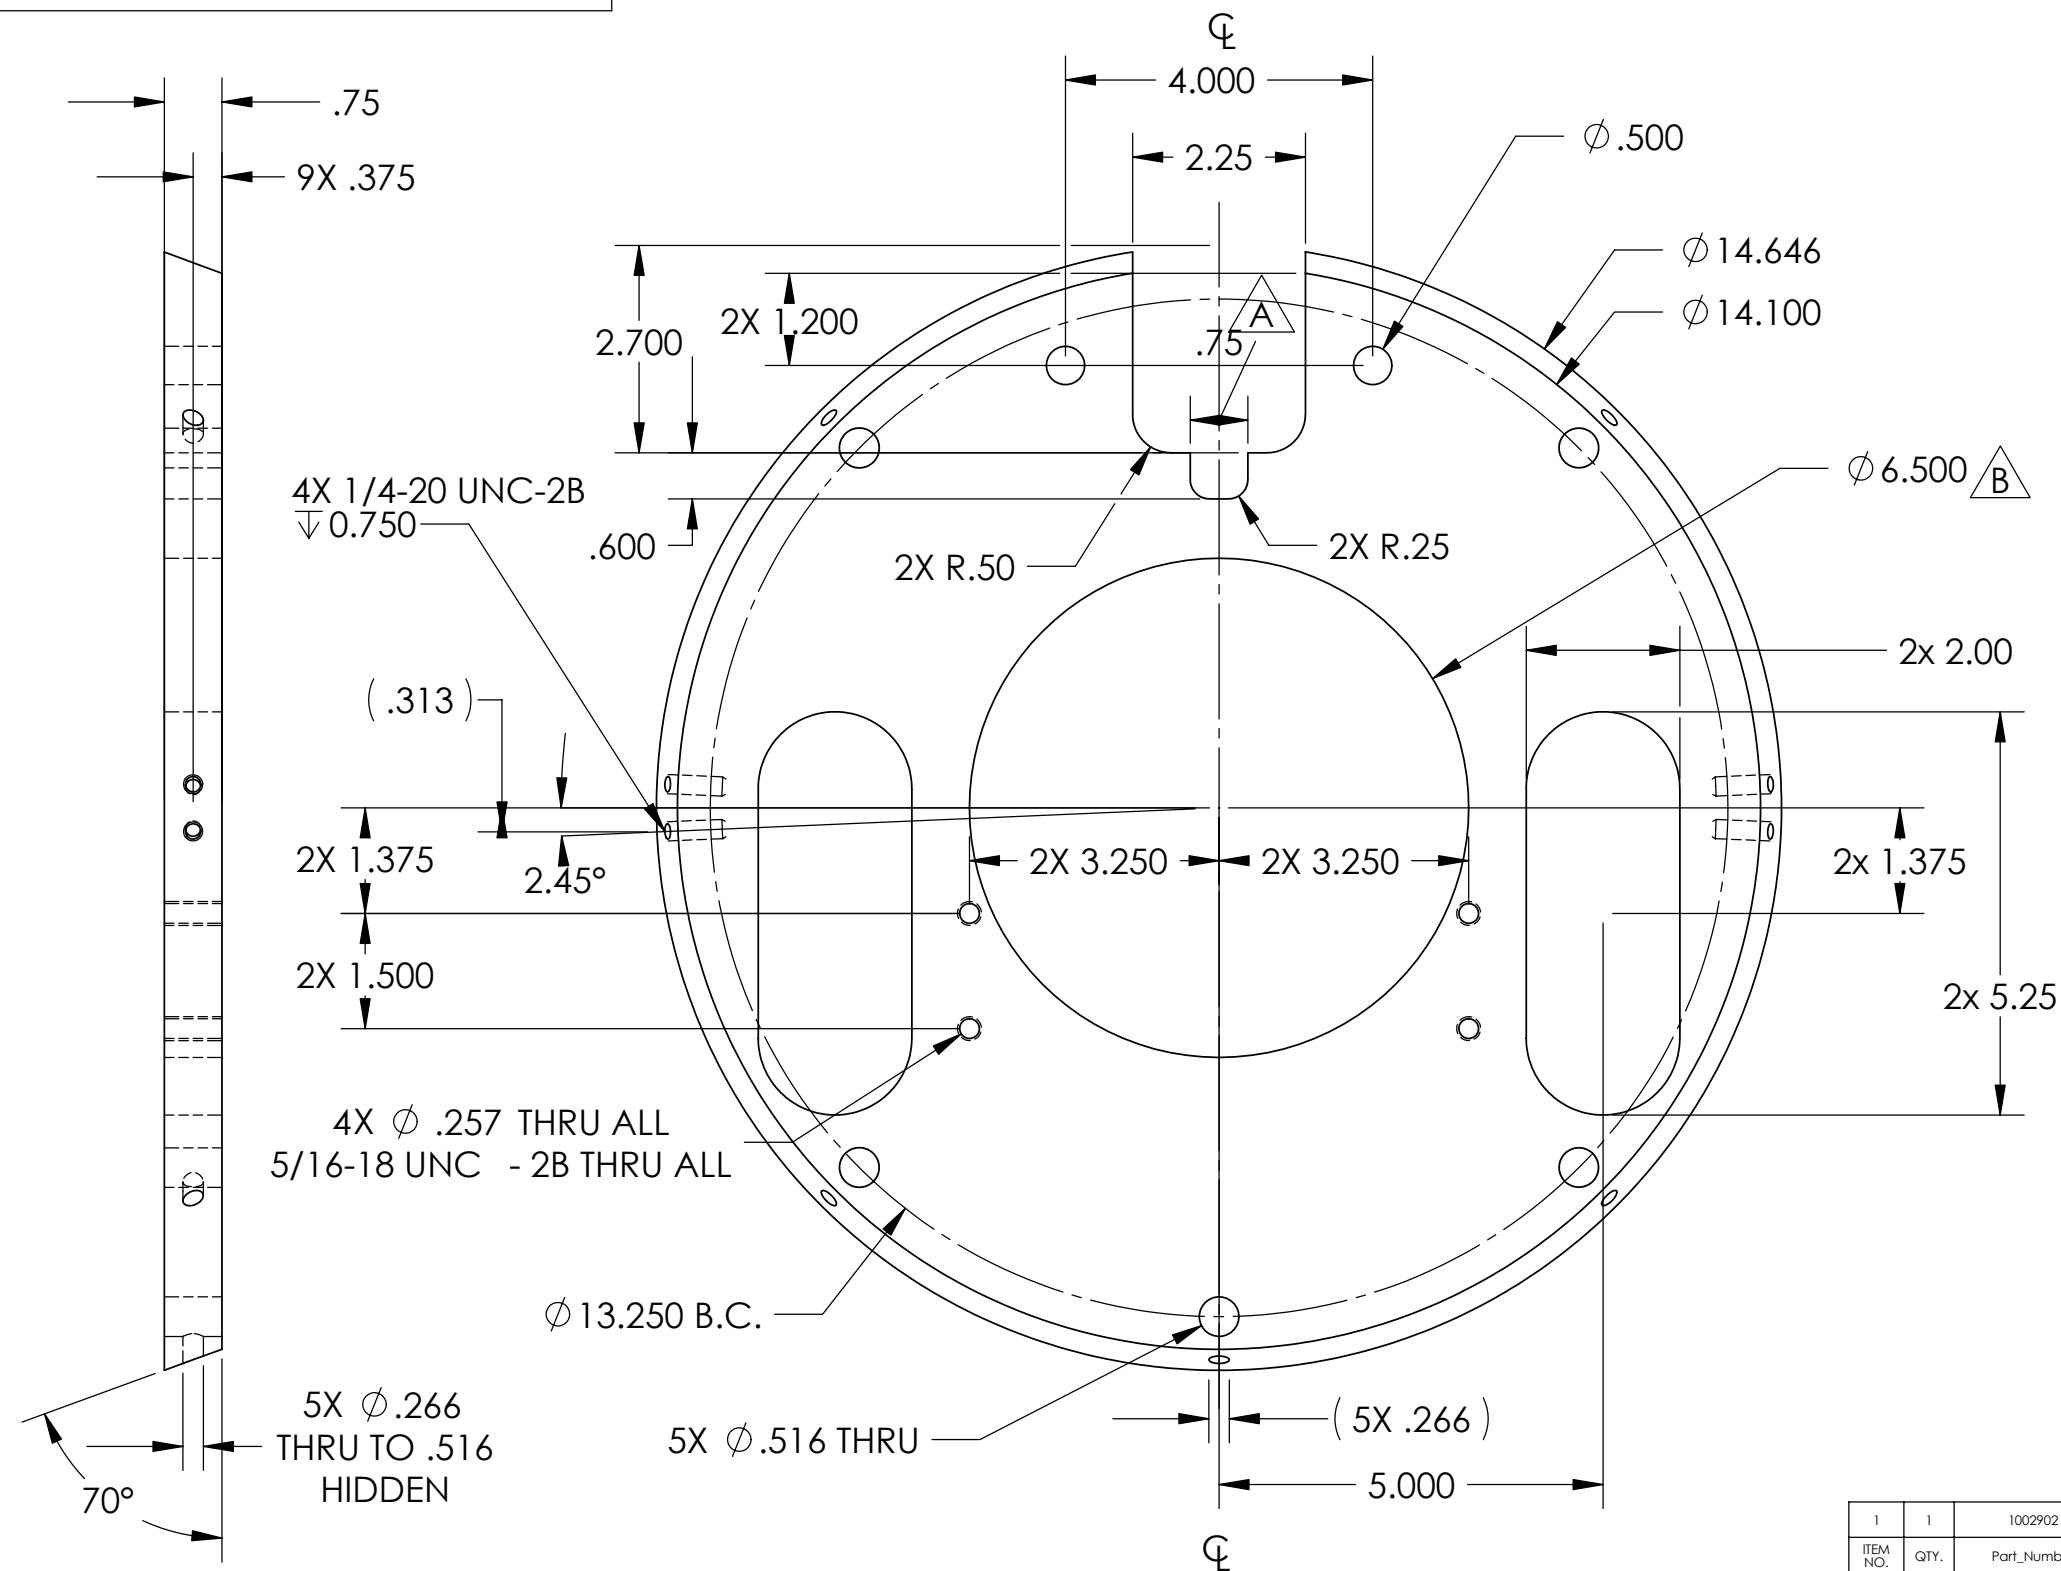


THE INFORMATION CONTAINED IN THIS DRAWING IS THE SOLE PROPERTY OF MBARI.
ANY REPRODUCTION IN PART OR WHOLE WITHOUT THE WRITTEN PERMISSION OF MBARI
IS PROHIBITED.

REVISIONS			
REV.	DESCRIPTION	DATE	APPROVED
	INITIAL RELEASE		
REV.	DESCRIPTION	DATE	APPROVED
A	ADDED .75 NOTCH	11/29/2005	J.E.
B	CHG. BORE DIA. TO 6.500 FRM 6.000 (4000m USBL)	4/5/2006	J.E.

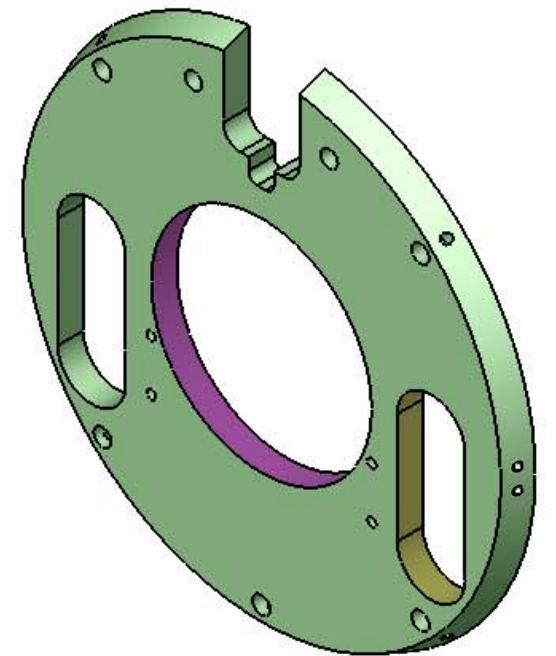

8. All dimensions are symmetric about common center lines unless specified otherwise.

7. Project Library:\900393_AUV_Docking\Mech_Drawings\
AUV_Drawings\Altex Nose\ALTEx Mod Towhook

NOTES: (CONT. FROM TITLE BLOCK)

1	1	1002902	TowHook Bulkhead			UHMW P.E.
ITEM NO.	QTY.	Part_Number	DESCRIPTION		VENDOR	MATERIAL
BILL OF MATERIALS						
UNLESS OTHERWISE SPECIFIED TOLERANCES ARE:			APPROVALS	DATE	Monterey Bay Aquarium Research Institute  7700 Sandholdt RD. Moss Landing, CA 95039 PH: (408) 775-1700	
1 PLACE DIM ±1/16	2 PLACE DIM ±.02	3 PLACE DIM ±.005	ANGLES ±1°	DRAWN J. ERICKSON 10/19/05 ENGINEER		
1. DIMENSIONS ARE IN INCHES 2. DIMENSION LIMITS HELD AFTER PLATING. 3. REMOVE BURRS AND SHARP EDGES .015 MAX. 4. MACHINED FILLET RADII .0150-.030. 5. MACHINED DIAMETERS ON A COMMON CENTERLINE CONCENTRIC WITHIN .005 6. PERPENDICULARITY & PARALLELISM OF MACHINED SURFACES .002 PER INCH. MAX .012 INCHES FOR SINGLE SURFACE.				CHECKED		
			PROJECT NO.	AUV Docking Vehicle ALTEX Towhook_Bulkhead_Docker		
			900353 PROJECT AUV Docking			
DO NOT SCALE DRAWING			WEIGHT	SIZE B DWG. NO. 1002902.DWG	REV. B	
				SCALE NONE	CAD FILE: TORNADO\ARCHIVE	SHEET 1 OF 1