



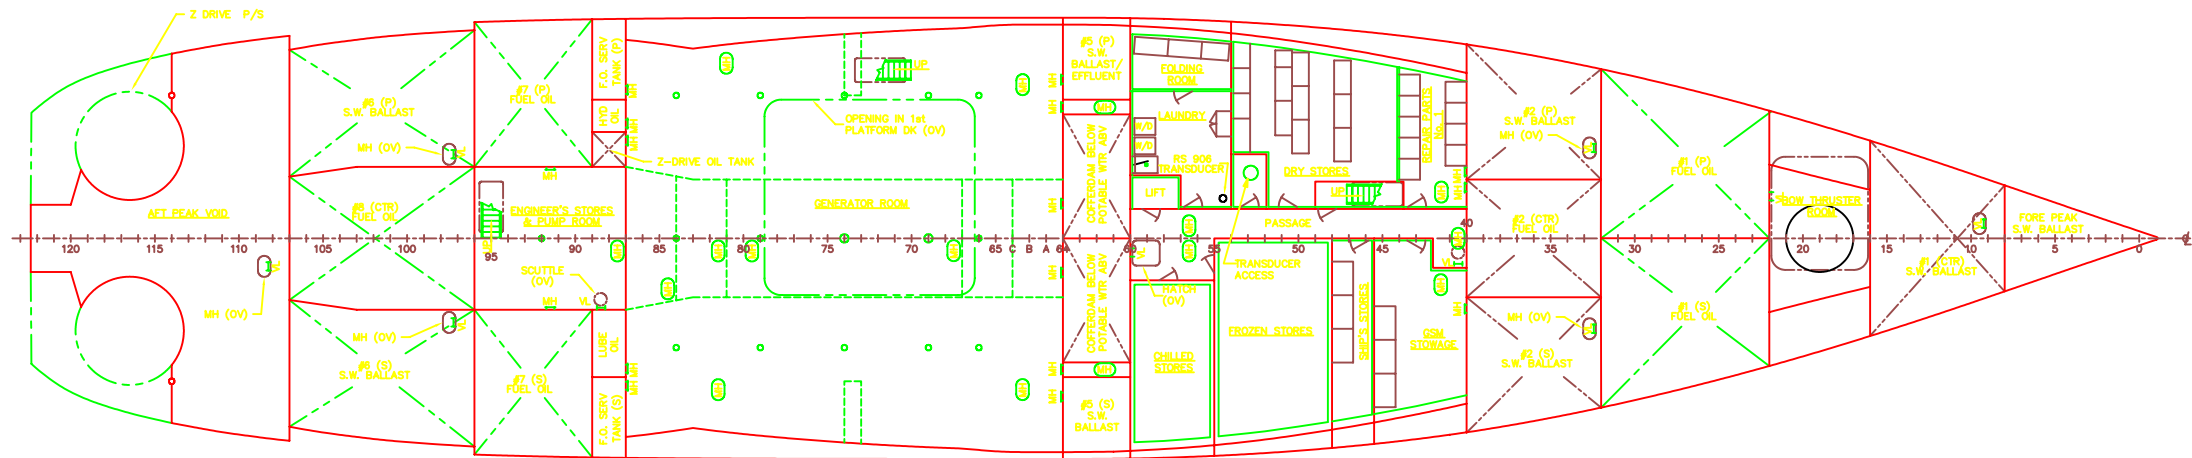

HOLD & TANK TOP PLAN

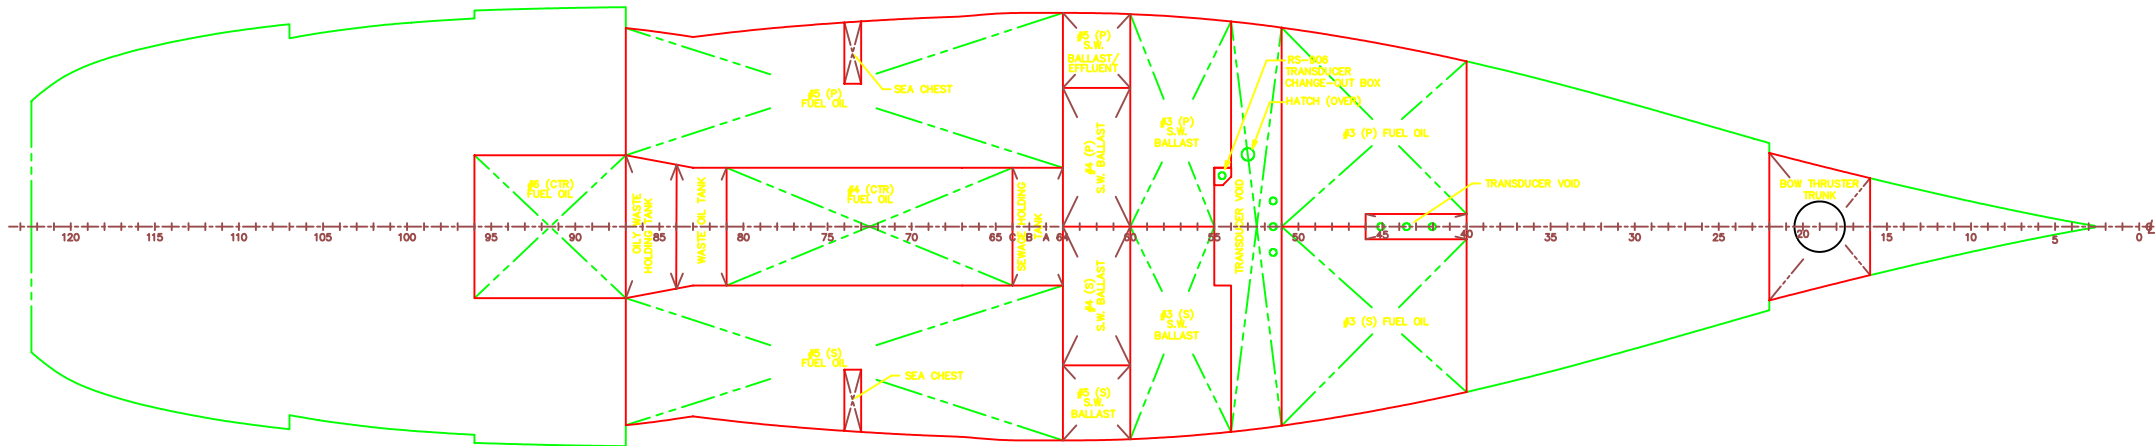

DOUBLE BOTTOM PLAN

REVISIONS				
REV	ZONE	DESCRIPTION	BY	DATE

REFERENCES	
1.	USN DWG NO. 6607827, REV F: OUTBOARD PROFILE P/S
2.	USN DWG NO. 6607828, REV D: INBOARD PROFILE P/S
3.	USN DWG NO. 6607829, REV F: GENERAL ARRANGEMENT - DOUBLE BOTTOM, HOLD, & TANK TOP
4.	USN DWG NO. 6607831, REV E: GENERAL ARRANGEMENT - 01 LEVEL & 02 LEVEL
5.	USN DWG NO. 6607832, REV E: GENERAL ARRANGEMENT - 03 LEVEL, 04 LEVEL, & 05 LEVEL

GENERAL NOTES	
1.	THIS DRAWING DEVELOPED FROM REFERENCES 1 THROUGH 4, UPDATED TO REFLECT POST-DELIVERY MODIFICATIONS TO VESSEL.

Approved by		UNIVERSITY OF WASHINGTON SEATTLE, WASHINGTON	
Drawn by		R/V THOMAS G. THOMPSON	
Checked by		GENERAL ARRANGEMENT DOUBLE BOTTOM & HOLD PLAN	
Plotting Scale		THE GLOSTEN ASSOCIATES, Inc. CONSULTING ENGINEERS SERVING THE MARINE COMMUNITY	
AutoCAD File Name		800 Mutual Life Building • 800 First Avenue • Seattle, Washington 98104-3224	
71103-1A.DWG		Drawing No.	
1=96		9171-103	
1/8" = 1'-0"		Sheet 1 of 4	