TIBURON HDTV BLOCK DIAGRAM

Thursday, May 19th, 2005

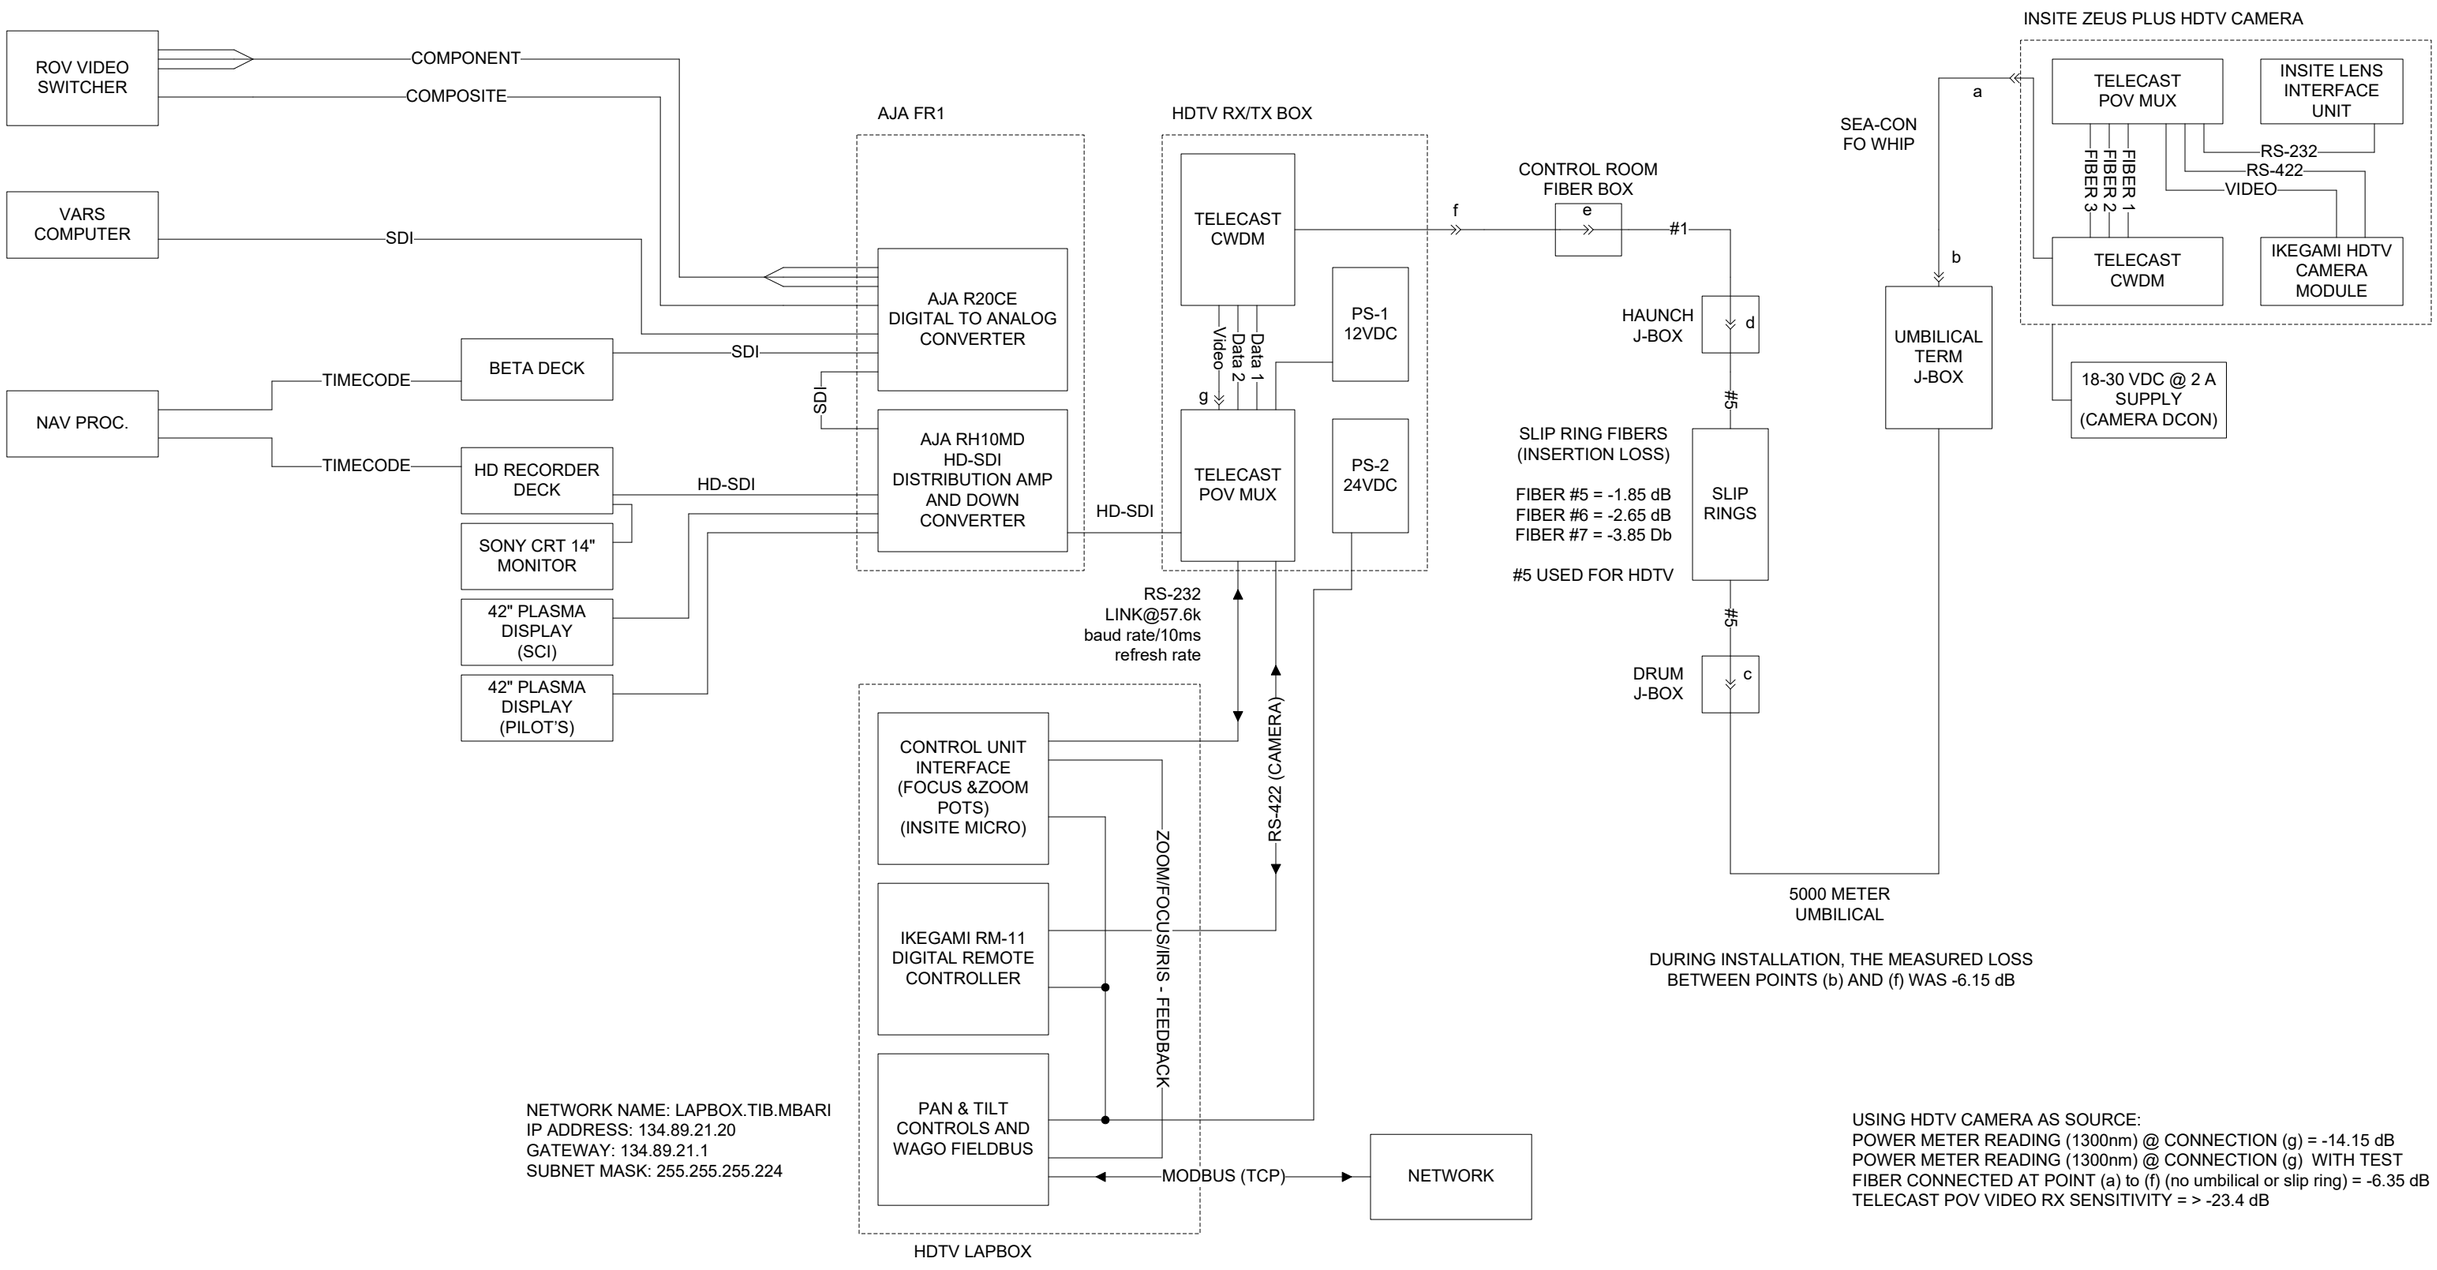

NETWORK NAME: LAPBOX.TIB.MBARI
IP ADDRESS: 134.89.21.20
GATEWAY: 134.89.21.1
SUBNET MASK: 255.255.255.224

DURING INSTALLATION, THE MEASURED LOSS BETWEEN POINTS (b) AND (f) WAS -6.15 dB

USING HDTV CAMERA AS SOURCE:
POWER METER READING (1300nm) @ CONNECTION (g) = -14.15 dB
POWER METER READING (1300nm) @ CONNECTION (g) WITH TEST FIBER CONNECTED AT POINT (a) to (f) (no umbilical or slip ring) = -6.35 dB
TELECAST POV VIDEO RX SENSITIVITY = > -23.4 dB