

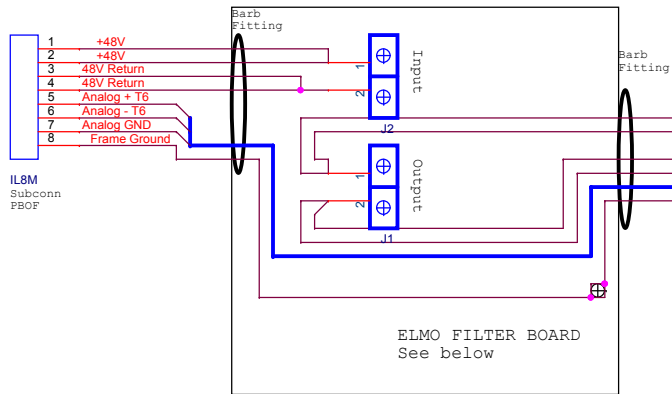


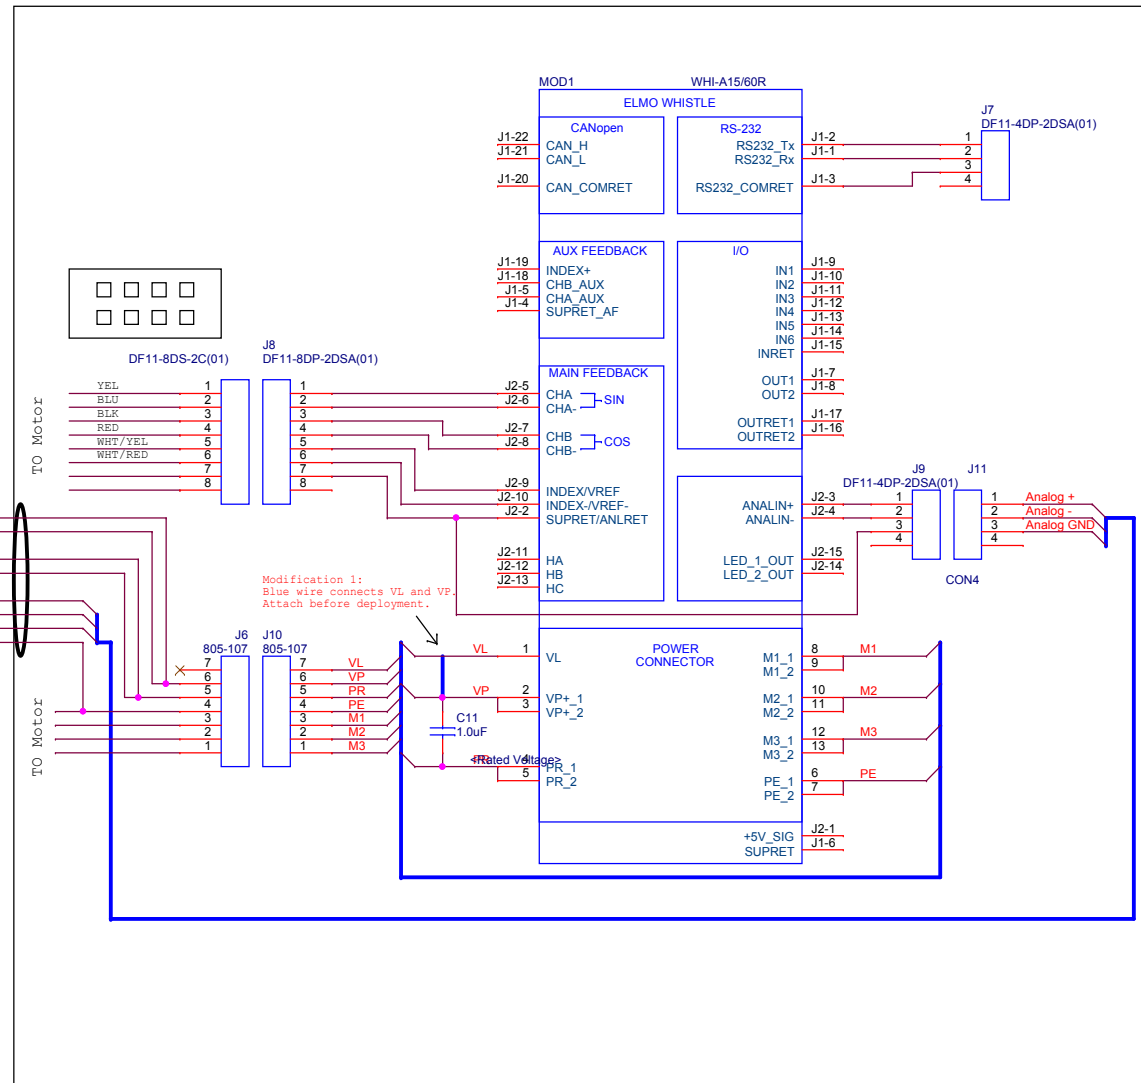

ELMO FILTER BOARD
See below

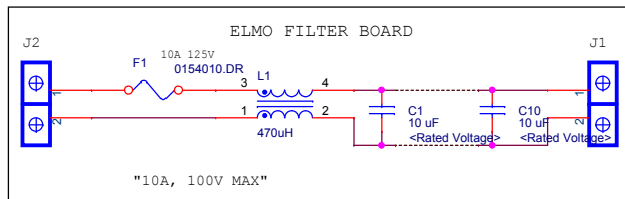

YEL

		Monterey Bay Aquarium Research Institute 7700 Sandhold Road, Moss Landing, CA 95039	
		Title MiniROV: Thruster Motor Assm.	
Engineer A. Sherman	Size B	Document Number <Doc>	Layout File <Layout File>
Layout <Layout>	Date Tuesday, March 15, 2016	Sheet 1	of 1