


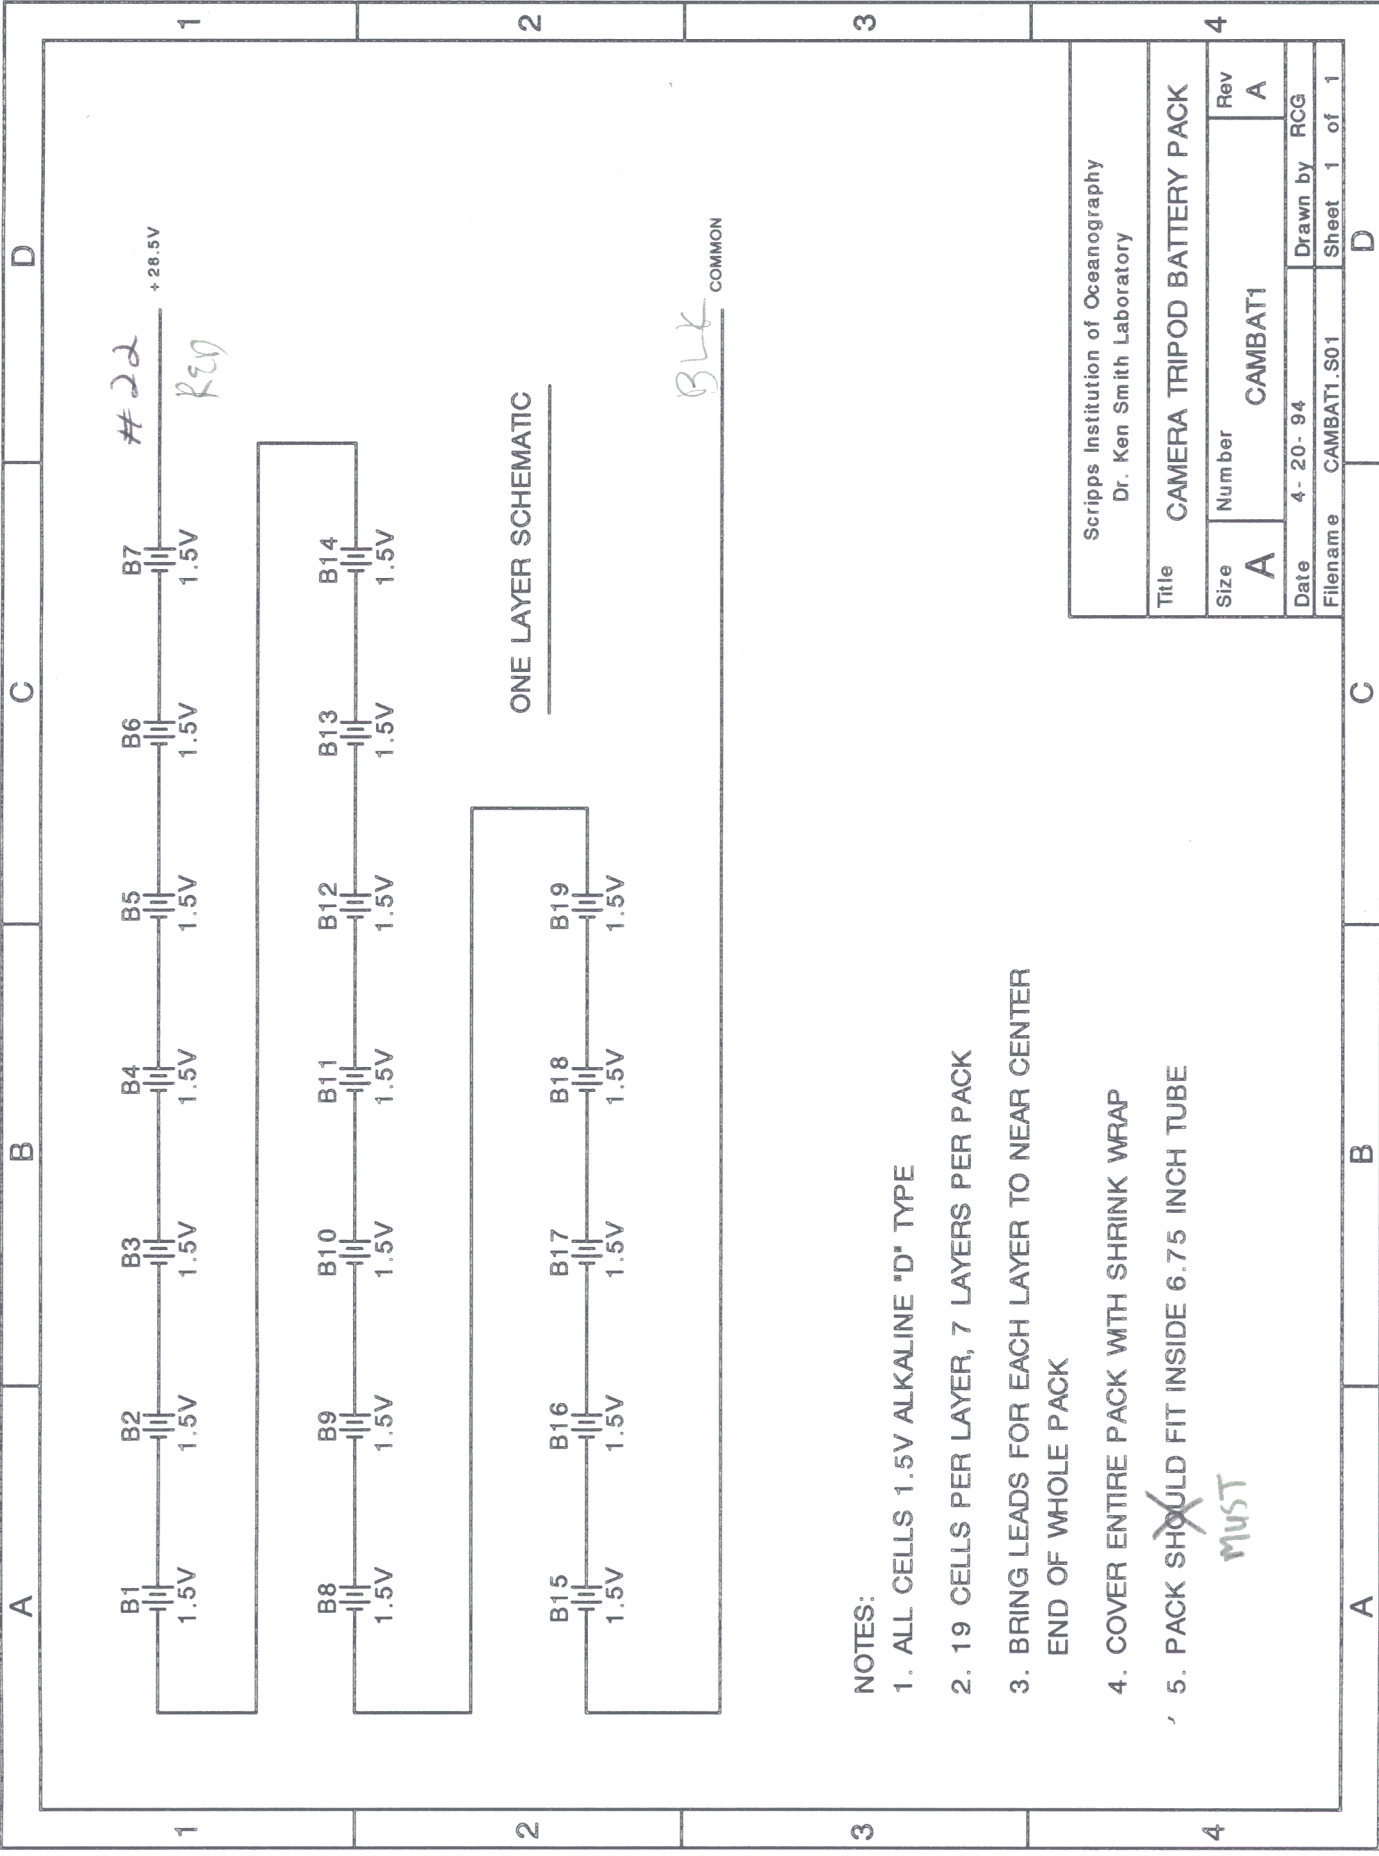

NOTES:

- 1. ALL CELLS 1.5V ALKALINE "D" TYPE
- 2. 19 CELLS PER LAYER, 7 LAYERS PER PACK
- 3. BRING LEADS FOR EACH LAYER TO NEAR CENTER END OF WHOLE PACK
- 4. COVER ENTIRE PACK WITH SHRINK WRAP
- 5. PACK SHOULD FIT INSIDE 6.75 INCH TUBE

Scripps Institution of Oceanography Dr. Ken Smith Laboratory			
Title CAMERA TRIPOD BATTERY PACK			
Date 4-20-94	Drawn by RCG		
Filename CAMBAT1.S01	Sheet 1	of 1	

