



To Controller
Can

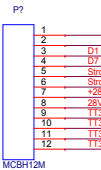

To Communication/
Deck Cable

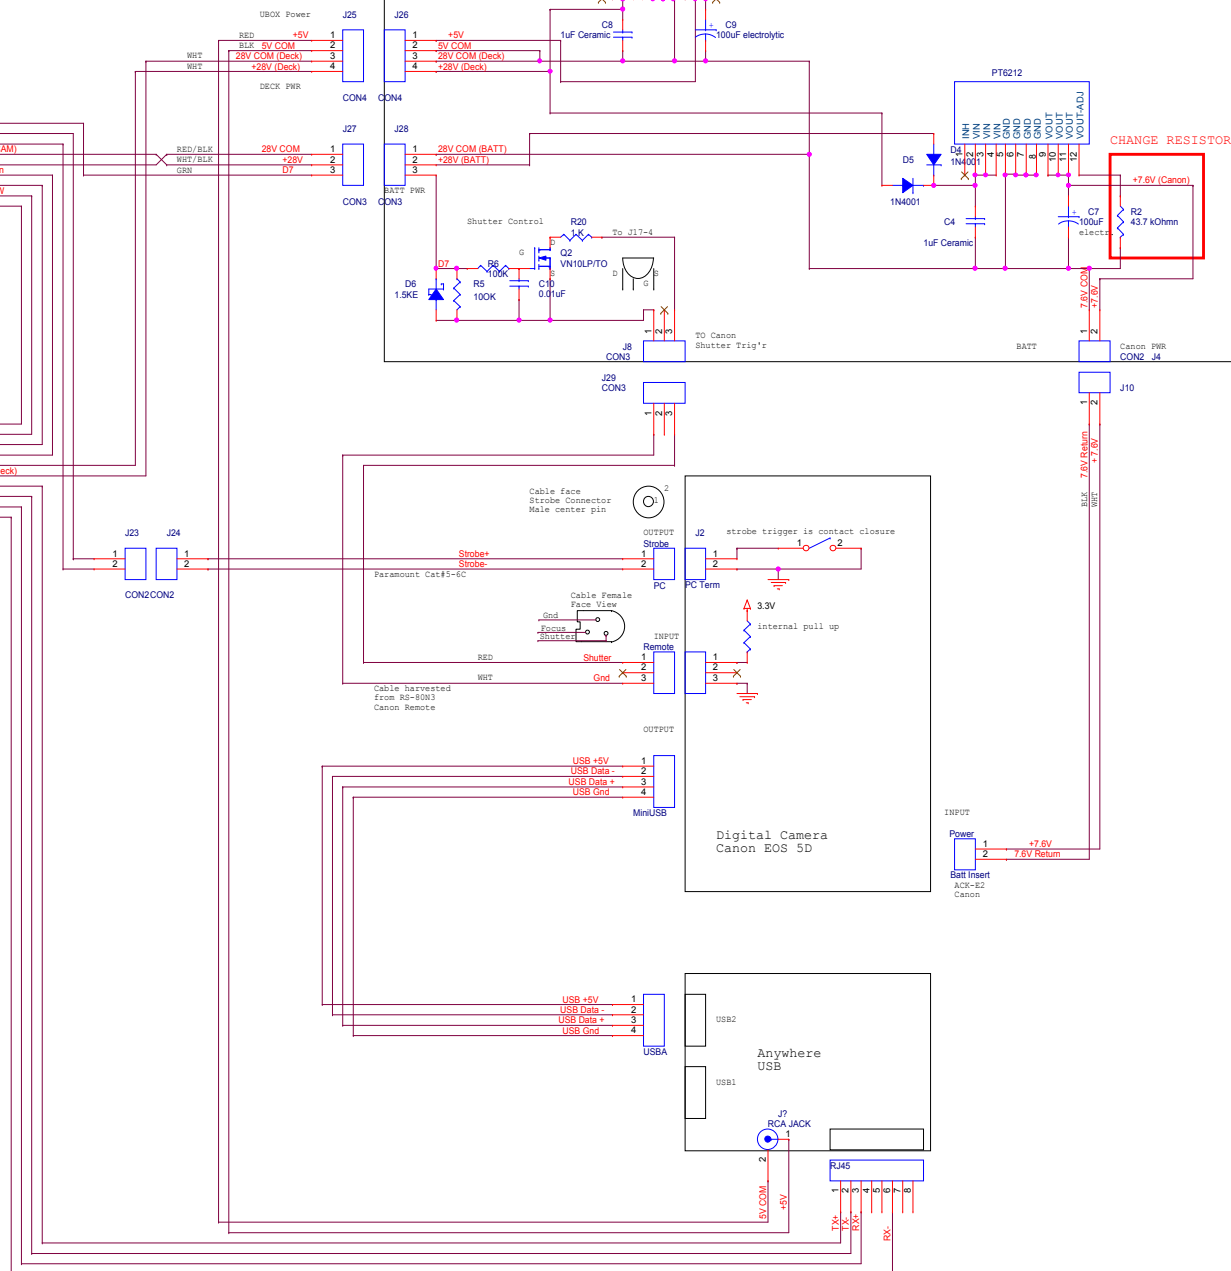

Note on Digital Camera:
Digital camera is always off
except when taking a picture.
A Relay on the tattle tale will switch the
+28V that feeds
7.6V regulator which powers
the camera, a second signal (D7) is needed
to trigger the camera.

Note on Camera Cables:
Shutter trigger cable harvested from Canon Remote (pn. RS-80N3)
Strobe cable is from PC sync cable
USB cable is mini-USB to USB A
Power input to the camera comes from AC adapter shaped
to fit into battery housing, canon pn. ACK-E2

 Monterey Bay Aquarium Research Institute 7700 Sandhold Road, Moss Landing, CA 95039				
Title				
Engineer	Doc#	Document Number	Rev	
<Engineer>	C	<Doc>	<Rev>	<Rev>
Layout	File	Layout File	Sheet 1 of 1	
<Layout>	File	Layout File	Sheet 1 of 1	