

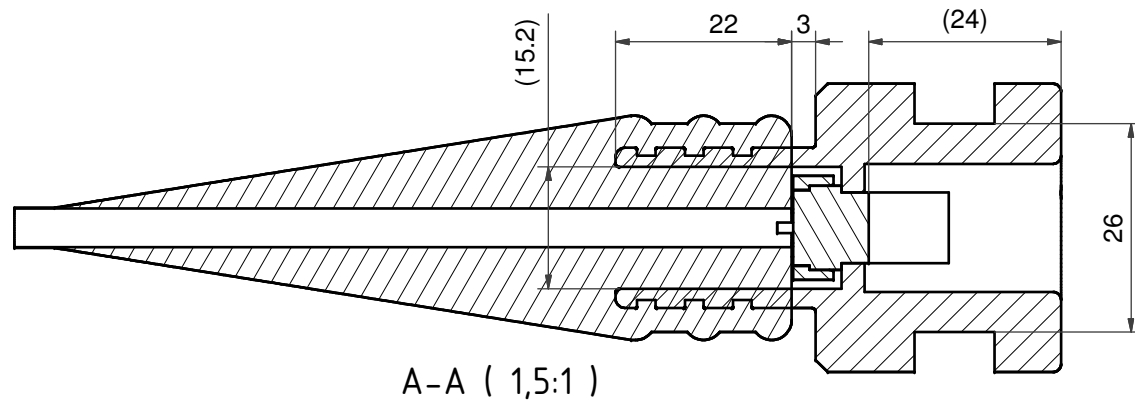
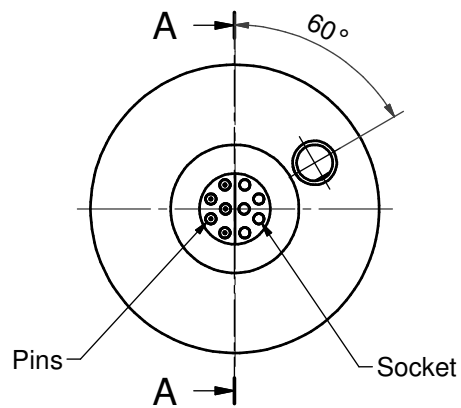
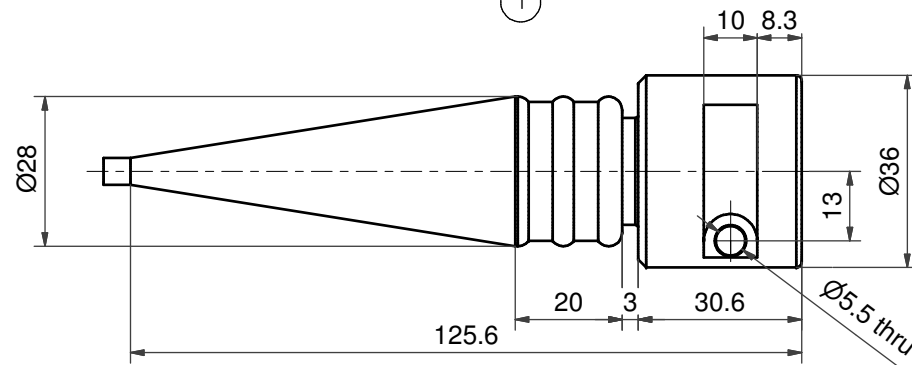


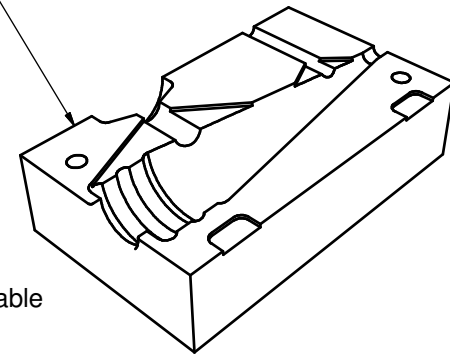

Use potting mold:
4000060+4000061

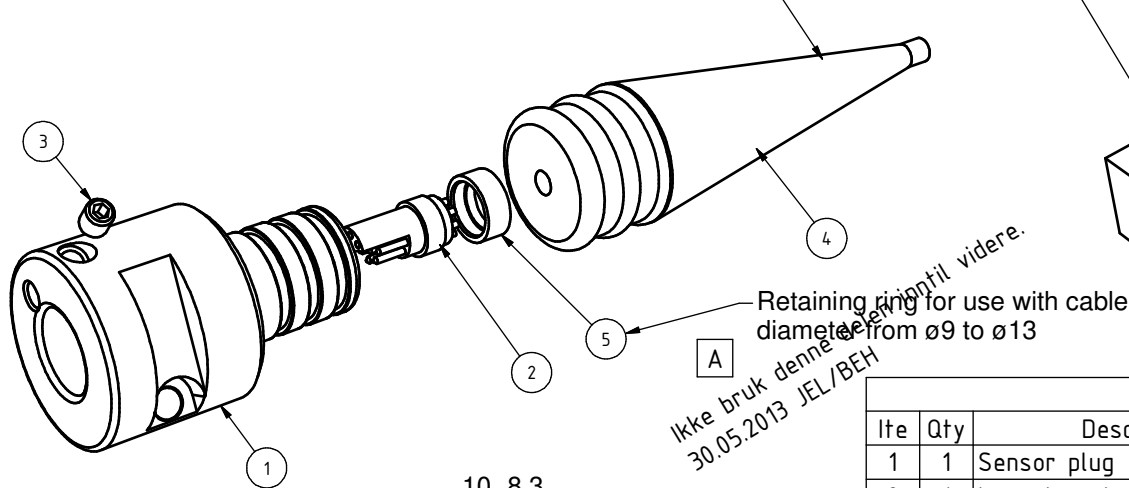

Ikke bruk denne delen
30.05.2013 JEL/BEH

Parts List				
Ite	Qty	Description	Drawing/Std./Type/Etc.	AADI nr.
1	1	Sensor plug	DID-50145	3964769
2	1	Lemo insert 10 Pin	FFA.2S.310.ZLA	1560064
3	1	Hexagon Socket Set Screw	DIN 916 - M5 x 6	1642404
4	0.1	Scotchcast	Part A+B	1260044A/B
5	1	Retaining ring	DID-50307	3962230
Date		Constr./Drw.	Approved	Scale
31.10.2012		GN	JEL	1,5:1
Sensor Plug (SP) 6000m Depth rating			 AANDERAA DATA INSTRUMENTS	
			Part No. 0975461	 Rev. No. A
Original Size			Sheet	1 of 1
A3			Edition A 30.05.2013 JEL	