
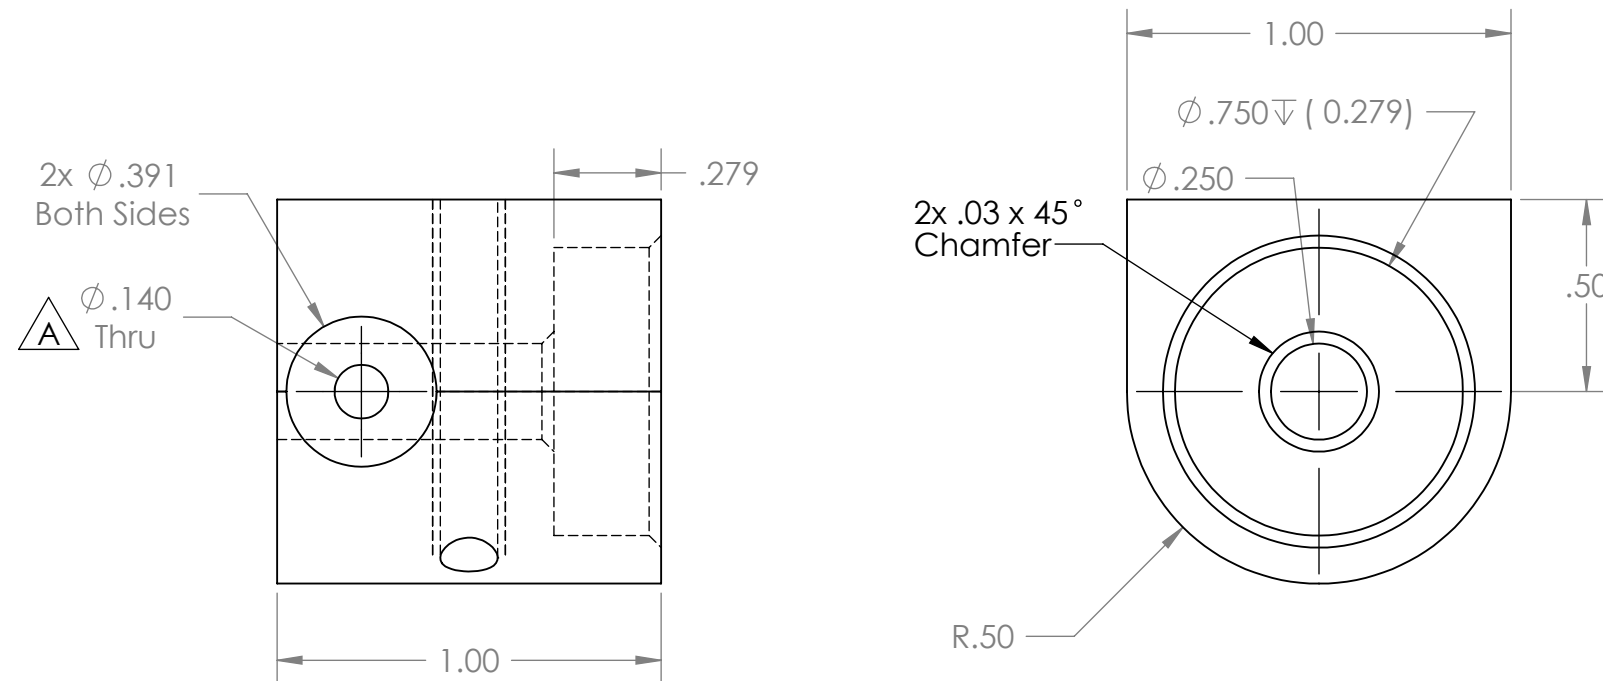
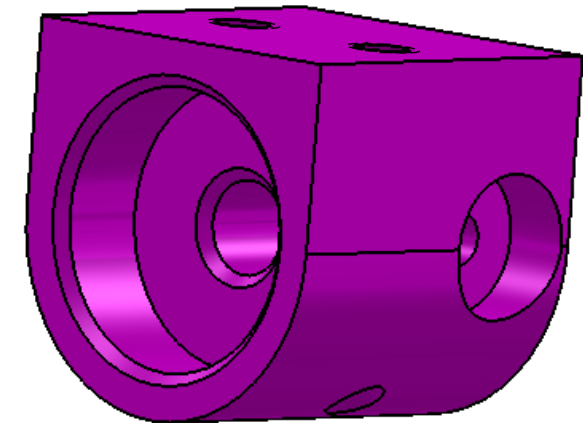


THE INFORMATION CONTAINED IN THIS DRAWING IS THE SOLE PROPERTY OF MBARI.
ANY REPRODUCTION IN PART OR WHOLE WITHOUT THE WRITTEN PERMISSION OF MBARI
IS PROHIBITED.

REVISIONS			
REV.	DESCRIPTION	DATE	APPROVED
	INITIAL RELEASE		
A	CHANGE SHAFT SCREW CLRNC DIAM.	7/19/10	JS

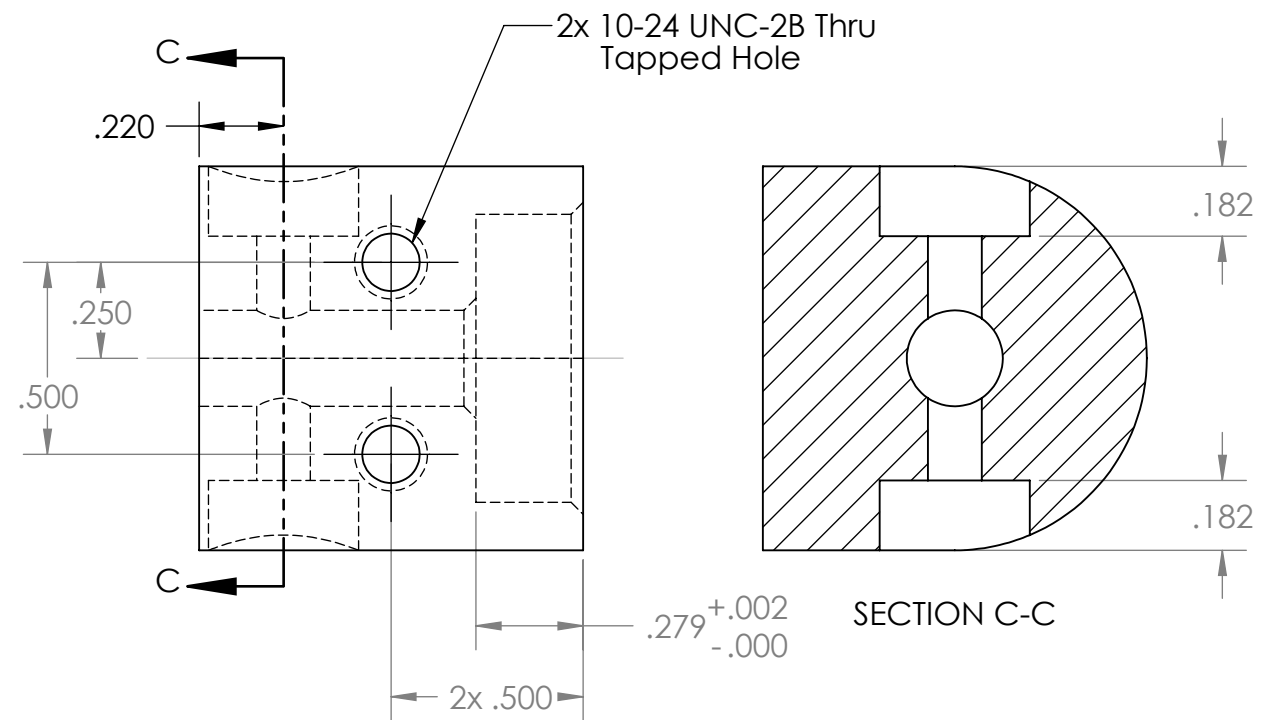

2					
1	4 Ea.		Louver Pin Block		Delrin
ITEM NO.	QTY	PART NO.	DESCRIPTION		MATERIAL SPECIFICATION
BILL OF MATERIALS					
UNLESS OTHERWISE SPECIFIED TOLERANCES ARE:			APPROVALS DATE DRAWN F. Shane 06Apr10 ENGINEER F. Shane 06Apr10 CHECKED PROJECT NO. 900719 PROJECT FOCE WEIGHT		
1 PLACE DIM $\pm 1/16$	2 PLACE DIM $\pm .02$	3 PLACE DIM $\pm .005$	ANGLES $\pm 1^\circ$	Monterey Bay Aquarium Research Institute 	
1. DIMENSIONS ARE IN INCHES 2. DIMENSION LIMITS HELD AFTER PLATING. 3. REMOVE BURRS AND SHARP EDGES .015 MAX. 4. MACHINED FILLET RADII .0150-.030. 5. MACHINED DIAMETERS ON A COMMON CENTERLINE CONCENTRIC WITHIN .005 6. PERPENDICULARITY & PARALLELISM OF MACHINED SURFACES .002 PER INCH, MAX .012 INCHES FOR SINGLE SURFACE.				7700 Sandholdt RD. Moss Landing, CA 95039 PH: (408) 775-1700	
DO NOT SCALE DRAWING				FOCE CO2 Louver Pin Block SIZE B DWG. NO. 10020497.DWG REV.	
				SCALE NONE CAD FILE: Project Library\900719\FOCE SHEET 1 OF 1	