
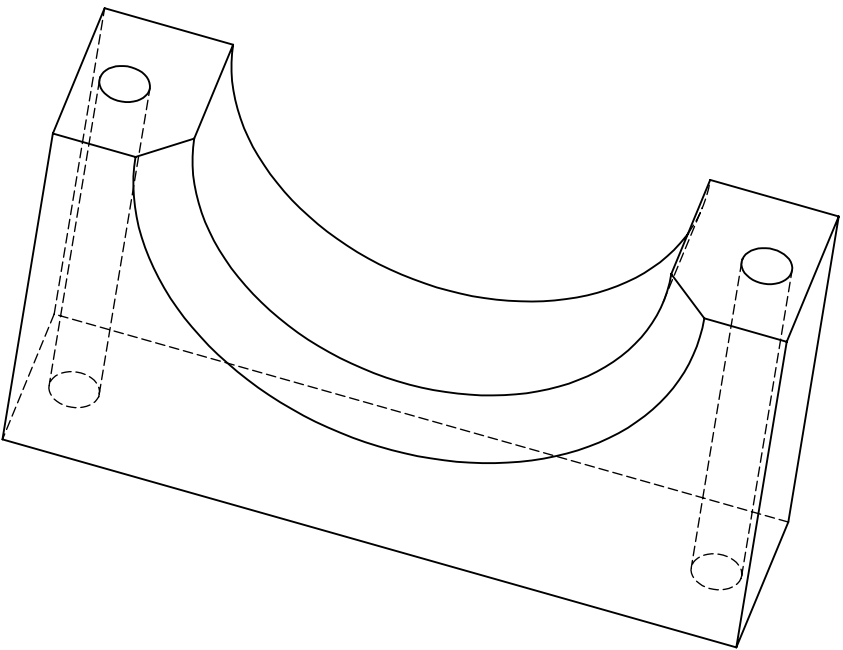


THE INFORMATION CONTAINED IN THIS DRAWING IS THE SOLE PROPERTY OF MBARI.
ANY REPRODUCTION IN PART OR WHOLE WITHOUT THE WRITTEN PERMISSION OF MBARI
IS PROHIBITED.

REVISIONS			
REV.	DESCRIPTION INITIAL RELEASE	DATE	APPROVED
A	Add Radial Chamfer, 45 deg. x .25".	31 May10	F. Shane

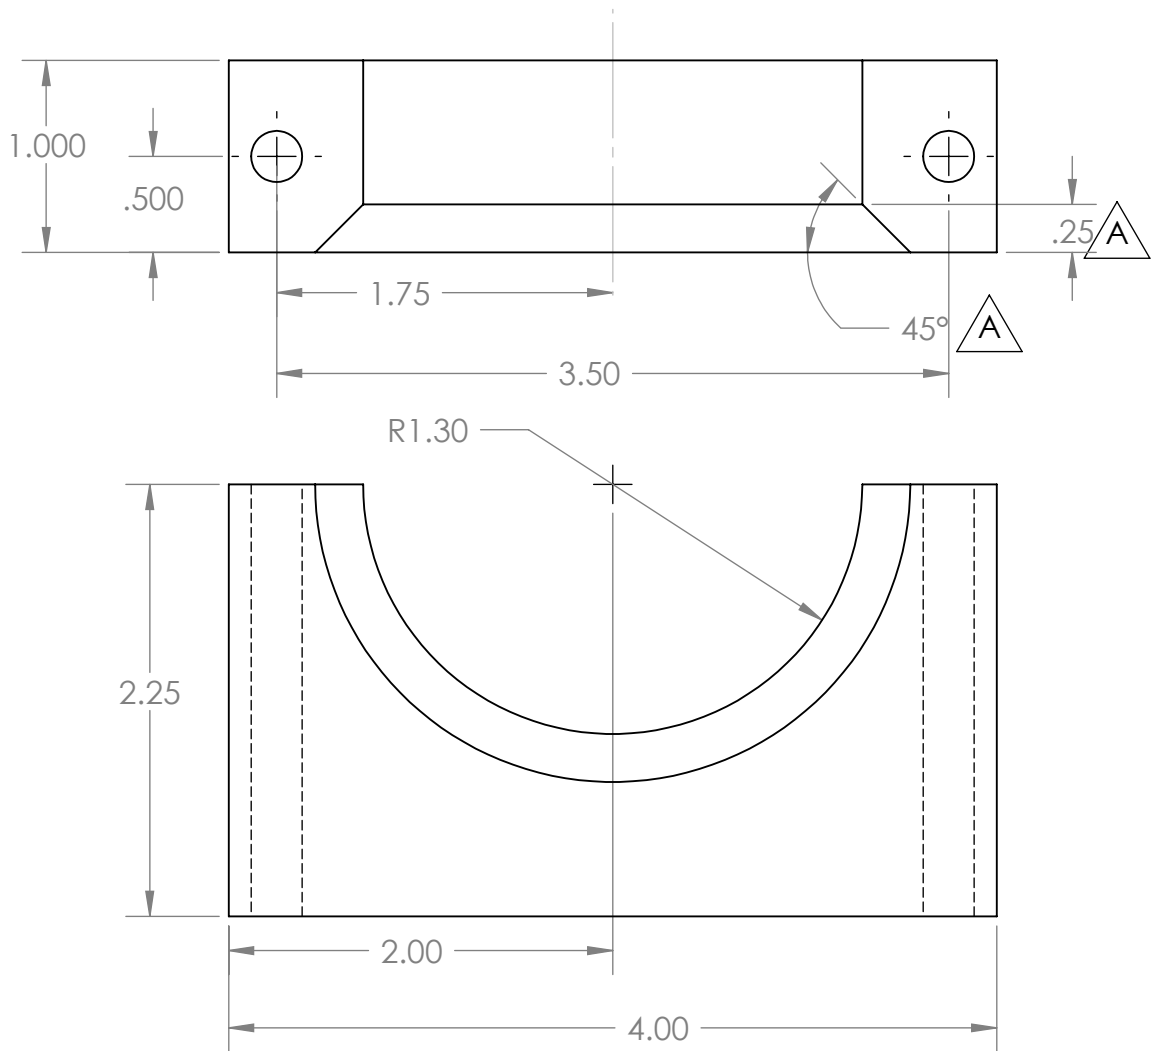

2									
1	1 Ea.		Magnetic Coupling Support Base						Acetal
ITEM NO.	QTY	PART NO.	DESCRIPTION						MATERIAL SPECIFICATION
BILL OF MATERIALS									
UNLESS OTHERWISE SPECIFIED TOLERANCES ARE:			APPROVALS		DATE		Monterey Bay Aquarium Research Institute		
1 PLACE DIM ±.1/16	2 PLACE DIM ±.02	3 PLACE DIM ±.005	ANGLES ±1°	DRAWN	F. Shane	14Apr10			
1. DIMENSIONS ARE IN INCHES 2. DIMENSION LIMITS HELD AFTER PLATING. 3. REMOVE BURRS AND SHARP EDGES .015 MAX. 4. MACHINED FILLET RADII .0150-.030. 5. MACHINED DIAMETERS ON A COMMON CENTERLINE CONCENTRIC WITHIN .005 6. PERPENDICULARITY & PARALLELISM OF MACHINED SURFACES .002 PER INCH. MAX .012 INCHES FOR SINGLE SURFACE.				ENGINEER	F. Shane	14Apr10	7700 Sandholdt RD. Moss Landing, CA 95039 PH: (408) 775-1700		
				CHECKED					
				PROJECT NO.		900719			
				PROJECT		FOCE		FOCE Magnetic Coupling Support Base	
DO NOT SCALE DRAWING				WEIGHT		SIZE B		DWG. NO. 10020528.DWG	
				SCALE		NONE		CAD FILE: Project Library\900719\FOCE	
				SHEET 1		OF 1		REV. A	

NEXT ASSY	USED ON
APPLICATION	