
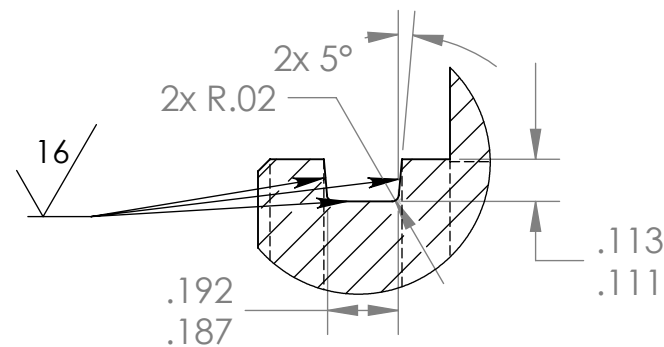
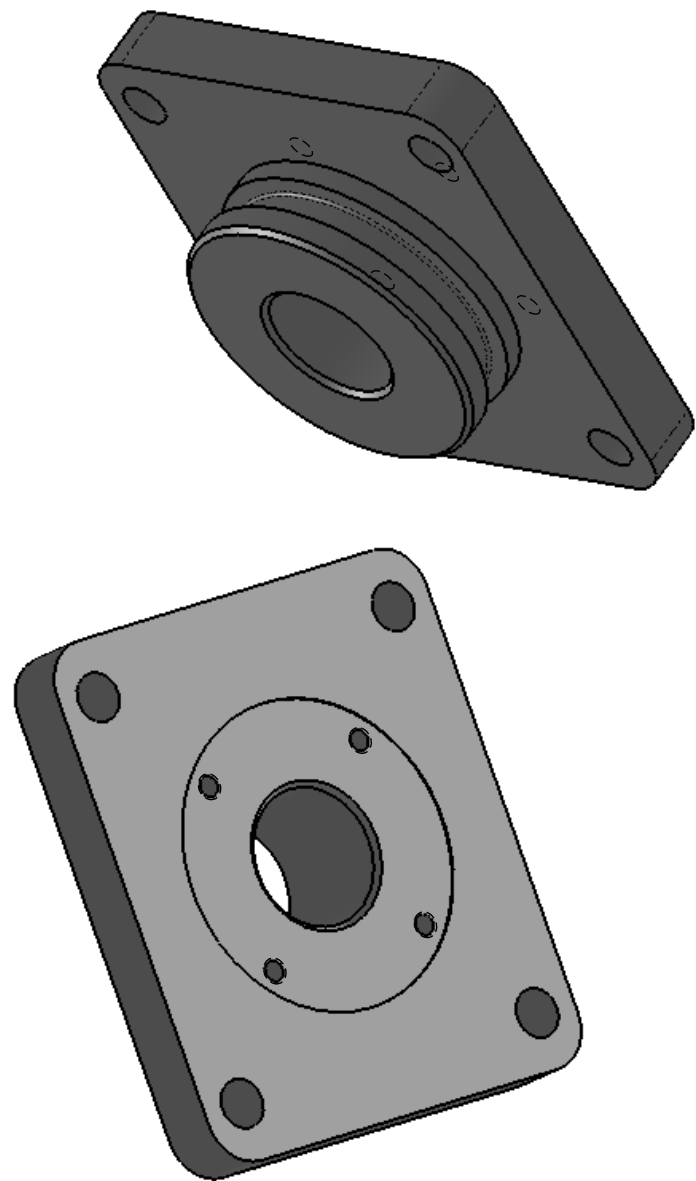
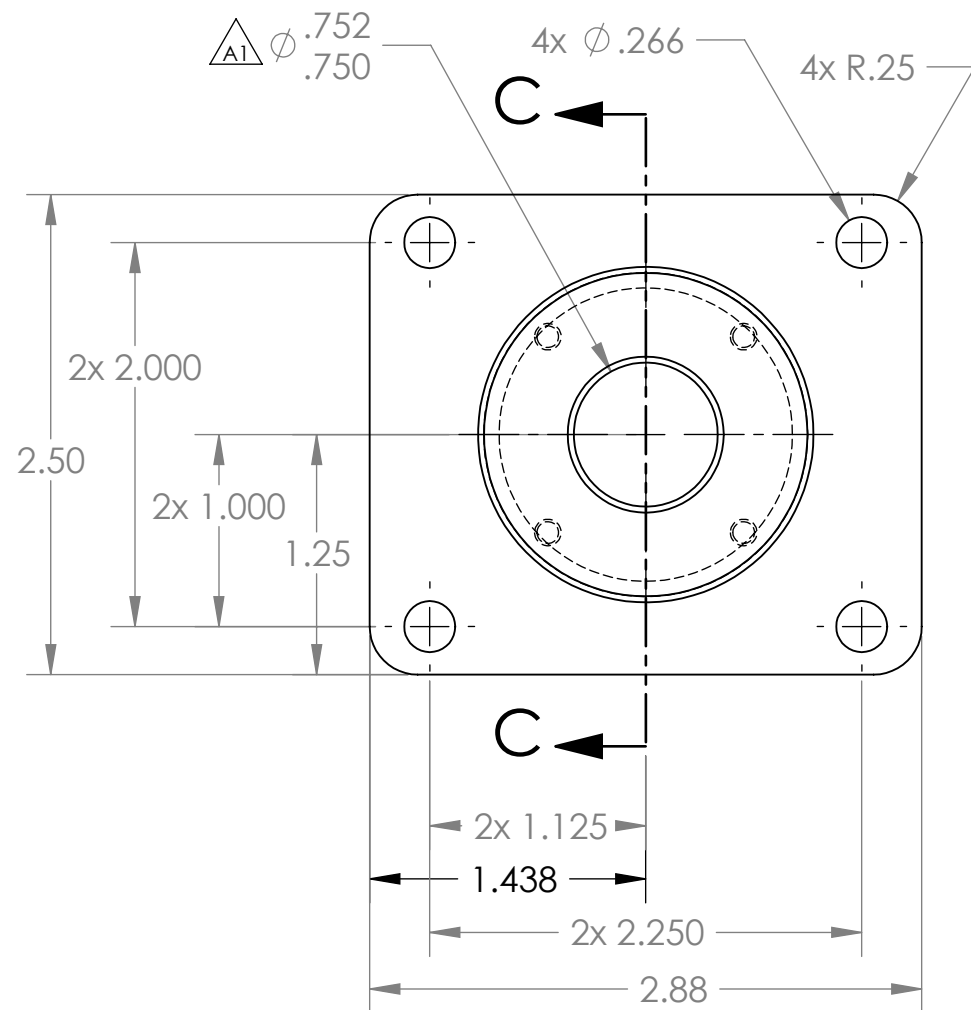


REVISIONS			
REV.	DESCRIPTION	DATE	APPROVED
A	INITIAL RELEASE		
	1. Add holes for MinK conn.	18Mar09	F. Shane

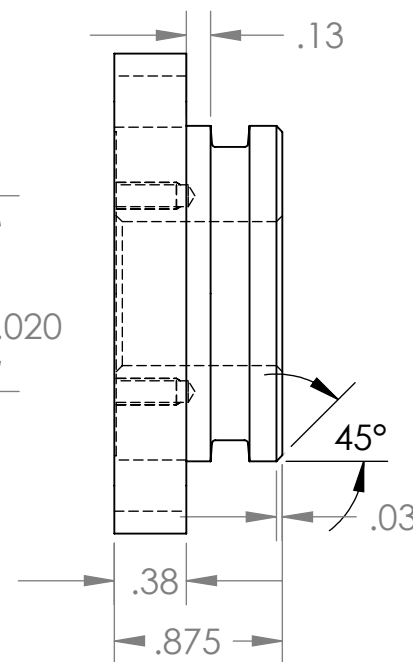

For O-Ring 2-222
DETAIL D
SCALE 2 : 1

SECTION C-C
SCALE 1 : 1

2									
1	1 Ea.		MinK Manifold Cap					6Al-4V Titanium	
ITEM NO.	QTY	PART NO.	DESCRIPTION					MATERIAL SPECIFICATION	
BILL OF MATERIALS									
UNLESS OTHERWISE SPECIFIED TOLERANCES ARE:			APPROVALS		DATE		Monterey Bay Aquarium Research Institute 7700 Sandholdt RD. Moss Landing, CA 95039 PH: (408) 775-1700 FOCE MinK Manifold Cap SIZE B DWG. NO. 10020292.DWG REV. A SCALE NONE CADFILE: Project Library\900719\FOCE SHEET 1 OF 1		
1 PLACE DIM ±1/16	2 PLACE DIM ±.02	3 PLACE DIM ±.005	ANGLES ±1°	DRAWN	F. Shane	26Jan08			
1. DIMENSIONS ARE IN INCHES 2. DIMENSION LIMITS HELD AFTER PLATING. 3. REMOVE BURRS AND SHARP EDGES .015 MAX. 4. MACHINED FILLET RADII .0150-.030. 5. MACHINED DIAMETERS ON A COMMON CENTERLINE CONCENTRIC WITHIN .005 6. PERPENDICULARITY & PARALLELISM OF MACHINED SURFACES .002 PER INCH. MAX .012 INCHES FOR SINGLE SURFACE.				ENGINEER	F. Shane	26Jan08			
				CHECKED					
			PROJECT NO.		900719				
			PROJECT		FOCE				
DO NOT SCALE DRAWING			WEIGHT		VOLUME				
			X #		X cu. in.				

A