


FINAL CONFIGURATION

4/6 - ~~2014~~ 2015

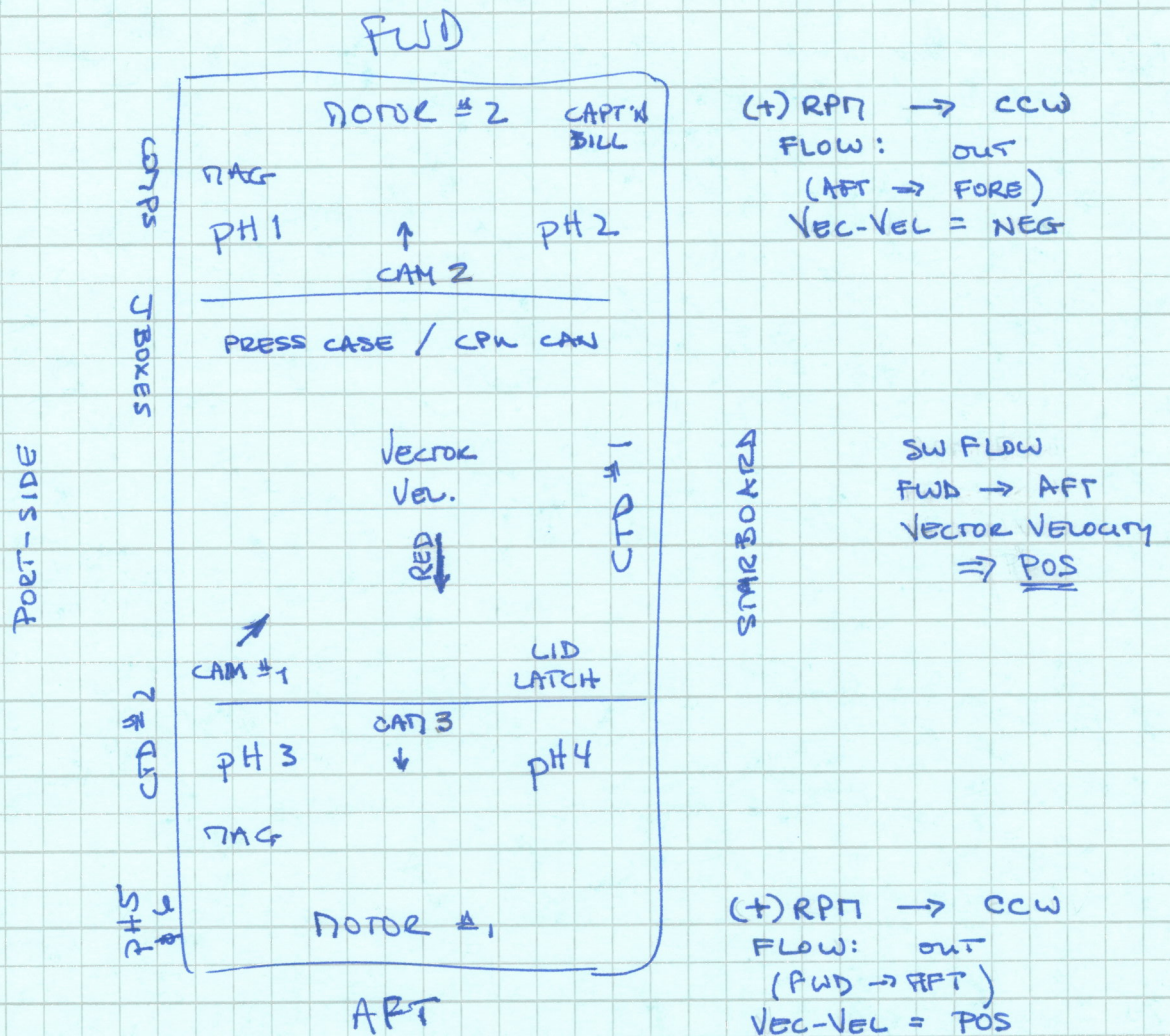

ADCP
#1645
(on Wina)

ADCP $V_x =$
 $- VEC V_x$
(reverse sign
convention)