


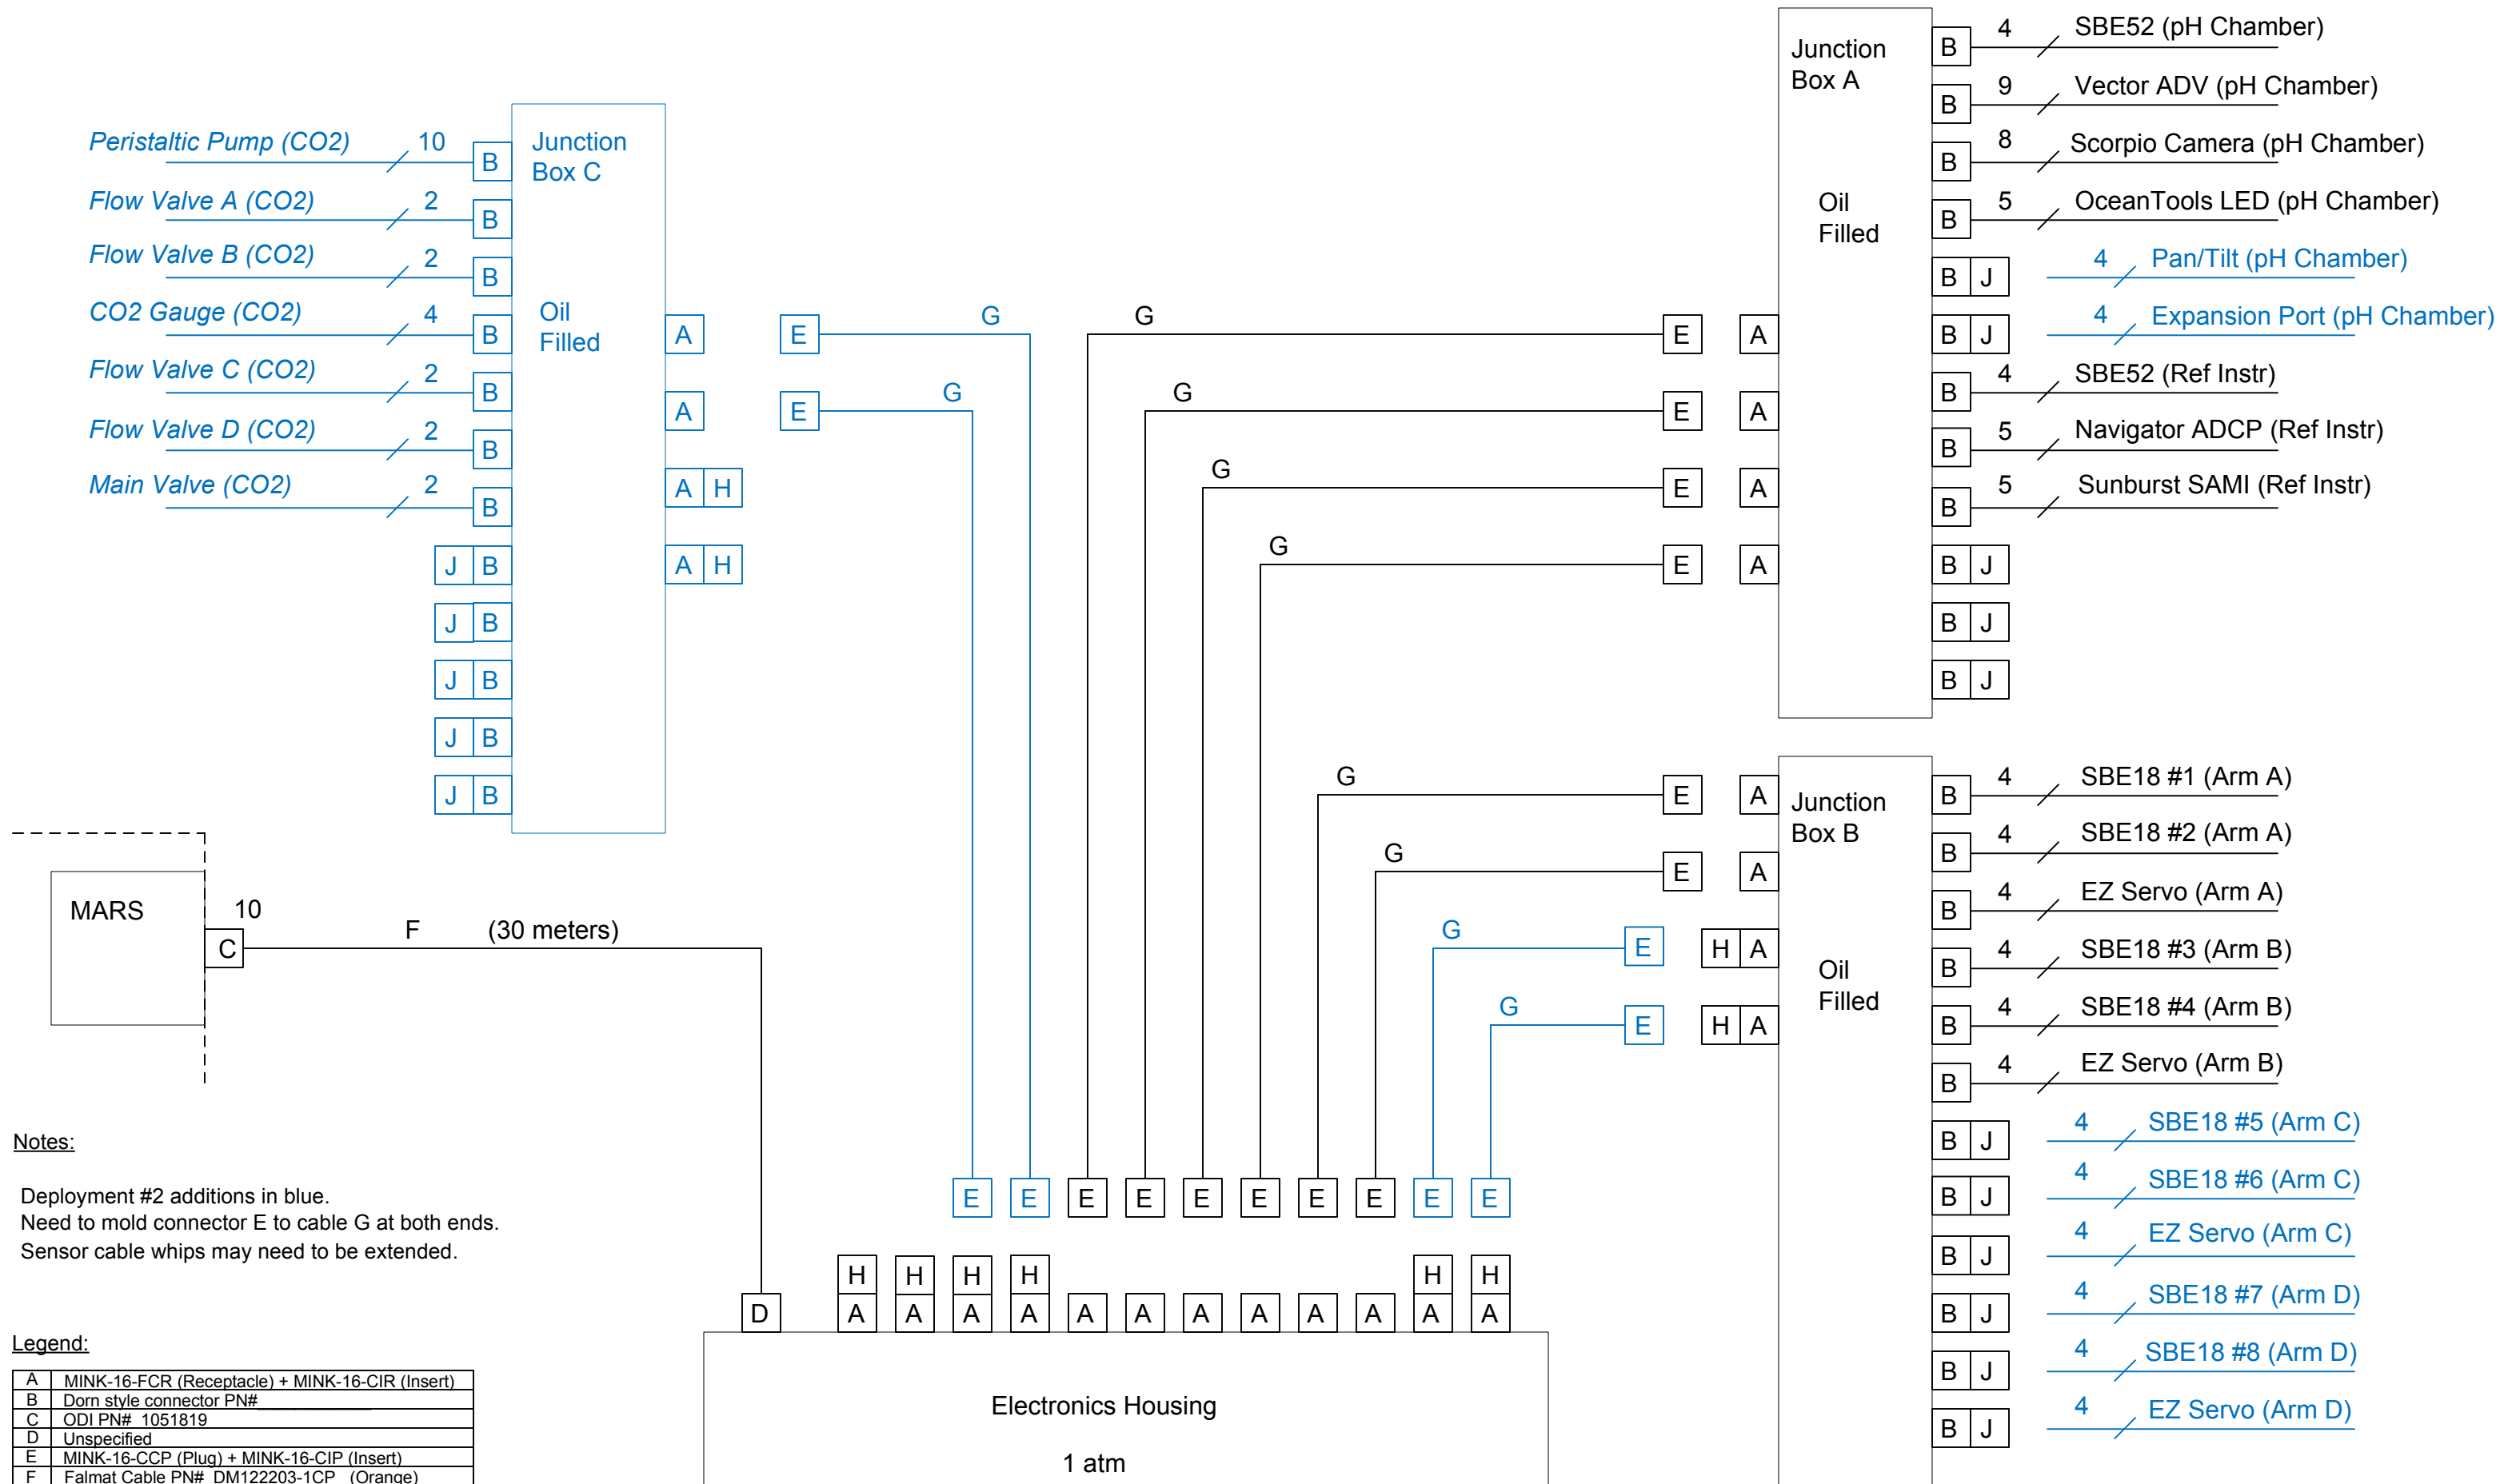

FOCE External Wiring Diagram