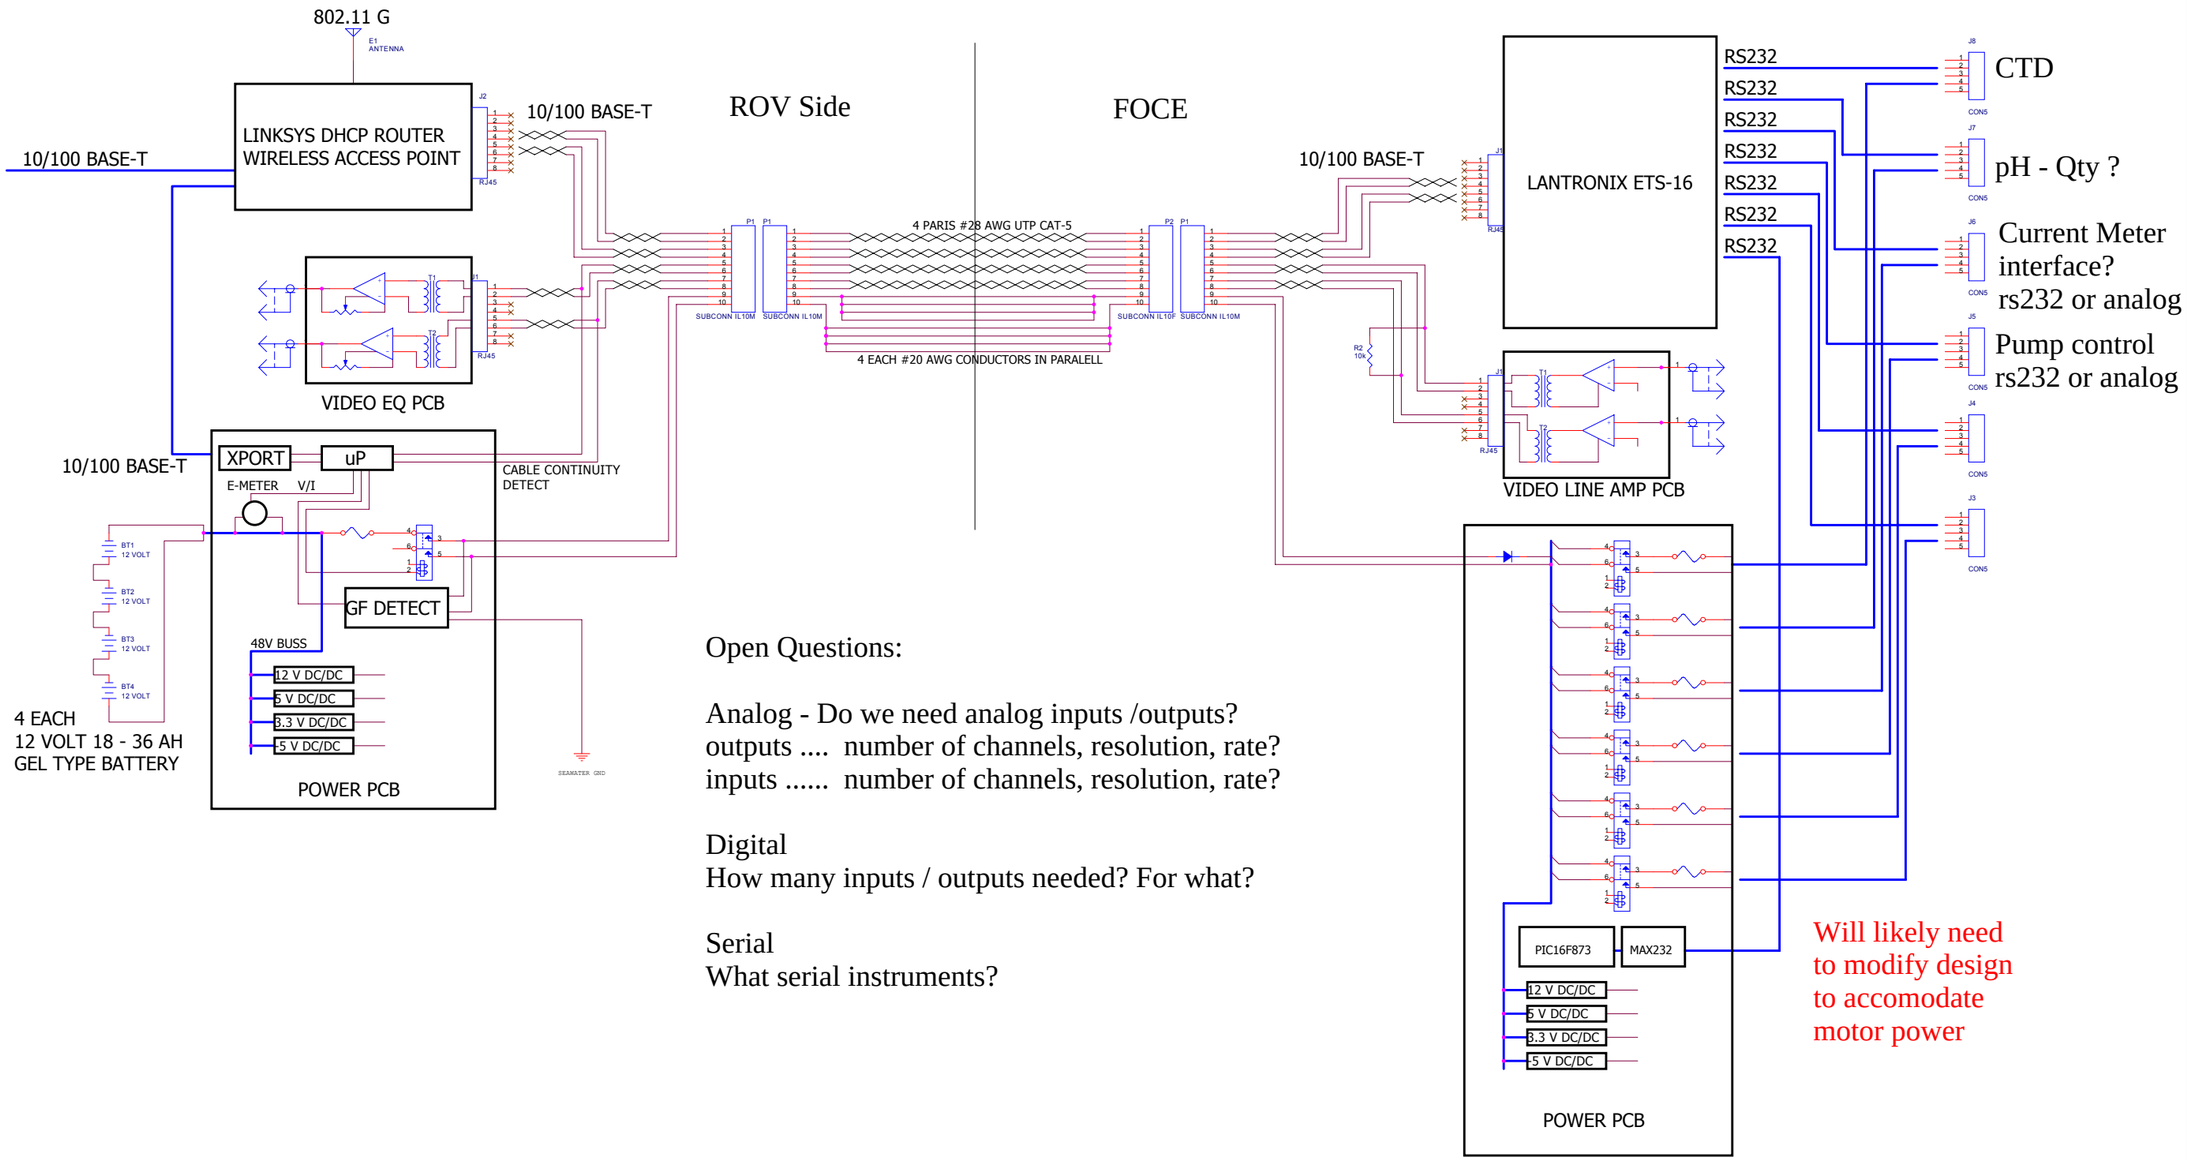

Open Questions:

Analog - Do we need analog inputs /outputs?
outputs .... number of channels, resolution, rate?
inputs ..... number of channels, resolution, rate?

Digital
How many inputs / outputs needed? For what?

Serial
What serial instruments?

Title <Title>		
Size D	Document Number <Doc>	Rev <RevCode>
Date: Friday, April 09, 2004	Sheet 1 of 1	