
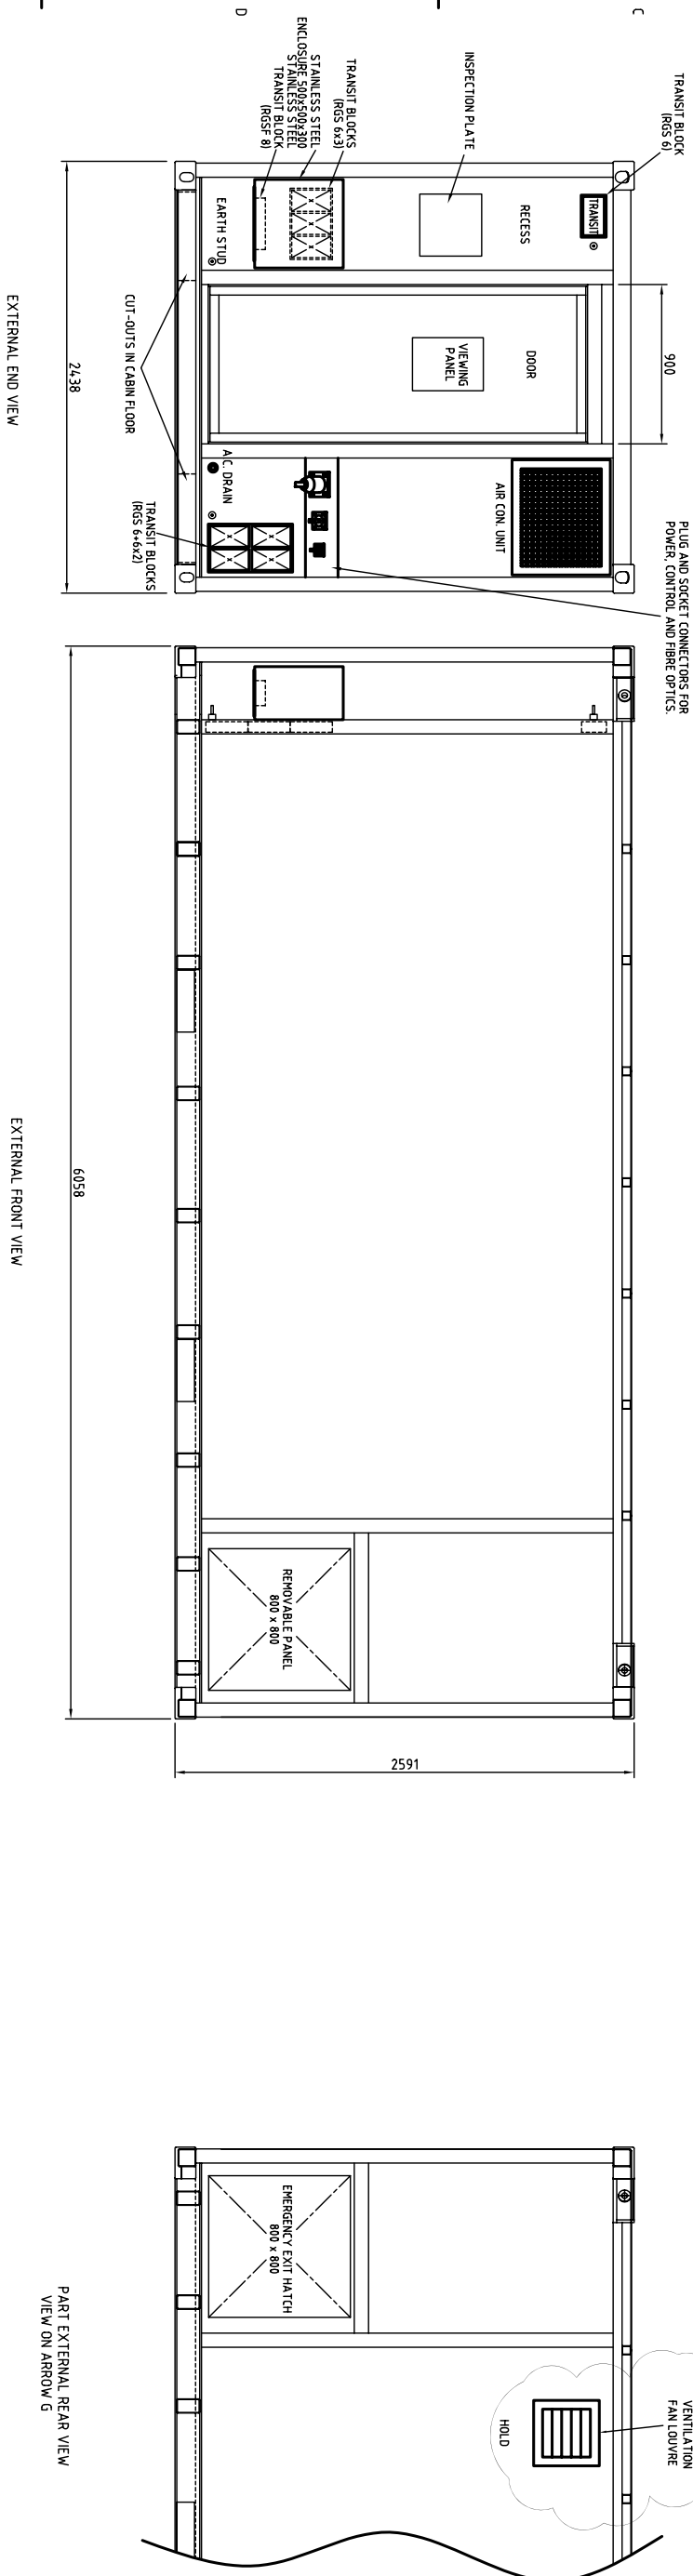


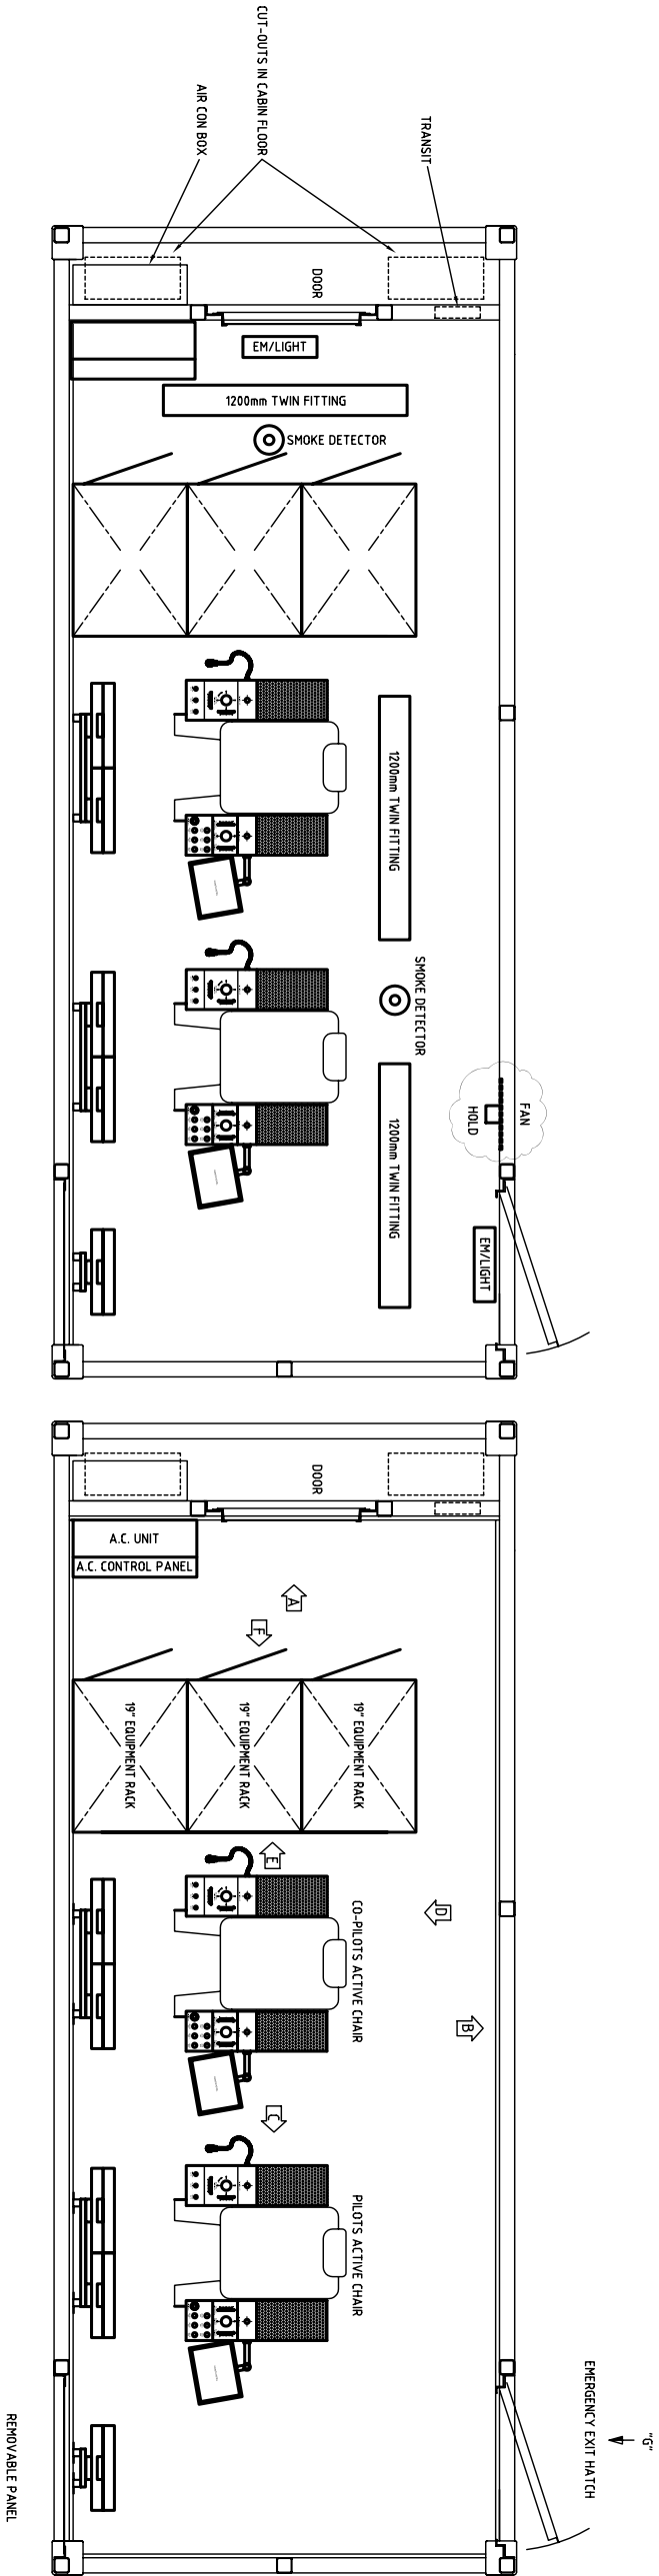

ALL INTELLECTUAL PROPERTY RIGHTS SUBSISTING IN THESE DESIGNS ARE THE PROPERTY OF SMD MACHINE DYNAMICS LTD. NO COPY IS TO BE MADE WITHOUT THE WRITTEN PERMISSION OF SMD MACHINE DYNAMICS LTD. ANY PATENT APPLICATIONS, PATENTS AND/OR RESERVE APPLICATIONS, OF SMD MACHINE DYNAMICS LTD. AND ALL INFORMATION MUST BE HELD IN THE STRICTEST CONFIDENCE.																			
NO.	DATE	CHANGE	ZONE	DRAWN	CHECK	MATERIAL				DIMENSIONS		SCALE	PROJECTION 3RD		TITLE				
						--				mm		1:20			20th CONTROL CABIN LAYOUT (6891C)				
						DESIGNED				DRAWN		TOLERANCES UNLESS OTHERWISE STATED							
						10th				J.W		DIMENSION mm		UP TO 300 TO OVER					
												100 300 1000		1000					
						DATE				CHECKED		FABRICATION		± 1.0 ± 1.5 ± 2.0 ± 3.0					
						12.02.07				--		MACHINED PART		± 0.5 ± 0.4 ± 0.8 ± 1.0					
														DO NOT SCALE		DRAWING NO.			
																AB 2126		ISSUE NO.	
																0		SHEET 1 OF 2	