





| NO.   | DATE     | CHANGE           | ZONE | DRAWN | CHECK  | MATERIAL              | DIMENSIONS | SCALE                              | PROJECTION 3RD                                                                        | TITLE                                   |             |              |                       |                |           |
|---|----------|------------------|------|-------|--------|-----------------------|------------|------------------------------------|---------------------------------------------------------------------------------------|-----------------------------------------|-------------|--------------|-----------------------|----------------|-----------|
| 1   | 26-06-08 | AS COMMISSIONED. | ALL  | P.S.  | C.L.T. | NA                    | NA         | NA                                 |  | PILOT ACTIVE CHAIR WIRING<br>(LH PLATE) |             |              |                       |                |           |
|   |          |                  |      |       |        | DESIGNED              | DRAWN      | TOLERANCES UNLESS OTHERWISE STATED |                                                                                       |                                         |             | DO NOT SCALE | DRAWING NO.<br>AB7022 | ISSUE NO.<br>1 |           |
|   |          |                  |      |       |        | TFS                   | TFS        | DIMENSION mm                       | UP TO 100                                                                             | 100 TO 300                              | 300 TO 1000 |              |                       |                | OVER 1000 |
|   |          |                  |      |       |        | DATE                  | CHECKED    | FABRICATION                        | ± 1.0                                                                                 | ± 1.5                                   | ± 2.0       |              | ± 3.0                 |                | A2 CAD    |
|   |          |                  |      |       |        | 12-11-07              | I.M.P.     | MACHINED PART                      | ± 0.15                                                                                | ± 0.4                                   | ± 0.8       |              | ± 1.0                 |                |           |
| ALL INTELLECTUAL PROPERTY RIGHTS SUBSISTING IN THESE DESIGNS ARE THE PROPERTY OF SOIL MACHINE DYNAMICS LTD. NO COPY IS TO BE MADE WITHOUT THE WRITTEN PERMISSION OF SOIL MACHINE DYNAMICS LTD. ANY PATENT APPLICATIONS, PATENTS AND/OR DESIGN APPLICATIONS, REGISTERED DESIGNS, DESIGN RIGHTS OR COPYRIGHT ARISING FROM OR CONTAINED IN THE DESIGNS ARE THE PROPERTY OF SOIL MACHINE DYNAMICS LTD AND ALL INFORMATION MUST BE HELD IN THE STRICTEST CONFIDENCE. |          |                  |      |       |        | Soil Machine Dynamics |            |                                    |                                                                                       |                                         |             | SHEET 1 OF 4 |                       |                |           |



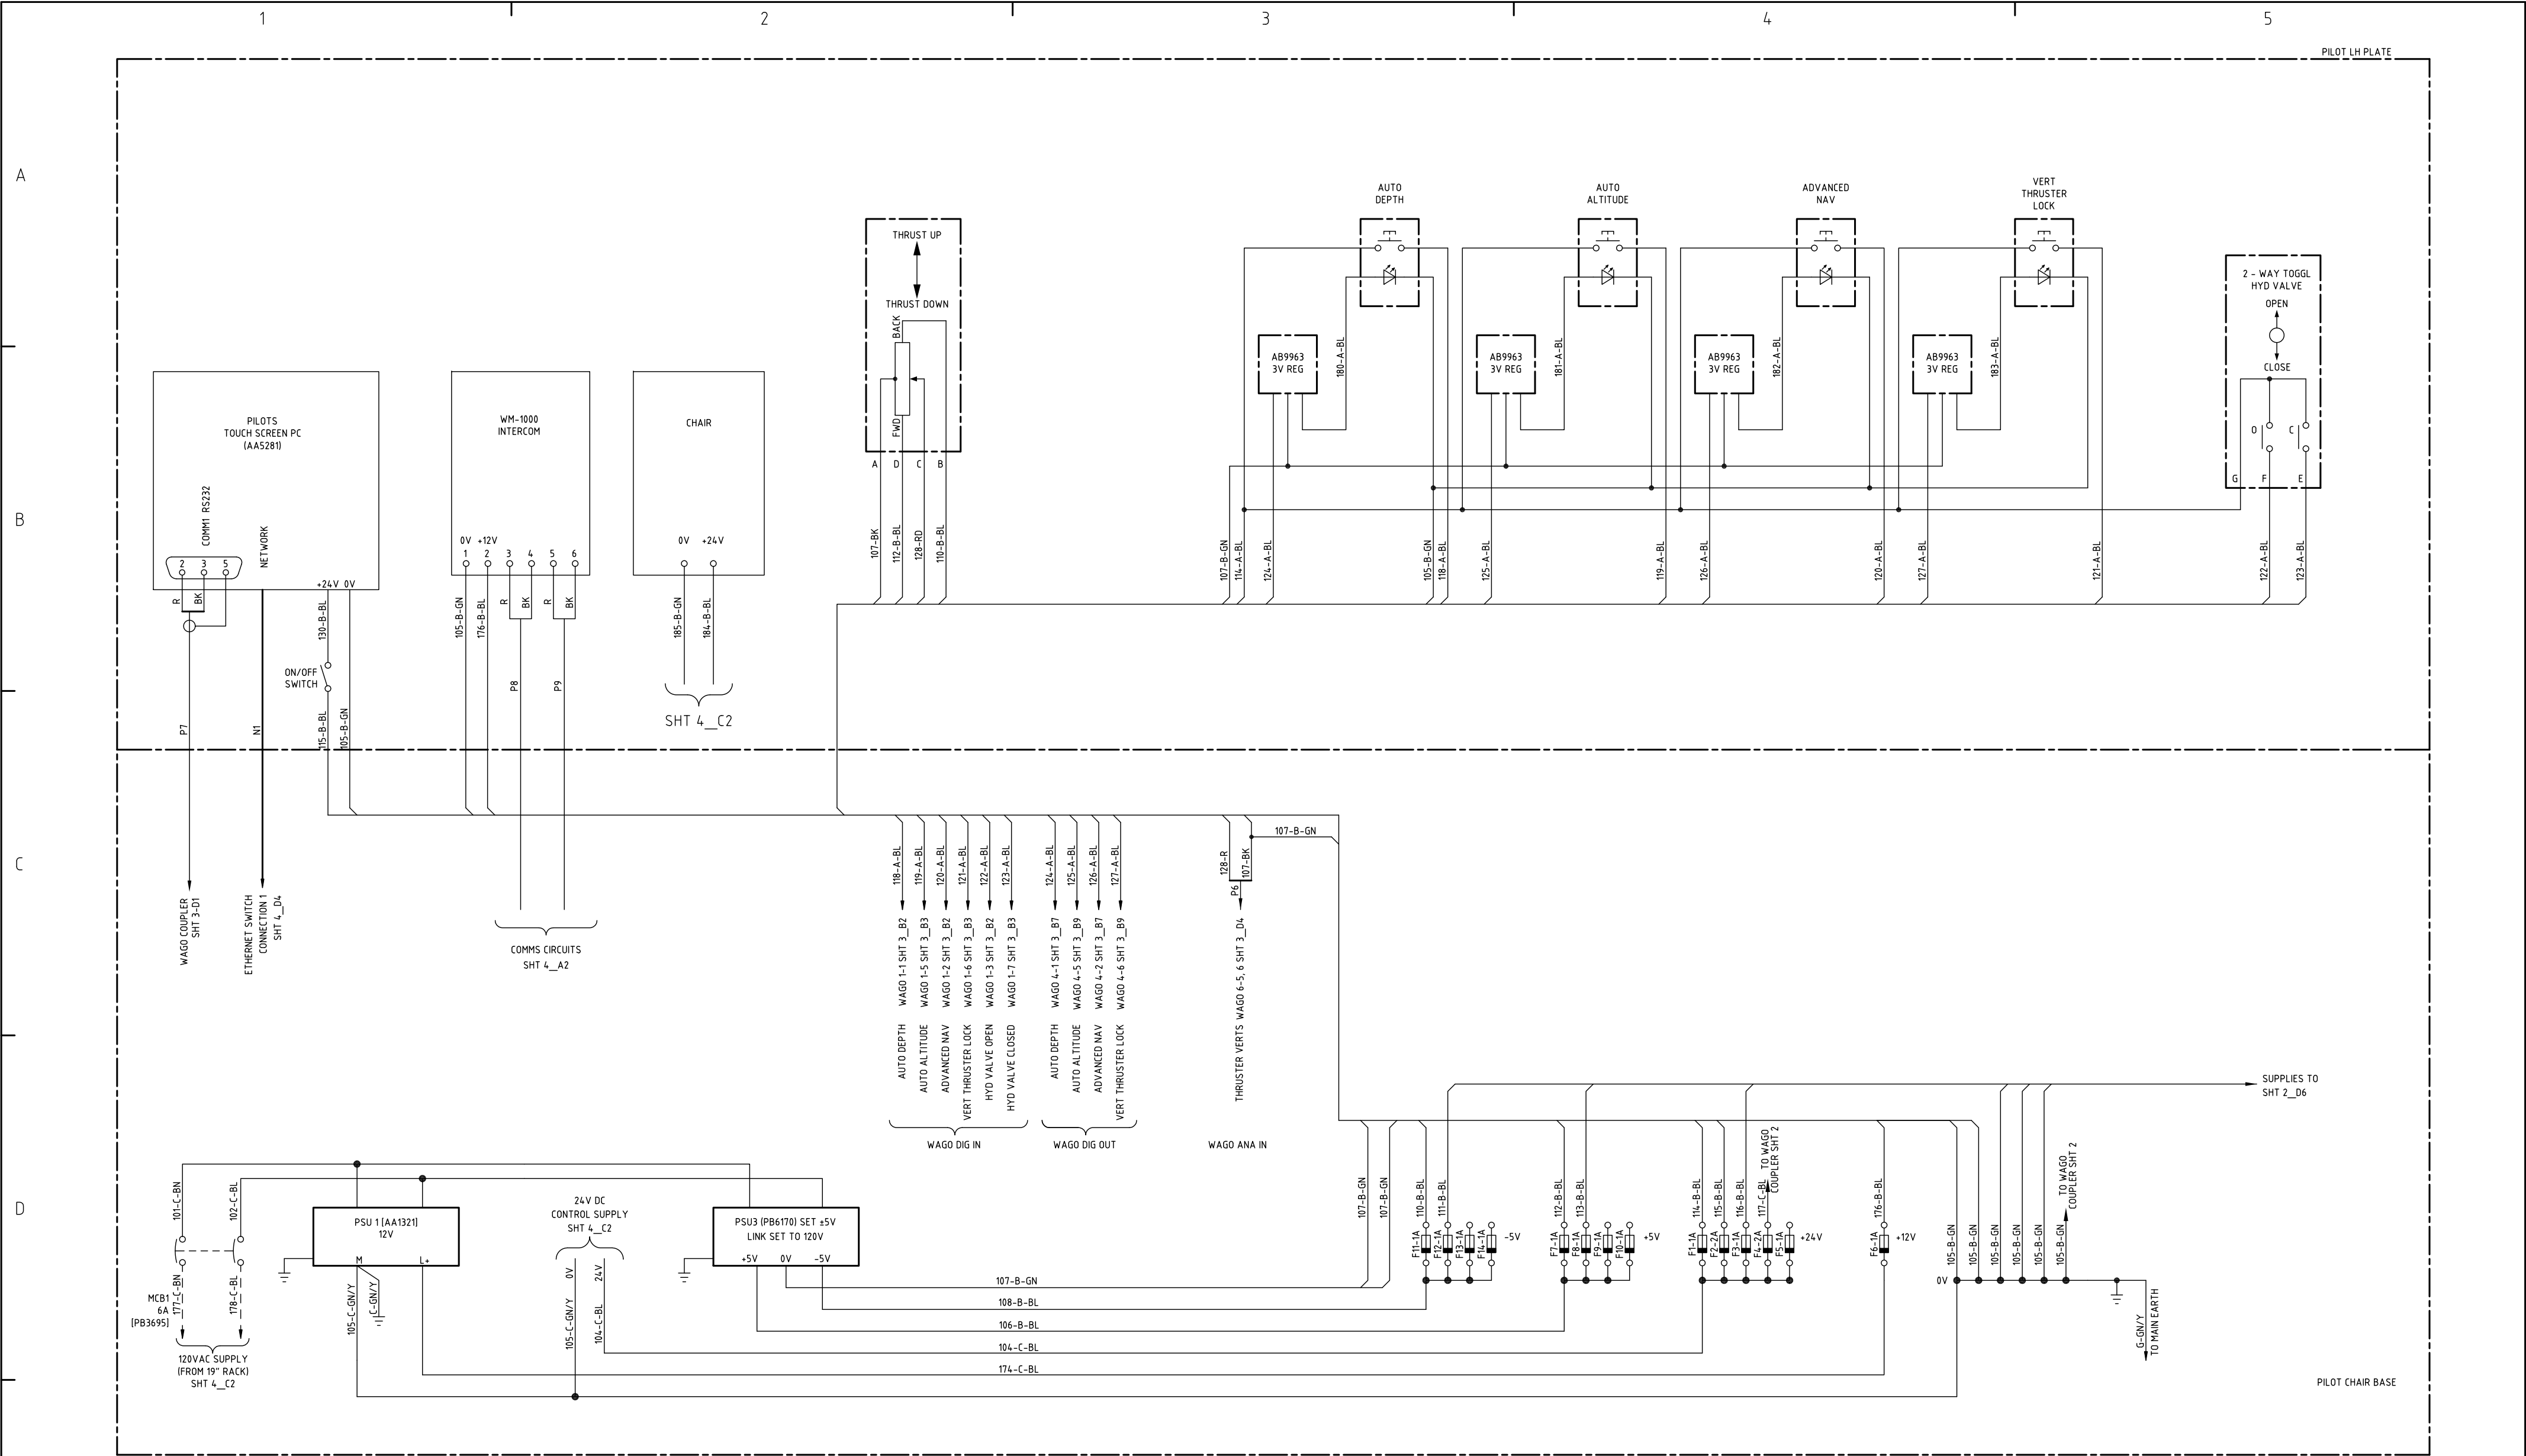

 