


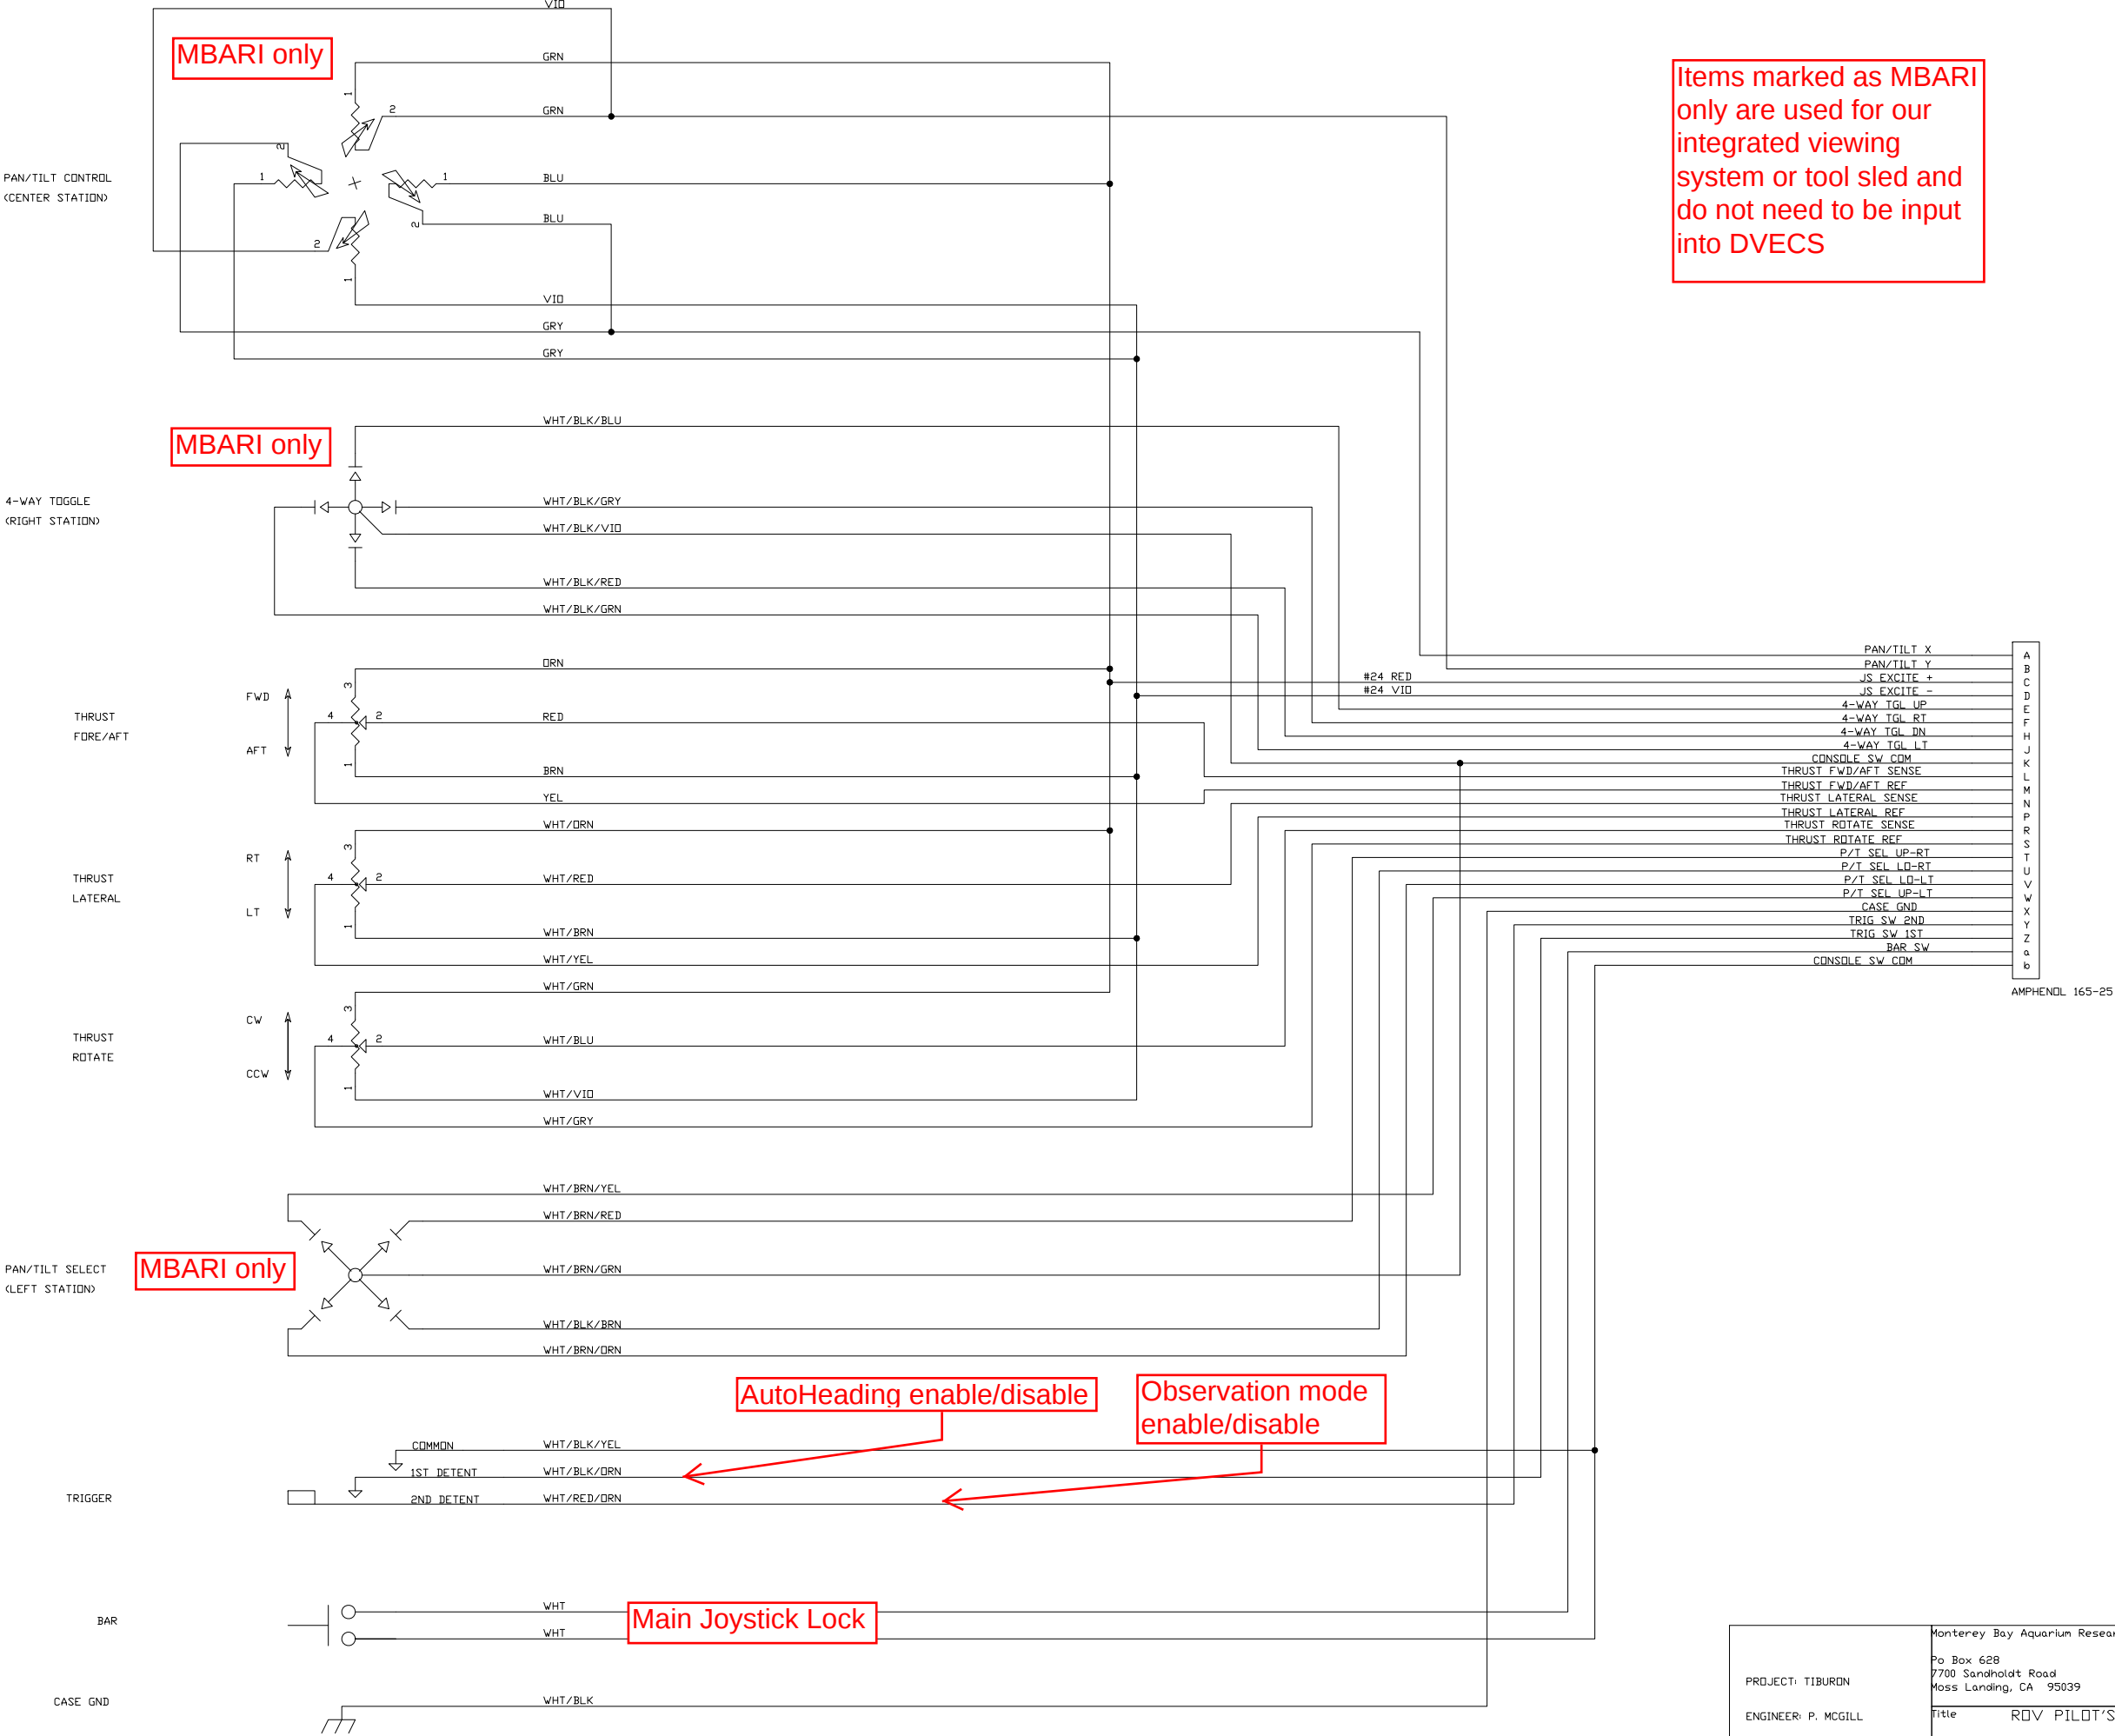

Items marked as MBARI only are used for our integrated viewing system or tool sled and do not need to be input into DVECS