



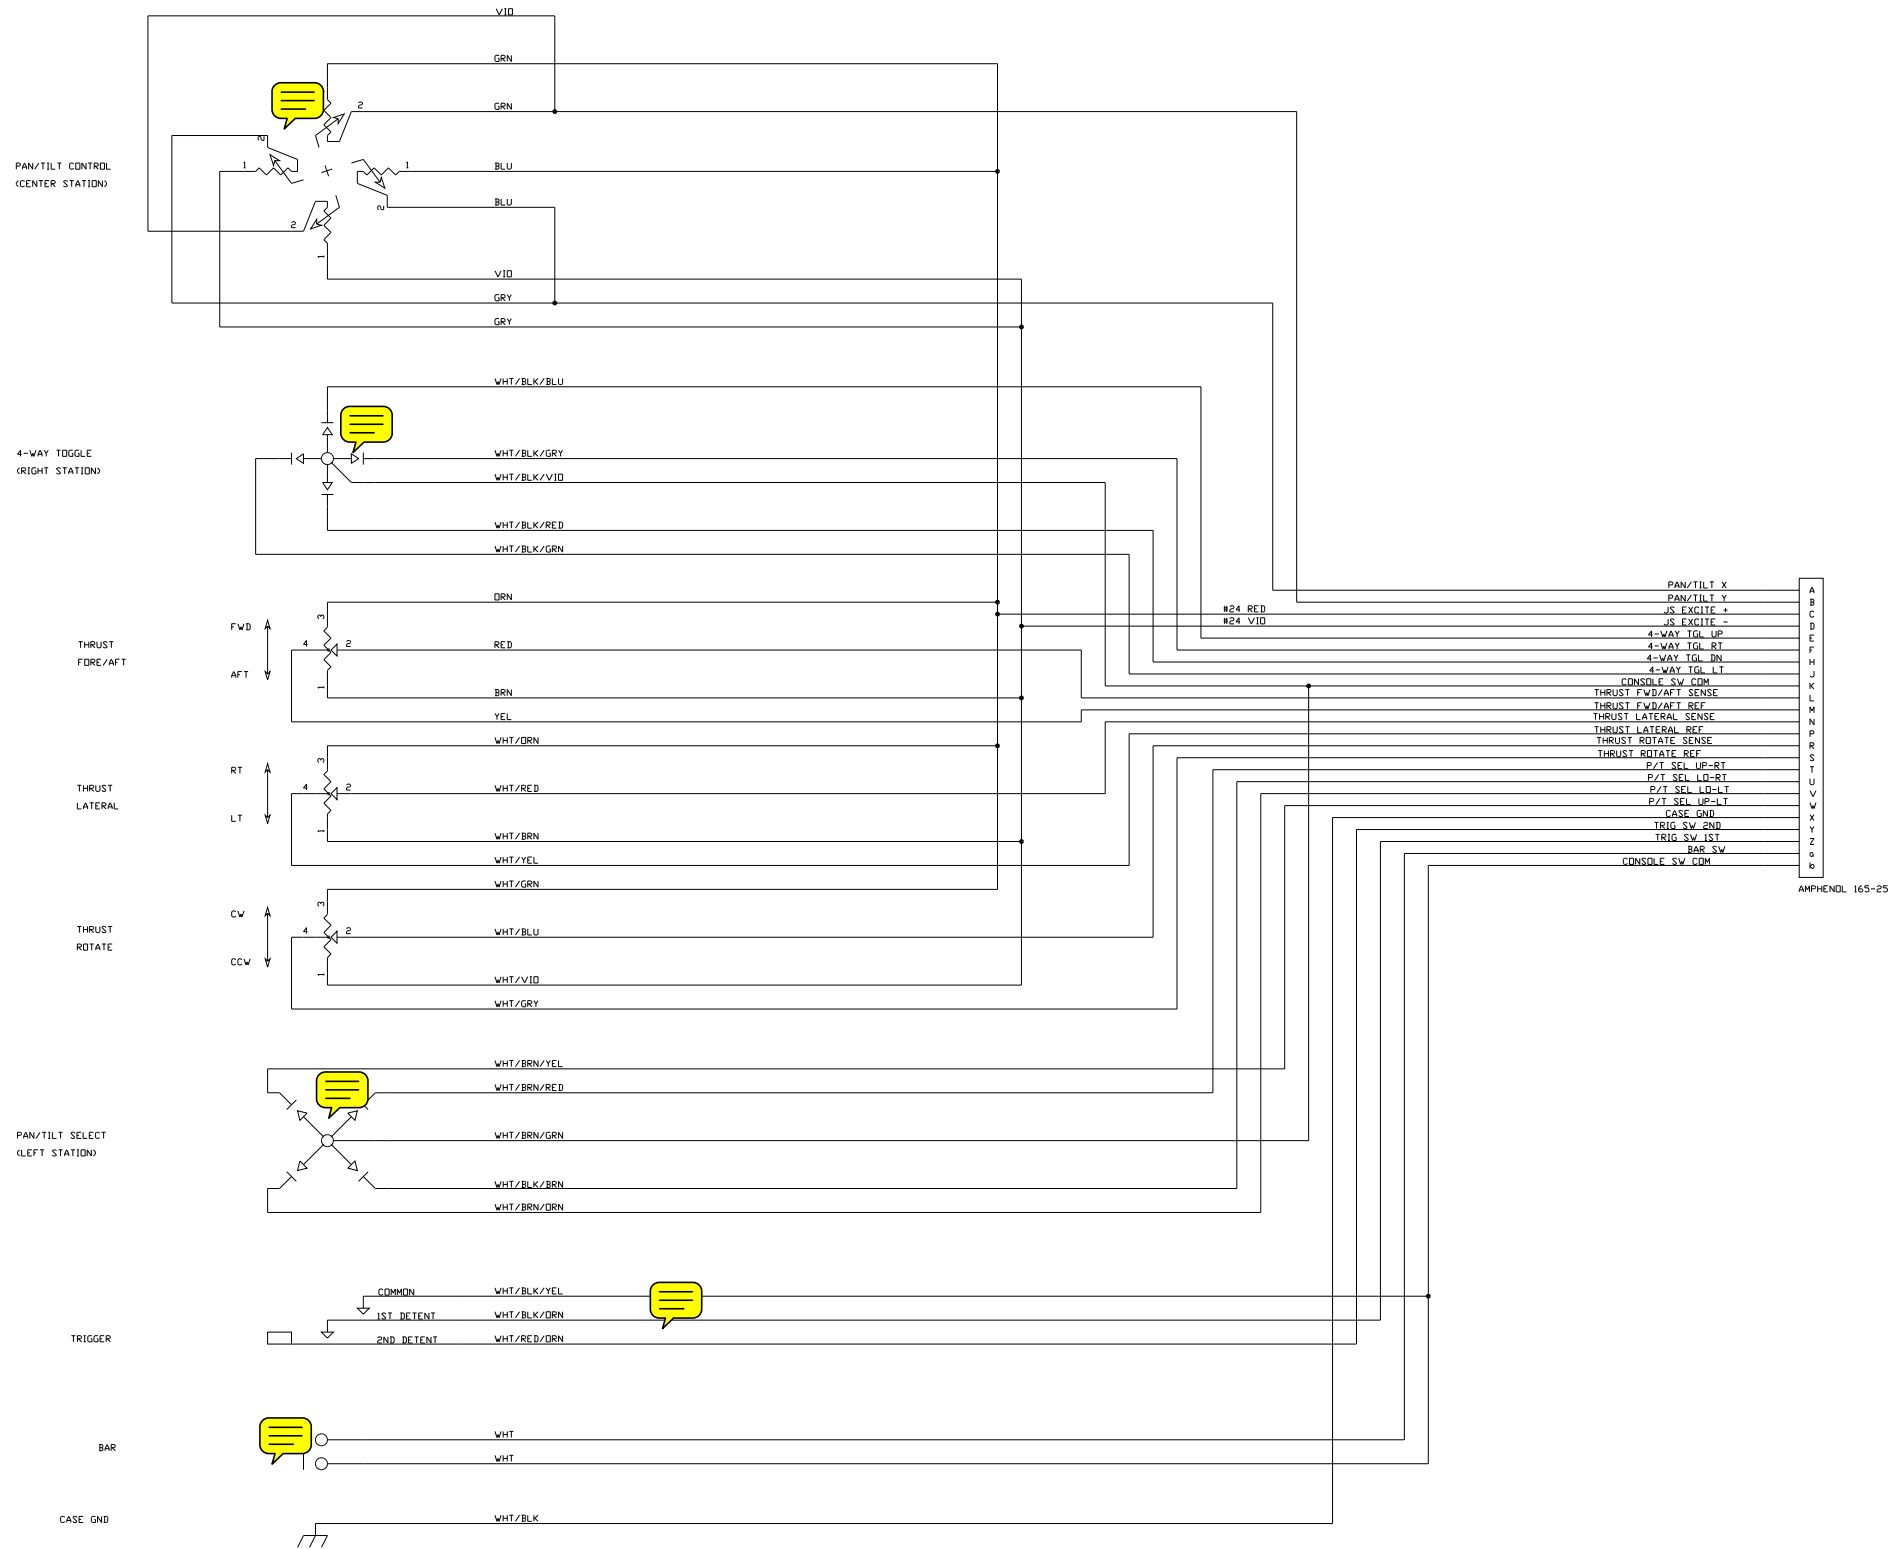

VERTICAL JOYSTICK
MSI P/N 523U

THRUST UP
THRUST DOWN

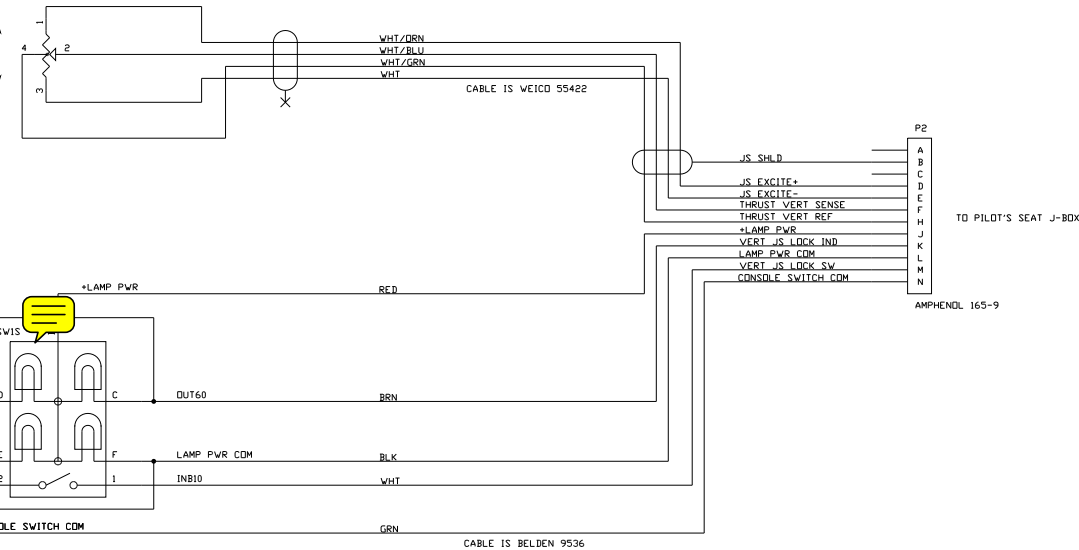

PROJECT: TIBURDN ENGINEER: P. MCGILL FILENAME: RDVPIC03SN	Monterey Bay Aquarium Research Institute Po. Box 628 7700 Sandholzt Road Moss Landing, CA 95039		
	Title RDV PILOT'S CONSOLE		
	Size C	Document Number 36175CH-1.00	Rev A
Date: Friday, June 15, 2007		Sheet 2	8 of