



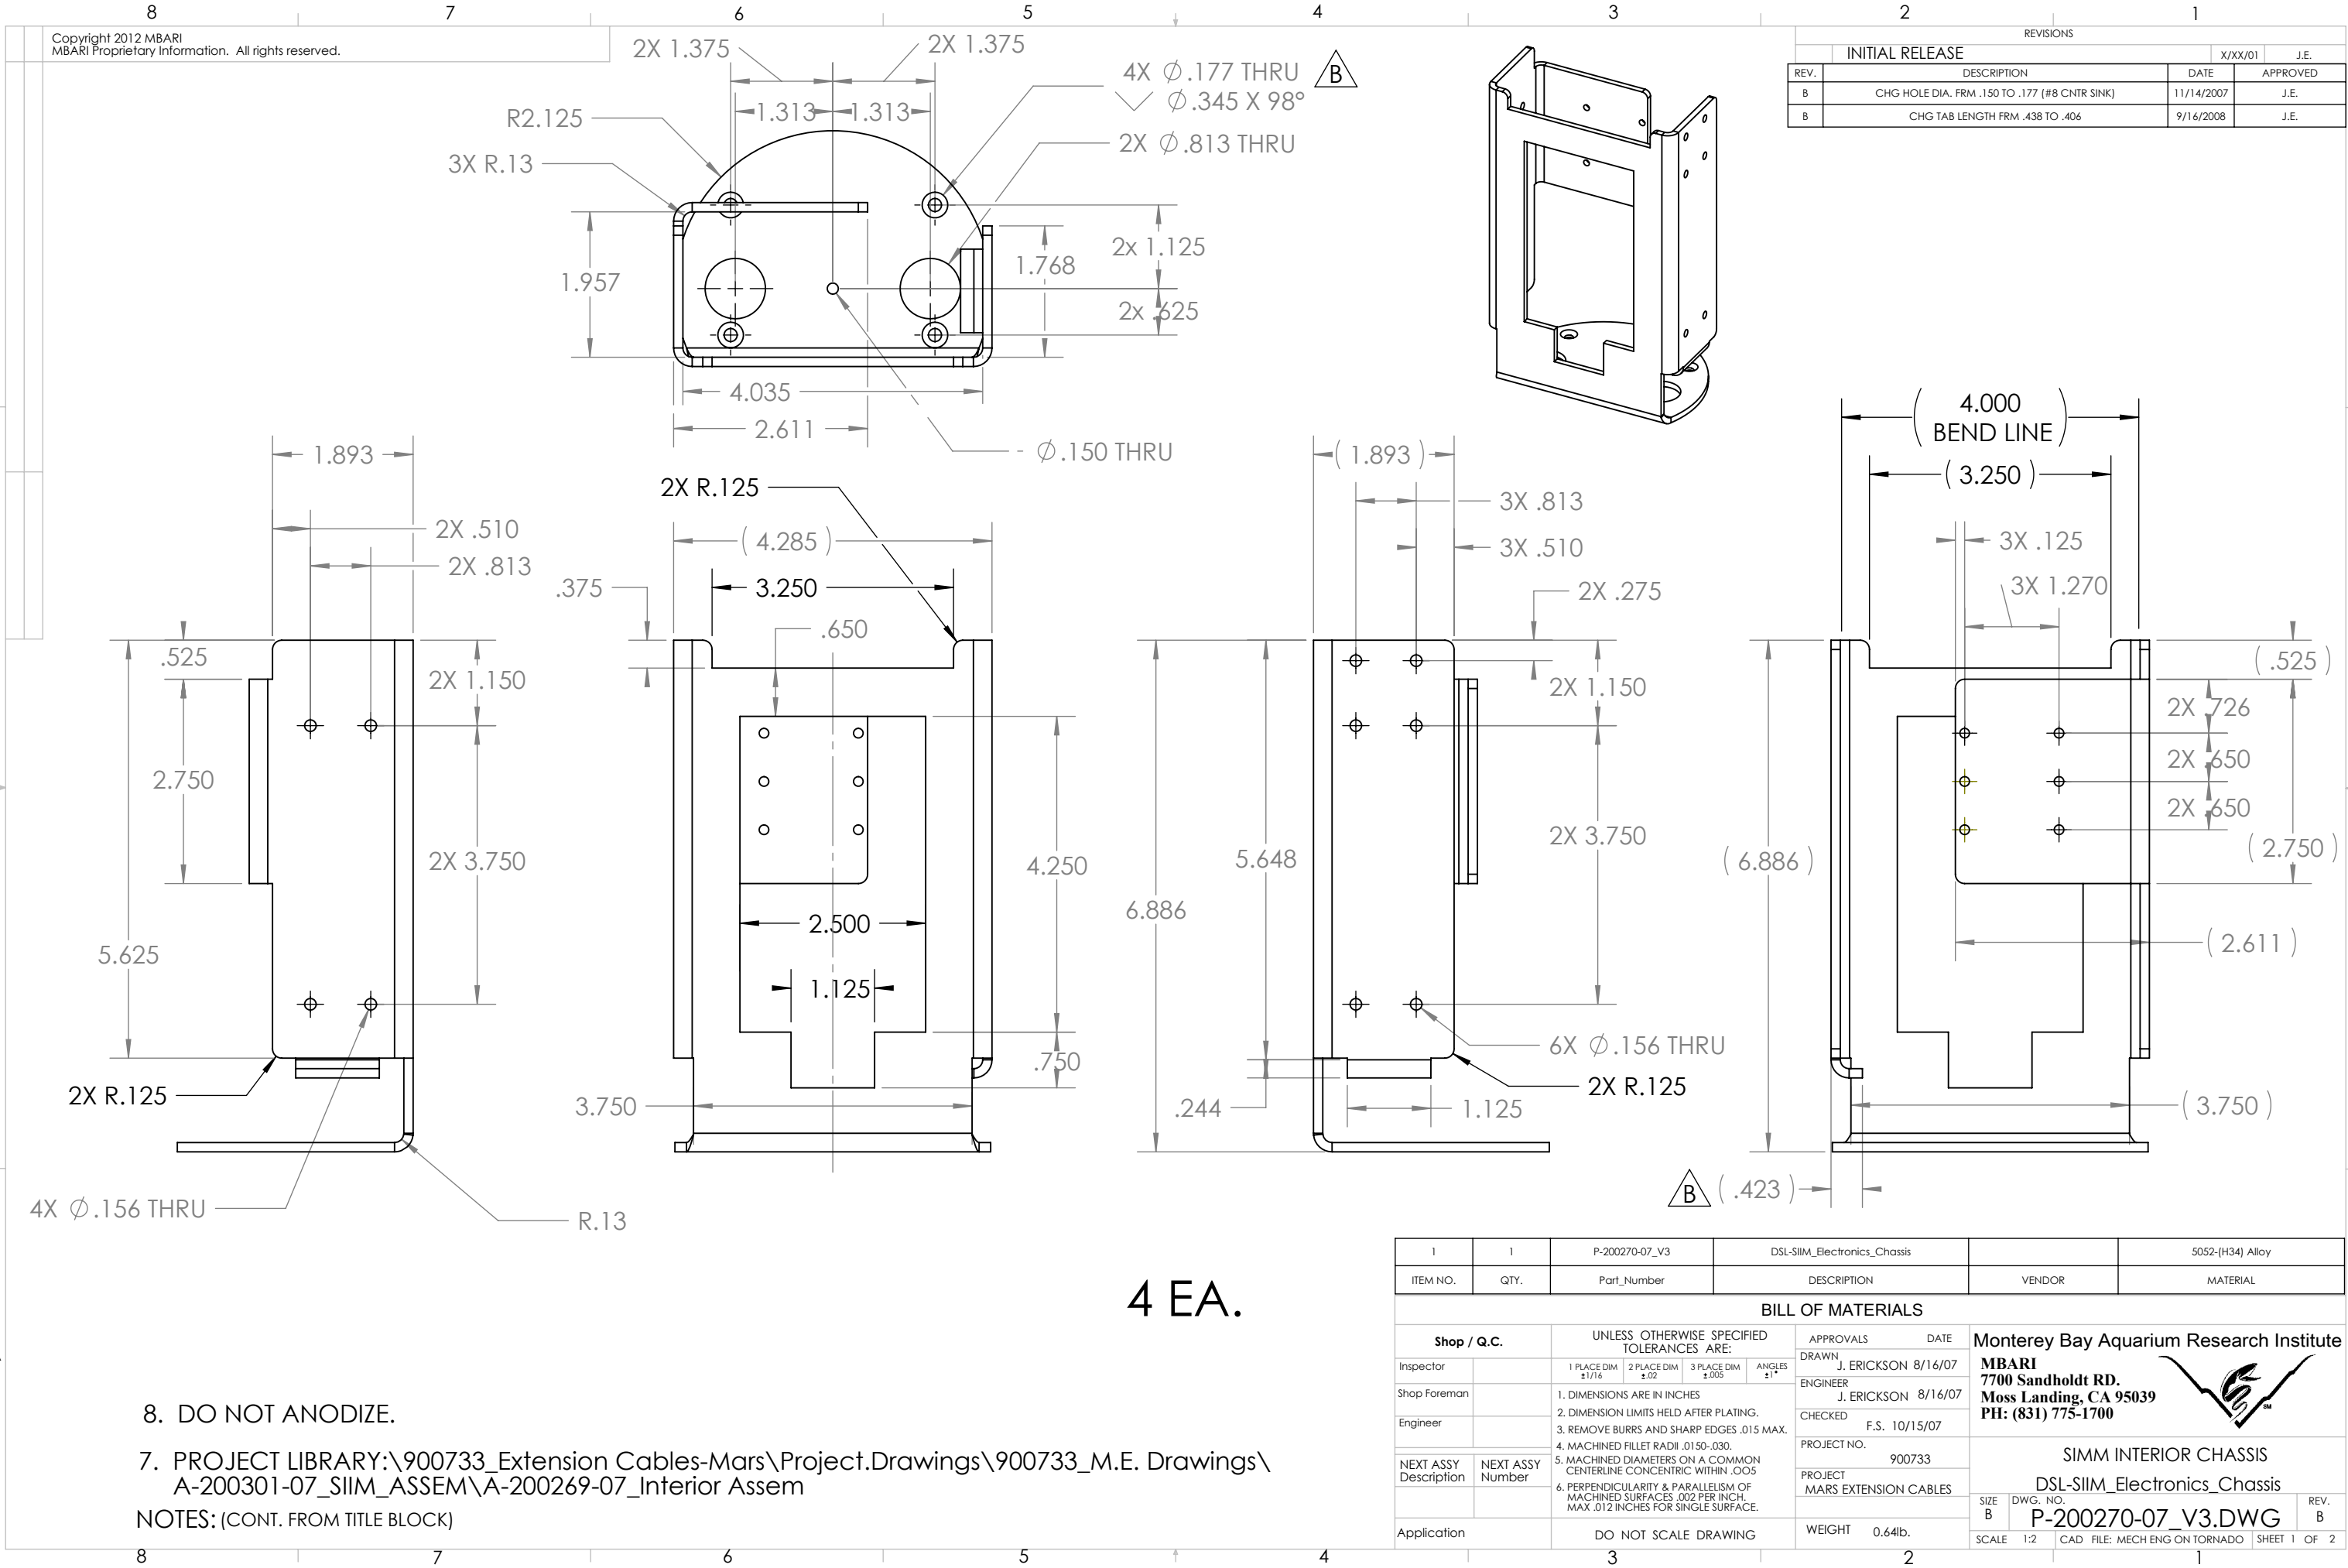

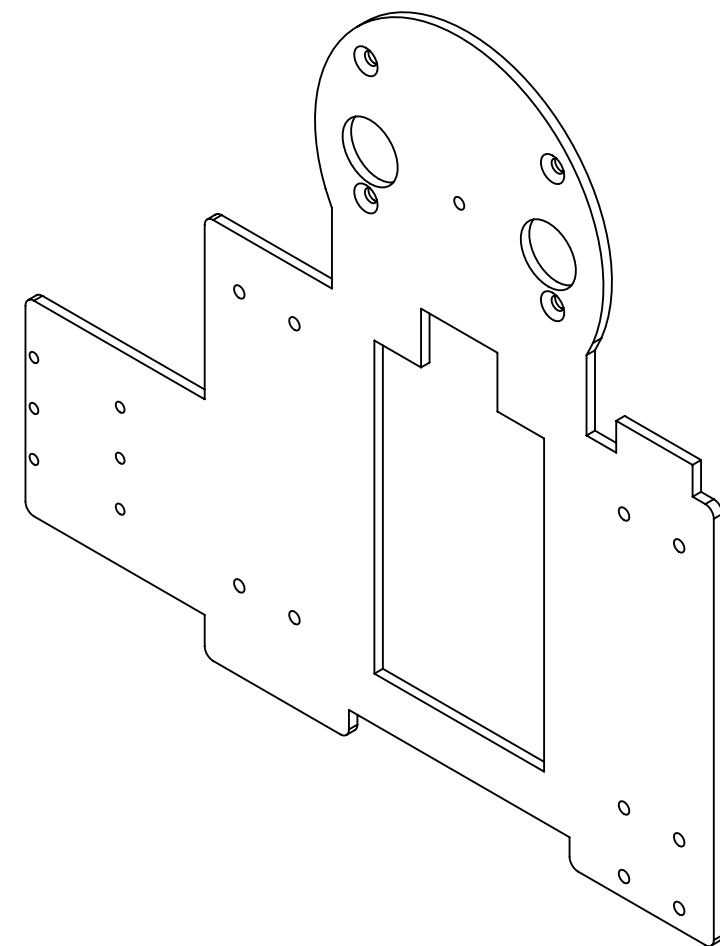

1	1	P-200270-07_V3	DSL-SIIM_Electronics_Chassis		P-200270-07_V3	5052-(H34) Alloy
ITEM NO.	QTY.	Part_Number	DESCRIPTION		VENDOR	MATERIAL

BILL OF MATERIALS						
Shop / Q.C.		UNLESS OTHERWISE SPECIFIED TOLERANCES ARE:			APPROVALS	DATE
Inspector		1 PLACE DIM ±1/16	2 PLACE DIM ±.02	3 PLACE DIM ±.005	ANGLES ±1°	DRAWN J. ERICKSON 8/16/07
Shop Foreman		1. DIMENSIONS ARE IN INCHES 2. DIMENSION LIMITS HELD AFTER PLATING. 3. REMOVE BURRS AND SHARP EDGES .015 MAX. 4. MACHINED FILLET RADII .0150-.030. 5. MACHINED DIAMETERS ON A COMMON CENTERLINE CONCENTRIC WITHIN .005 6. PERPENDICULARITY & PARALLELISM OF MACHINED SURFACES .002 PER INCH. MAX .012 INCHES FOR SINGLE SURFACE.				ENGINEER J. ERICKSON 8/16/07
Engineer						CHECKED F.S. 10/15/07
NEXT ASSY Description	NEXT ASSY Number					PROJECT NO. 900733
						PROJECT MARS EXTENSION CABLES
Application		DO NOT SCALE DRAWING			WEIGHT	

Monterey Bay Aquarium Research Institute MBARI 7700 Sandholdt RD. Moss Landing, CA 95039 PH: (831) 775-1700				
SIMM INTERIOR CHASSIS DSL-SIIM_Electronics_Chassis				
SCALE 1:2 CAD FILE: MECH ENG ON TORNADO SHEET 2 OF 2				