





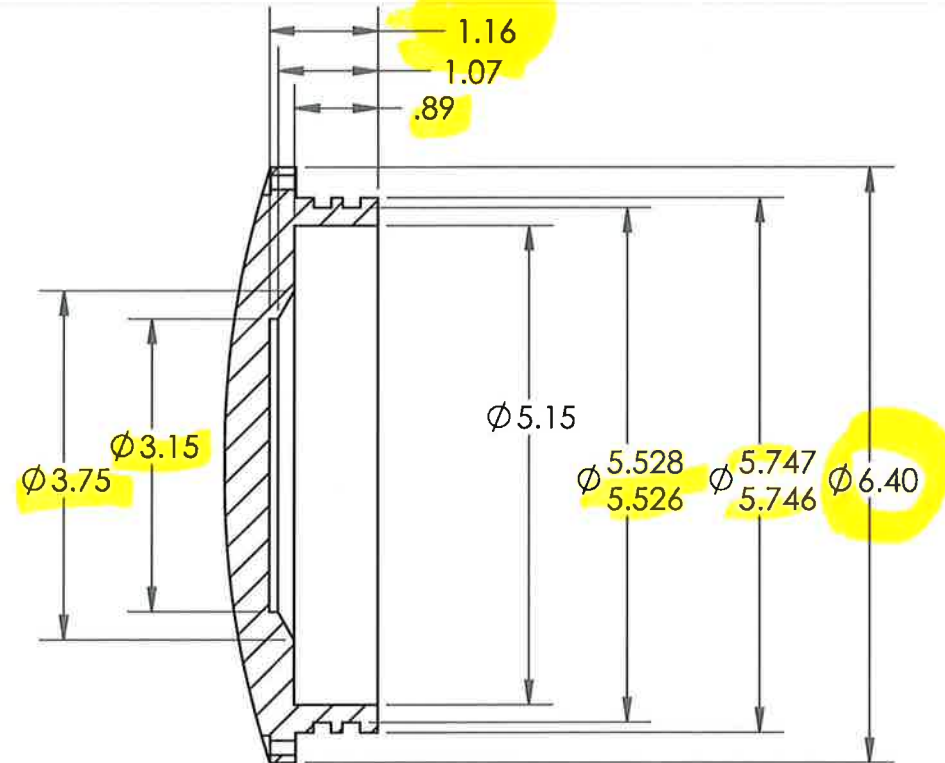


SECTION A-A
SCALE 1:2

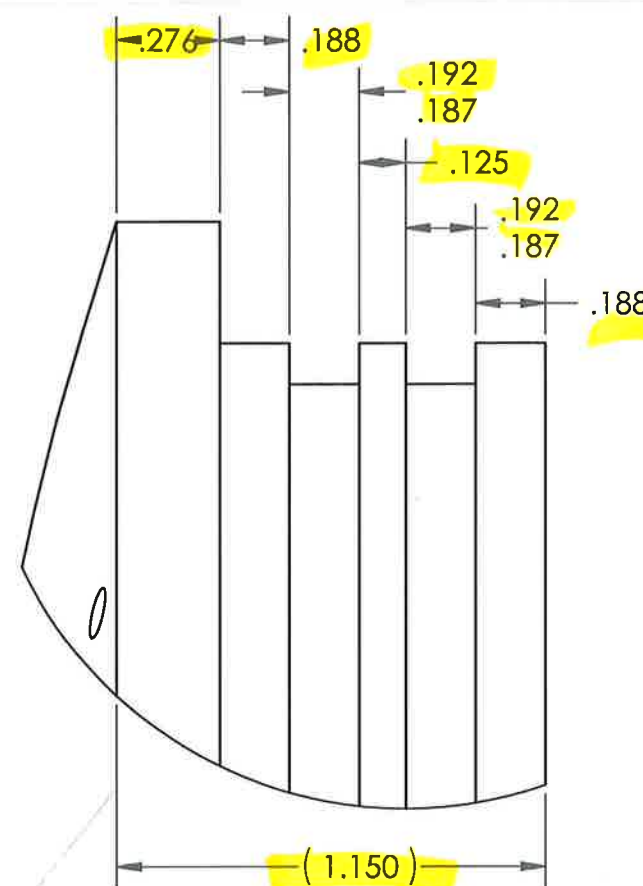

DETAIL B
SCALE 2:1

$$\begin{array}{r} 1.150 \\ - .276 \\ \hline .874 \end{array}$$

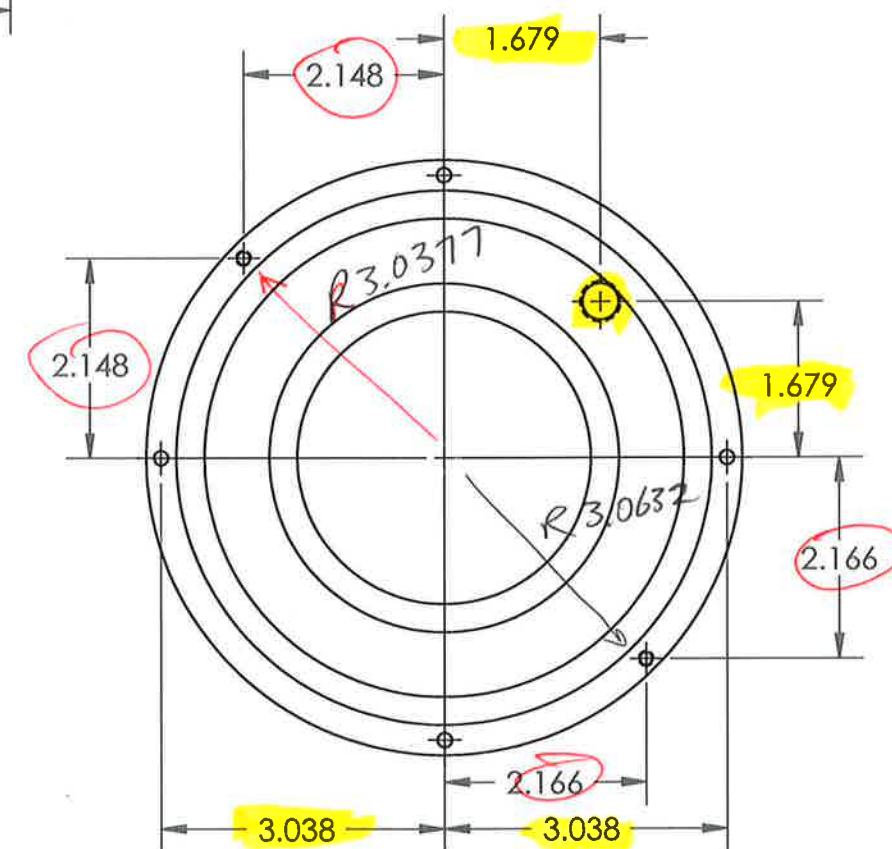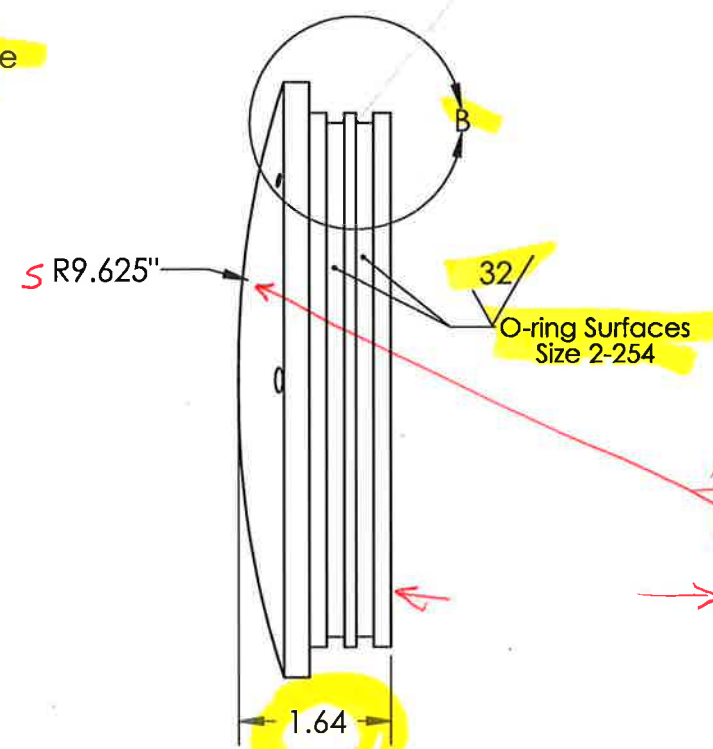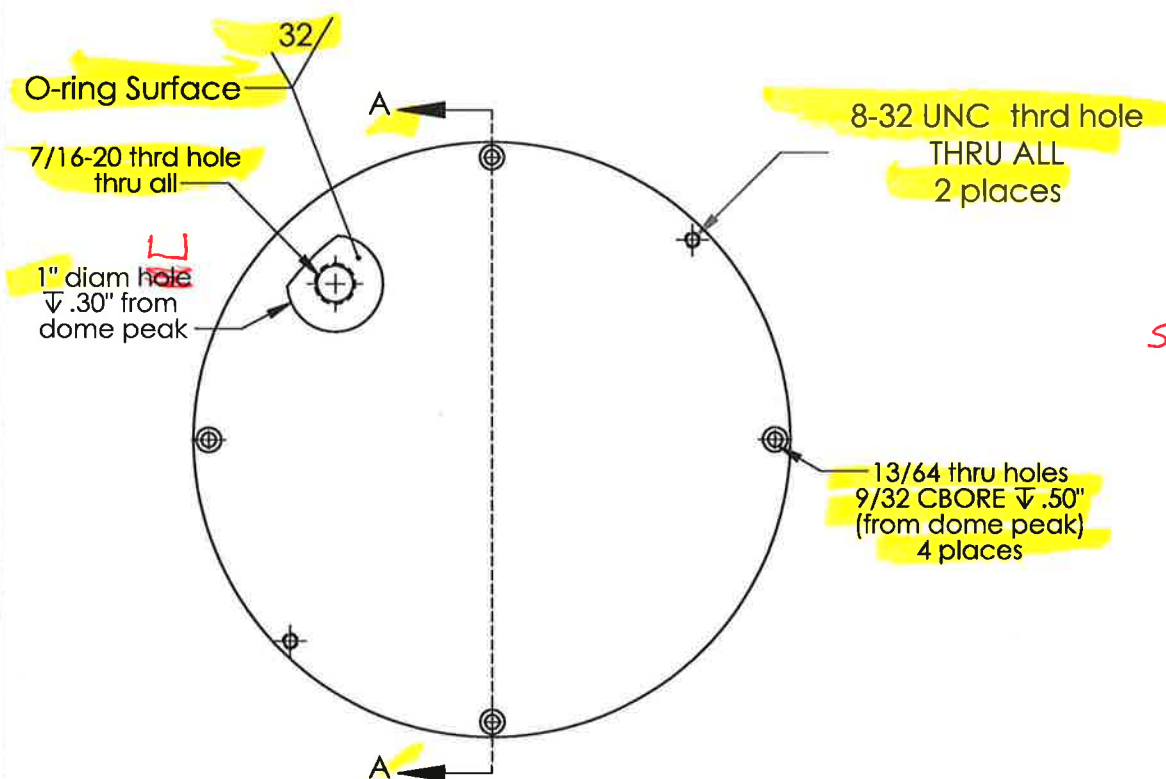

COMMENTS:

Naval Postgraduate School
Dept. of Oceanography

SIZE

TITLE: Connector End Cap for Tethys Flux Package

REV

D

NAME

DATE

Brian B Baumgartner, ed. Mahsima Rostami

02/23/11

SCALE: 1:2

WEIGHT:

SHEET 1 of 1

MATERIAL

QUANTITY

FINISH


DRAWN

APPR.


Ti CP Grade 2

1




Light Toolmarks acceptable unless otherwise indicated

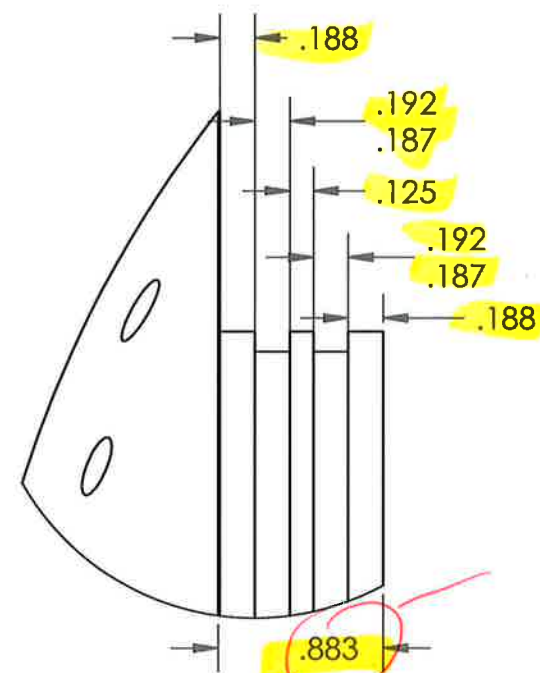

DETAIL B
SCALE 1:1

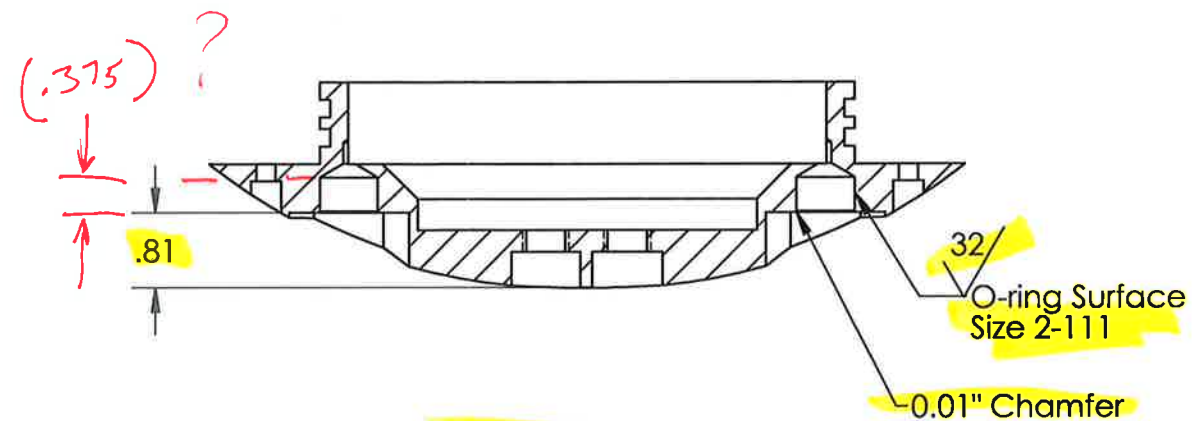

SECTION C-C

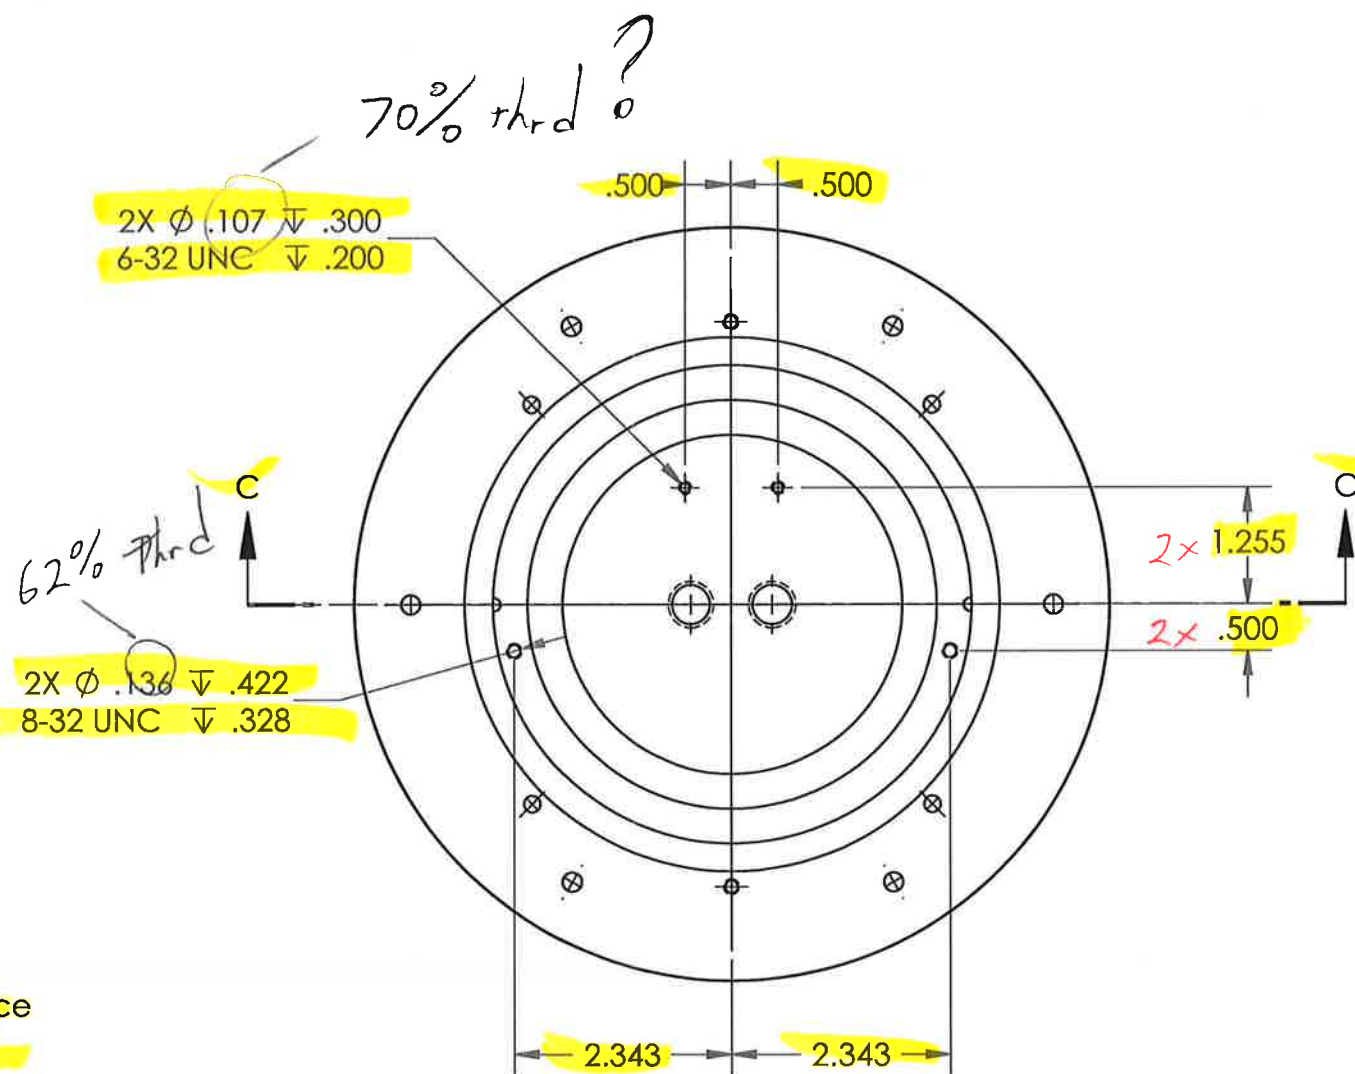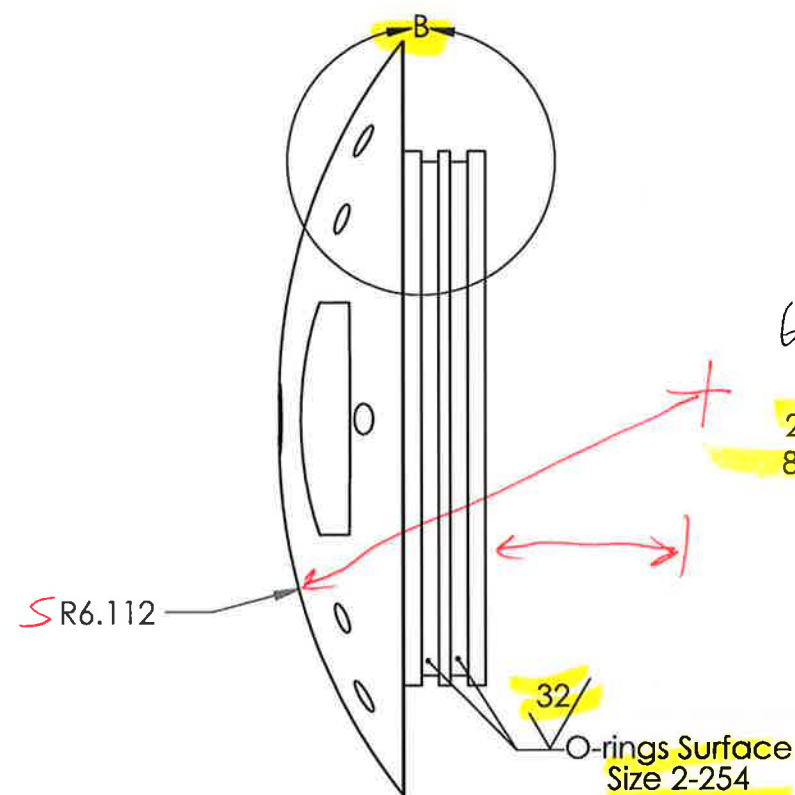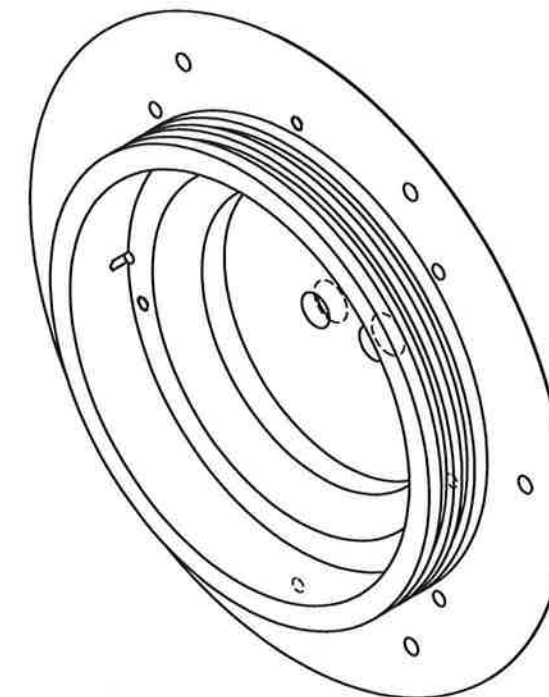

COMMENTS:

Naval Postgraduate School
Dept. of Oceanography

SIZE

TITLE:

Sensor End Cap for Tethys Flux
Package

REV

E

MATERIAL

Ti CP Grade 2

QUANTITY

1

FINISH

DRAWN

APPR.

NAME

Mahsima Rostami

DATE

02/24/11

B

SCALE: 1:2

WEIGHT:

SHEET 2 of 2